


N

SCALE=1"=20'
X=CROSS IN CONC.

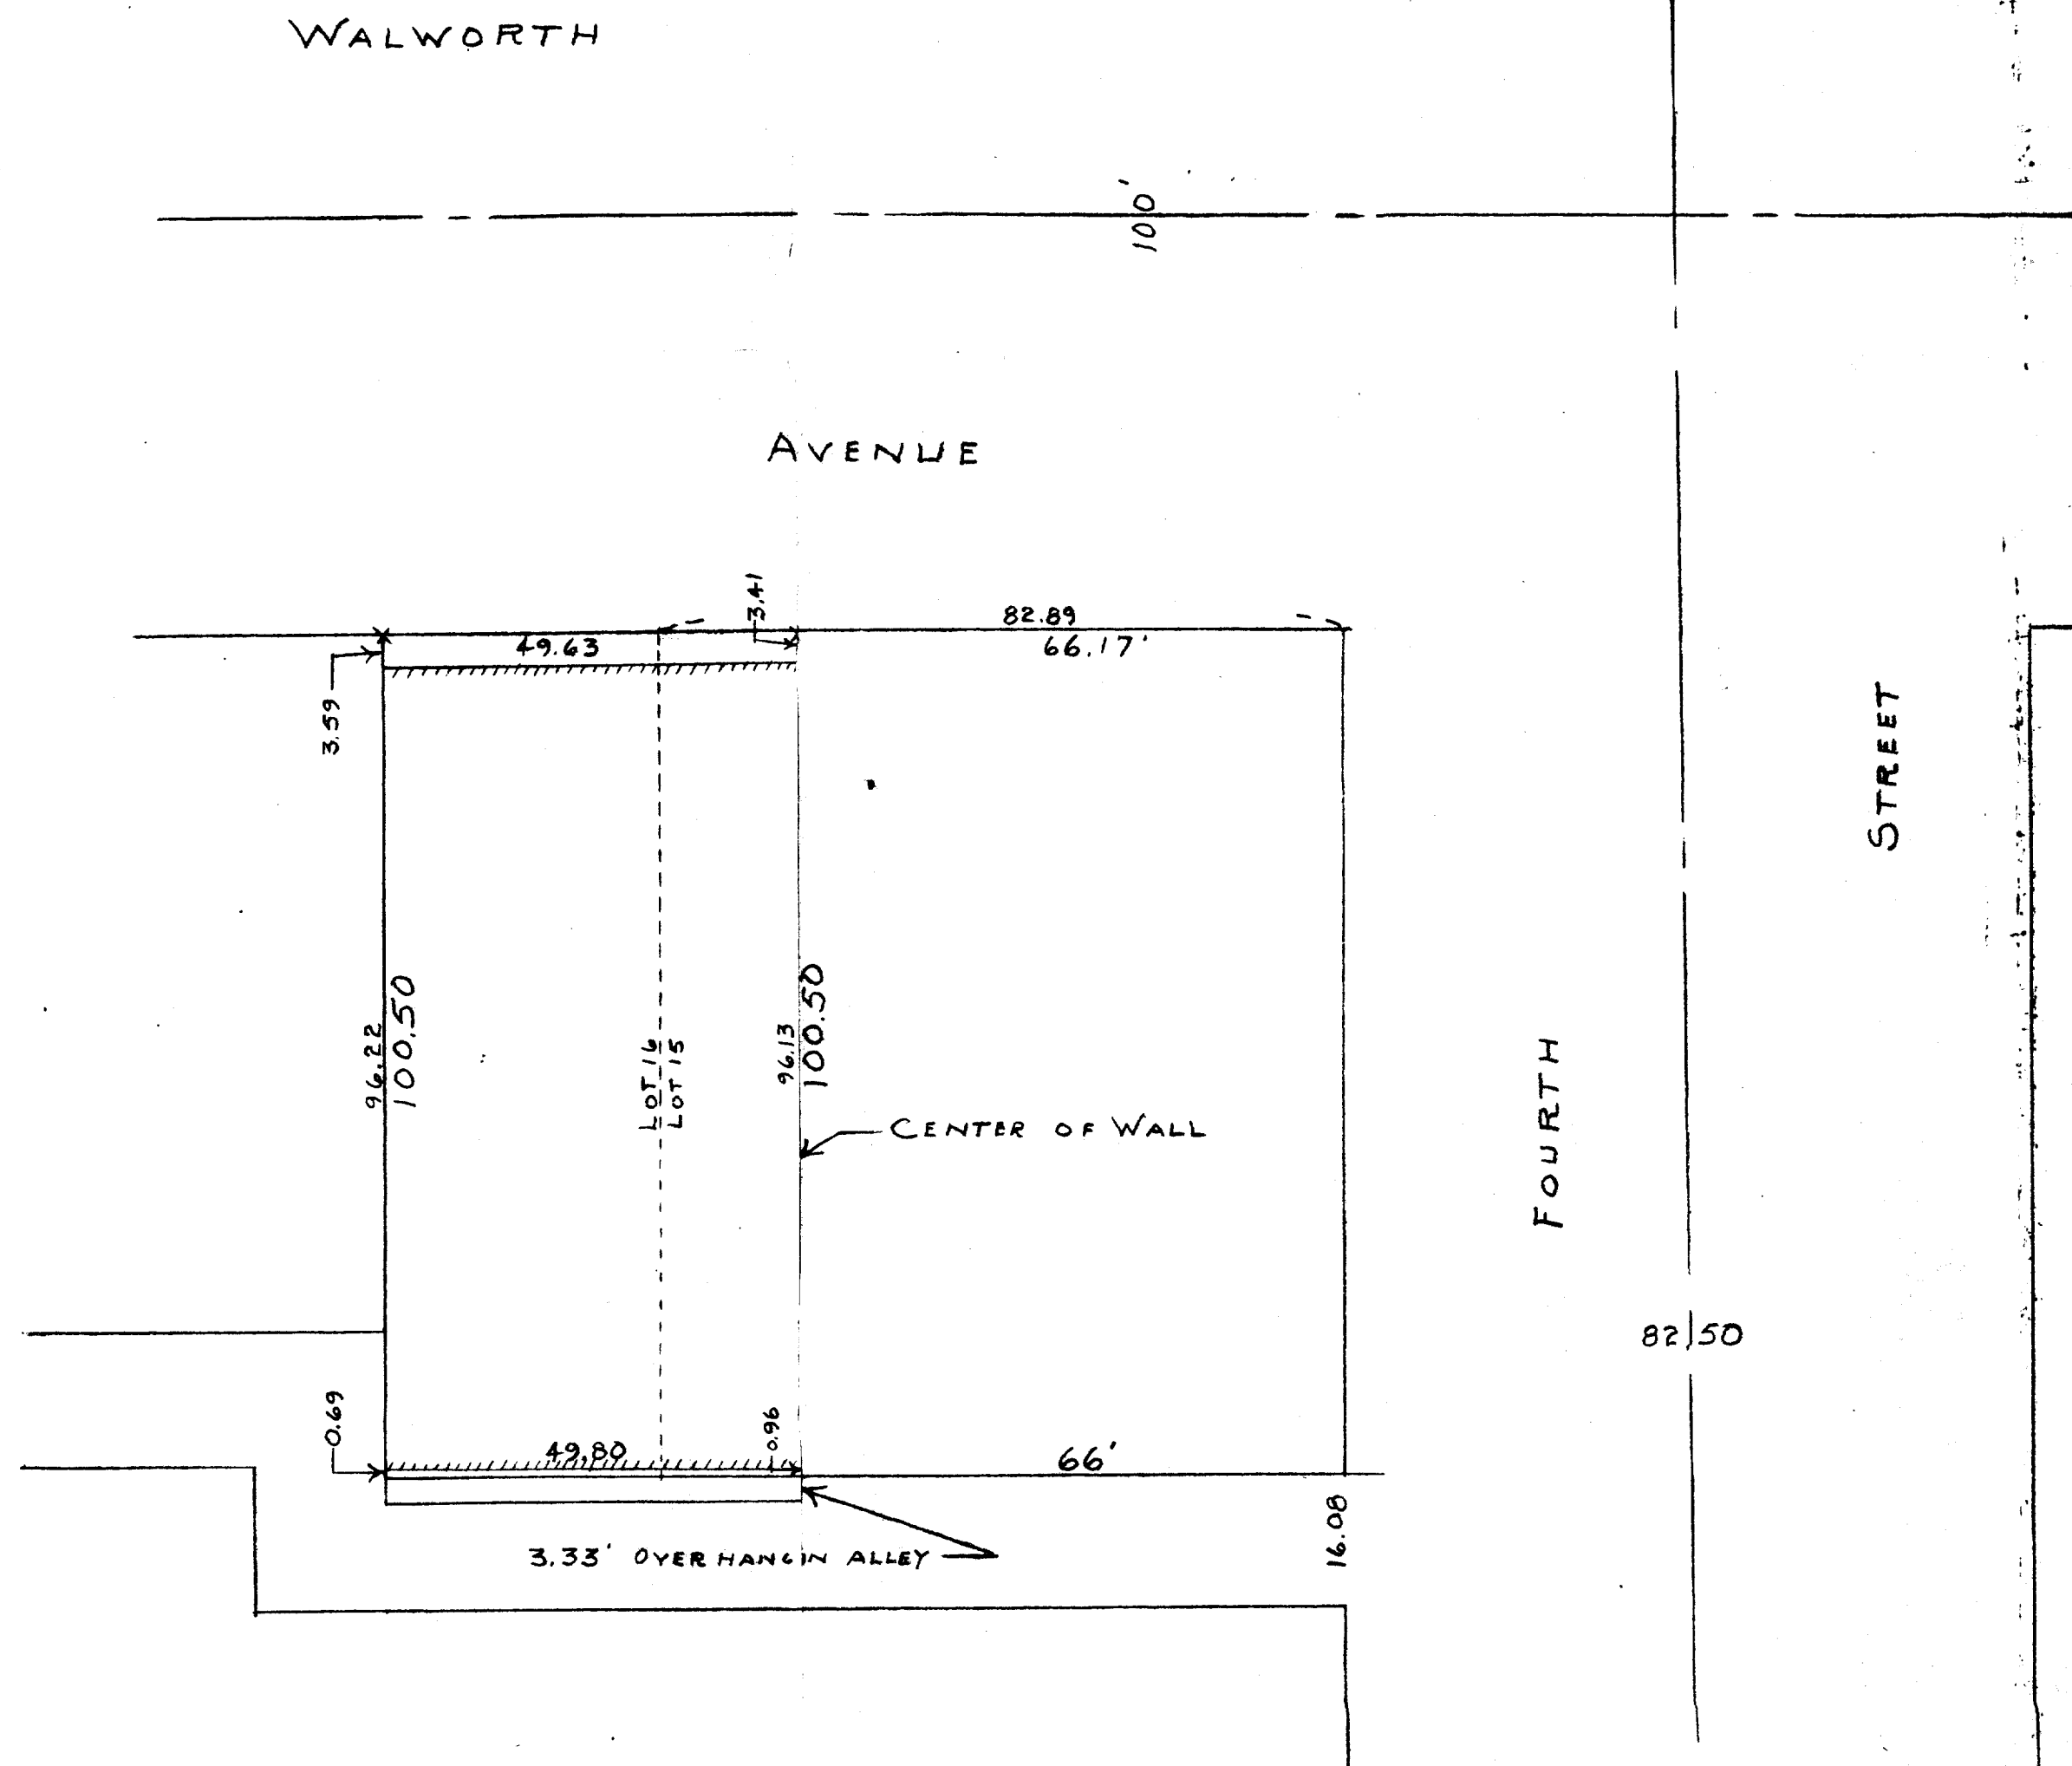

PLAT OF SURVEY OF PART OF LOTS 15 AND 16, BLOCK 11 OF ANN PHOENIX
ADDITION, CITY OF DELAVAN, WALWORTH COUNTY, WISCONSIN
FEB. 7, 1957

George T. Dunham
GEORGE T. DUNHAM, SURVEYOR
DELAVAN, WISCONSIN

2-80