
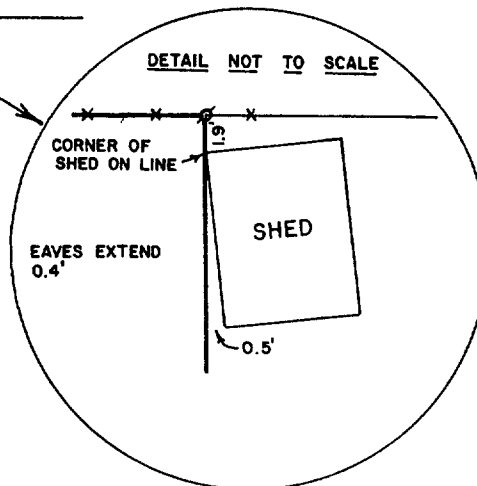
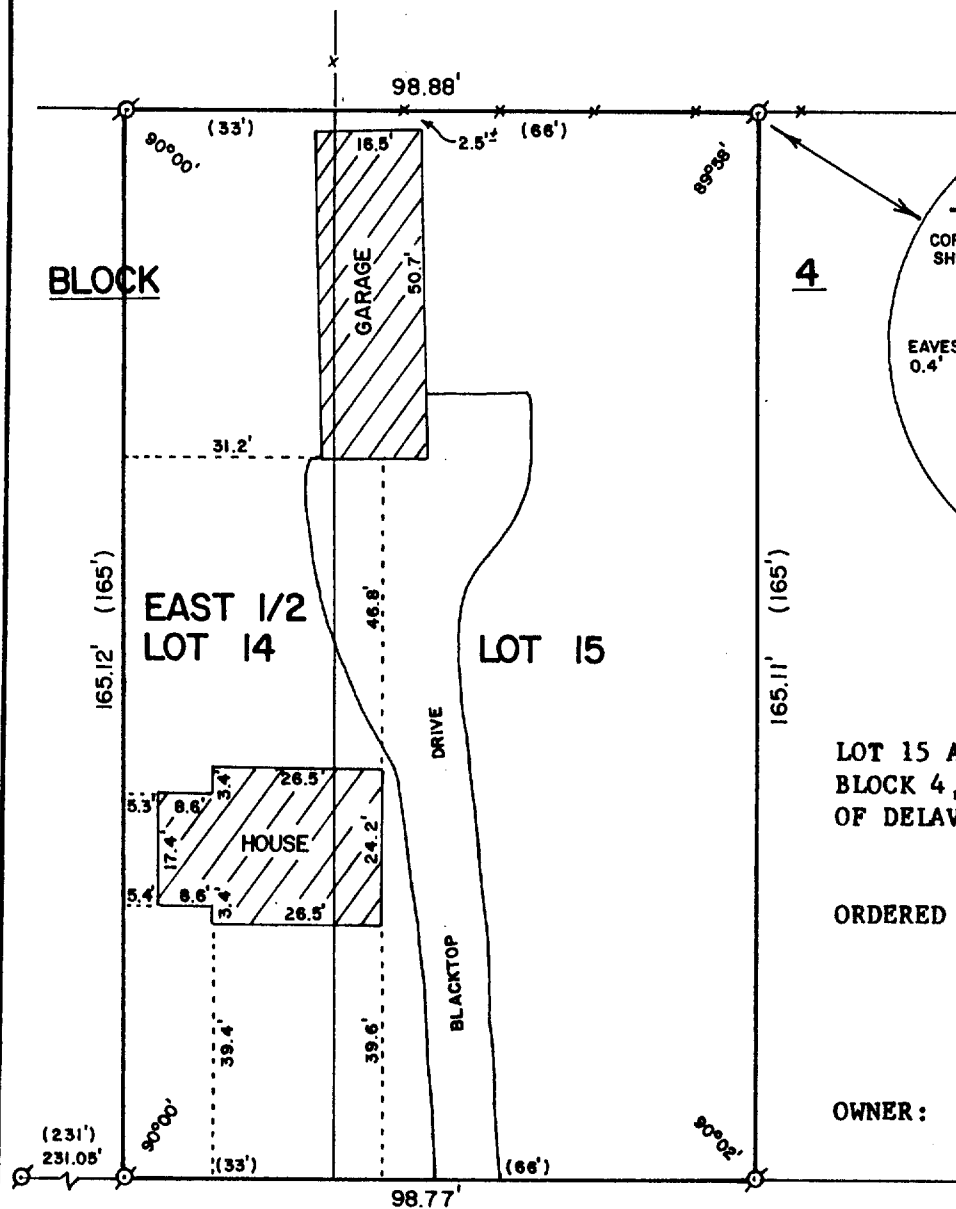


ABELL
SURVEYING & MAPPING
 DELAVAN, WISCONSIN 53115
 414-728-6737

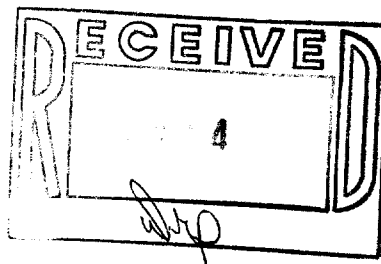

PLAT OF SURVEY OF

LOT 15 AND THE EAST 1/2 OF LOT 14,
 BLOCK 4, ELMHURST ADDITION, CITY
 OF DELAVAN, WALWORTH COUNTY, WI.

ORDERED BY: REALTY WORLD - CARMIN
 REALTORS
 811 E. GENEVA ST.
 DELAVAN, WI. 53115

OWNER: JAMES GOLLADAY

SCALE - 1"=30'

LEGEND

- ⊙ - IRON PIPE FOUND
- () - RECORDED AS
- x— - FENCE

I, DAVID F. ABELL, DO HEREBY CERTIFY
 THAT I HAVE SURVEYED THE PROPERTY
 HEREON DESCRIBED ACCORDING TO THE
 OFFICIAL RECORDS AND THAT THE PLAT
 HEREON IS A CORRECT REPRESENTATION
 OF THE PROPERTY LINES TO THE BEST OF
 MY KNOWLEDGE AND BELIEF.

David F. Abell

DAVID F. ABELL
 WISCONSIN REGISTERED LAND SURVEYOR, S-1596

December 13, 1987

DATE JOB NUMBER - 87204

NOTE: THIS IS NOT A CERTIFIED COPY UNLESS SEALED.

X-254