



TEL. 414-723-2098

○ = IRON PIPE STAKE FOUND
 = IRON PIPE STAKE SET
 ⊙ = IRON ROD STAKE FOUND
 ⊕ = IRON ROD STAKE SET
 ● = CONCRETE MONUMENT FOUND
 x) = RECORD DIMENSION

MAP SCALE IN FEET

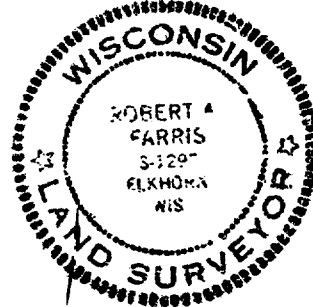

IRON PIPE FOUND IS
BENT WESTERLY. TOP
IS 0.4' WEST OF
LOT CORNER

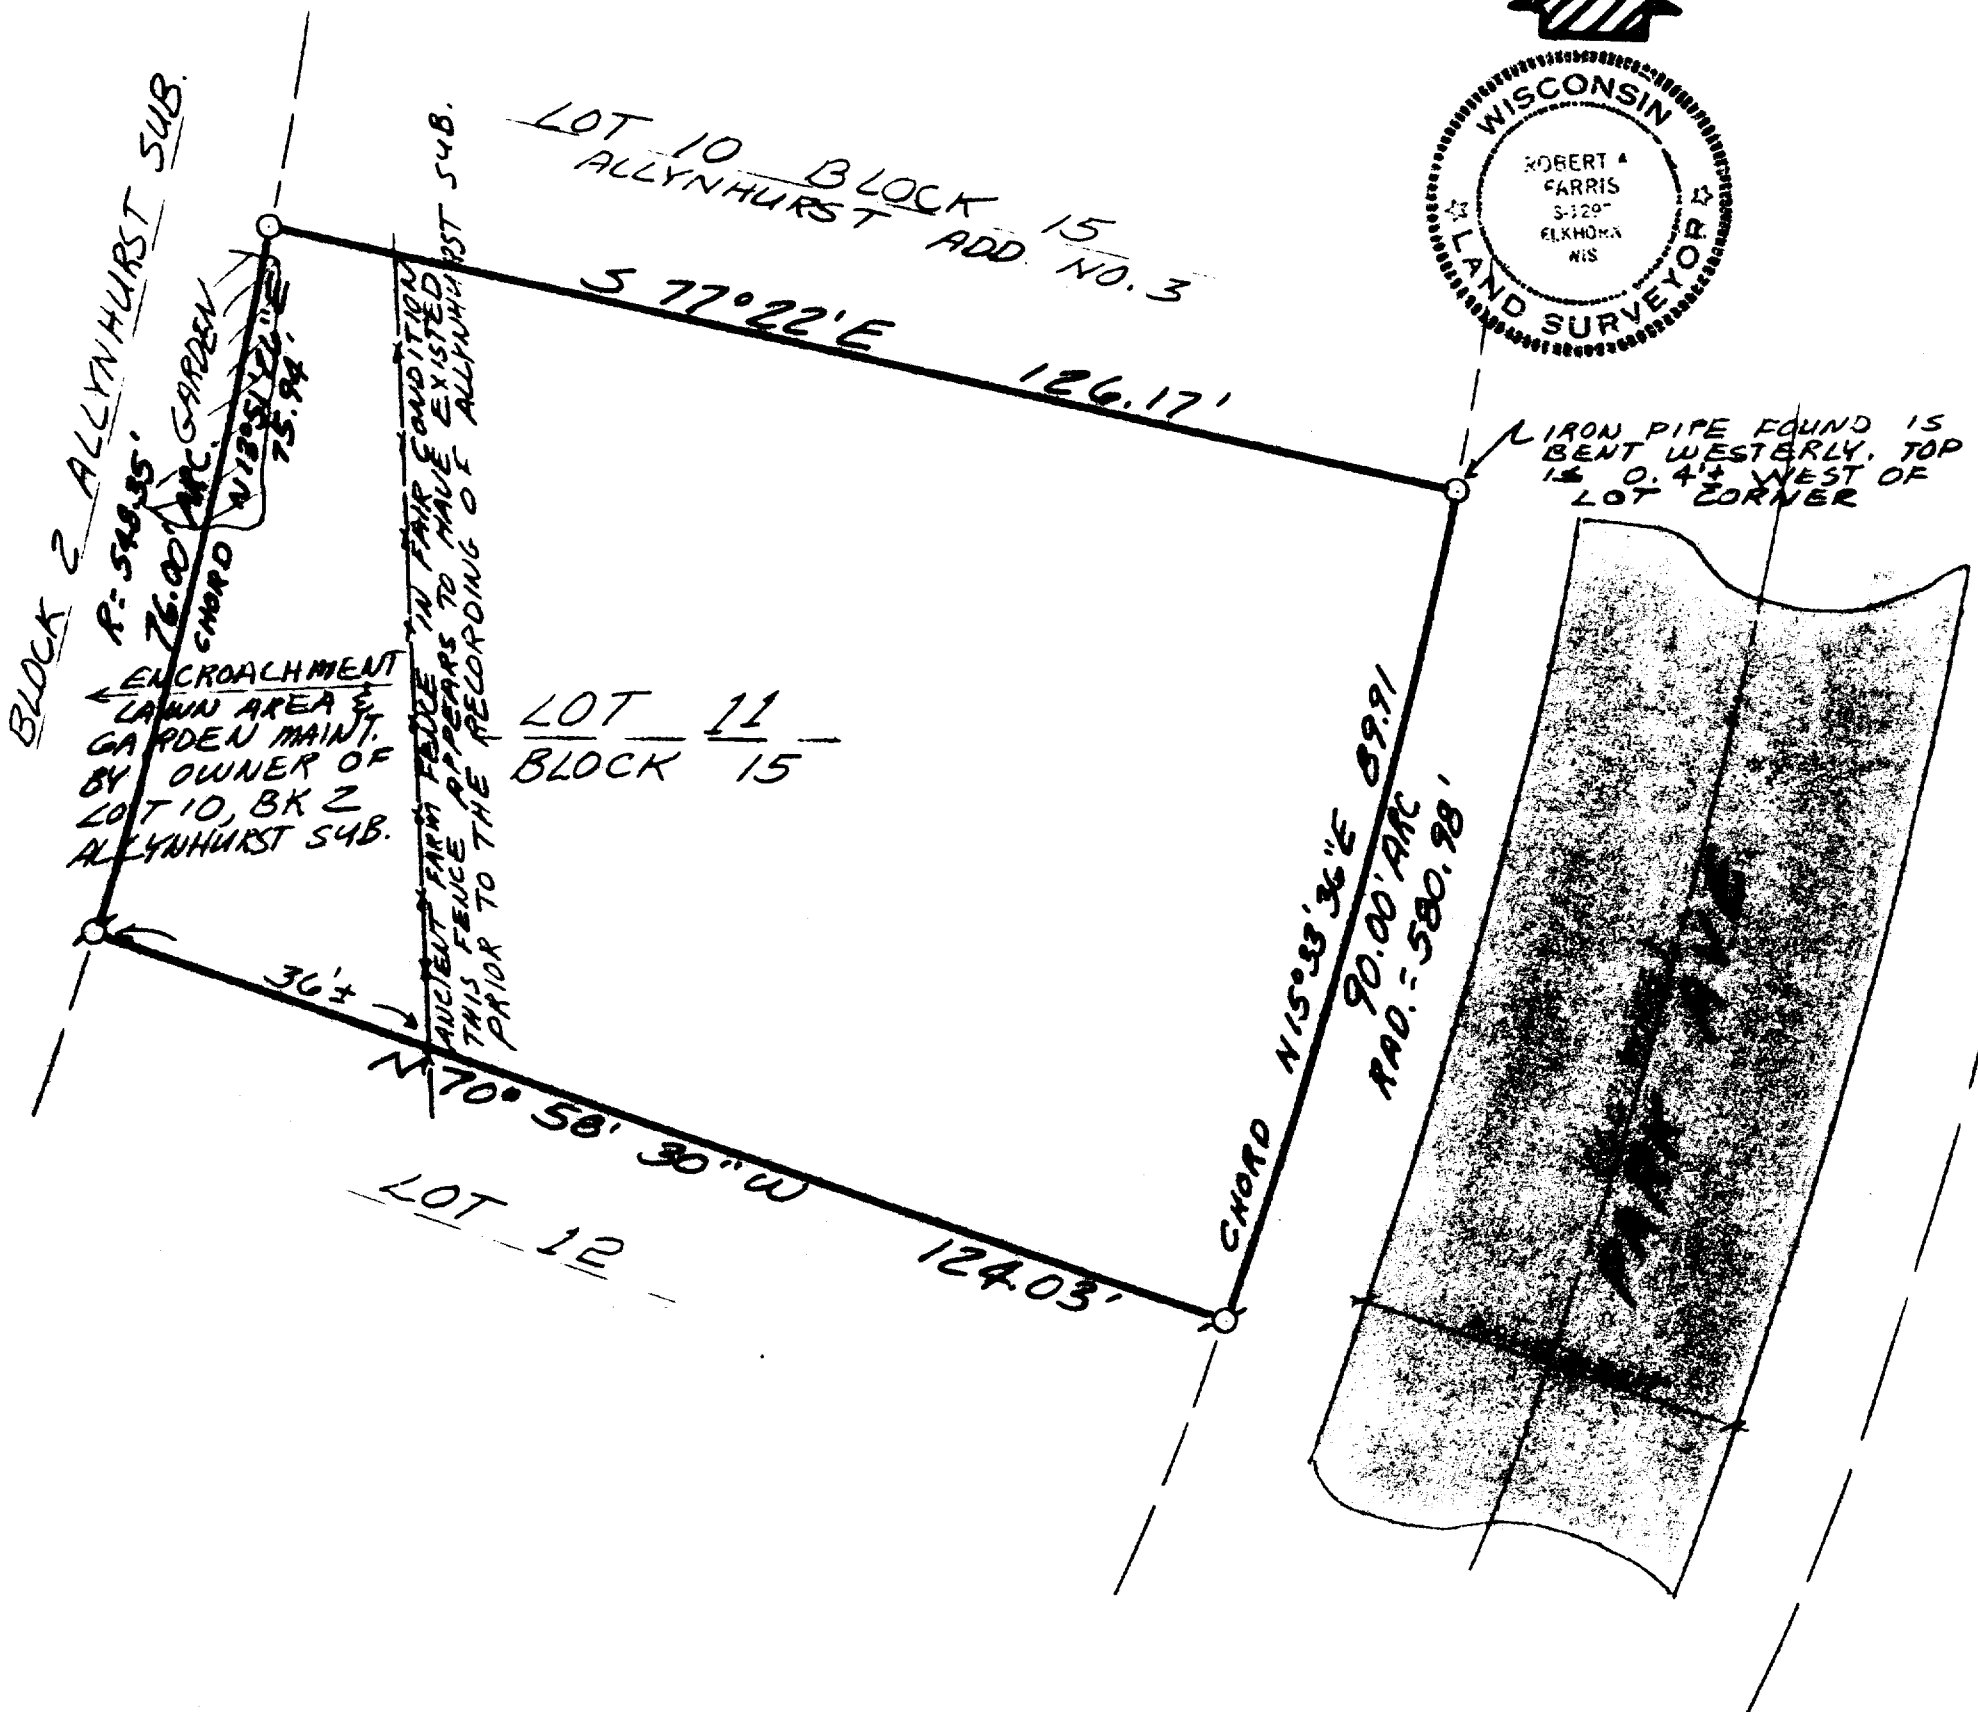

PROJ. 2933.B15.L11