


ABELL
SURVEYING & MAPPING
DELAVAL, WISCONSIN 53115
414-728-6737

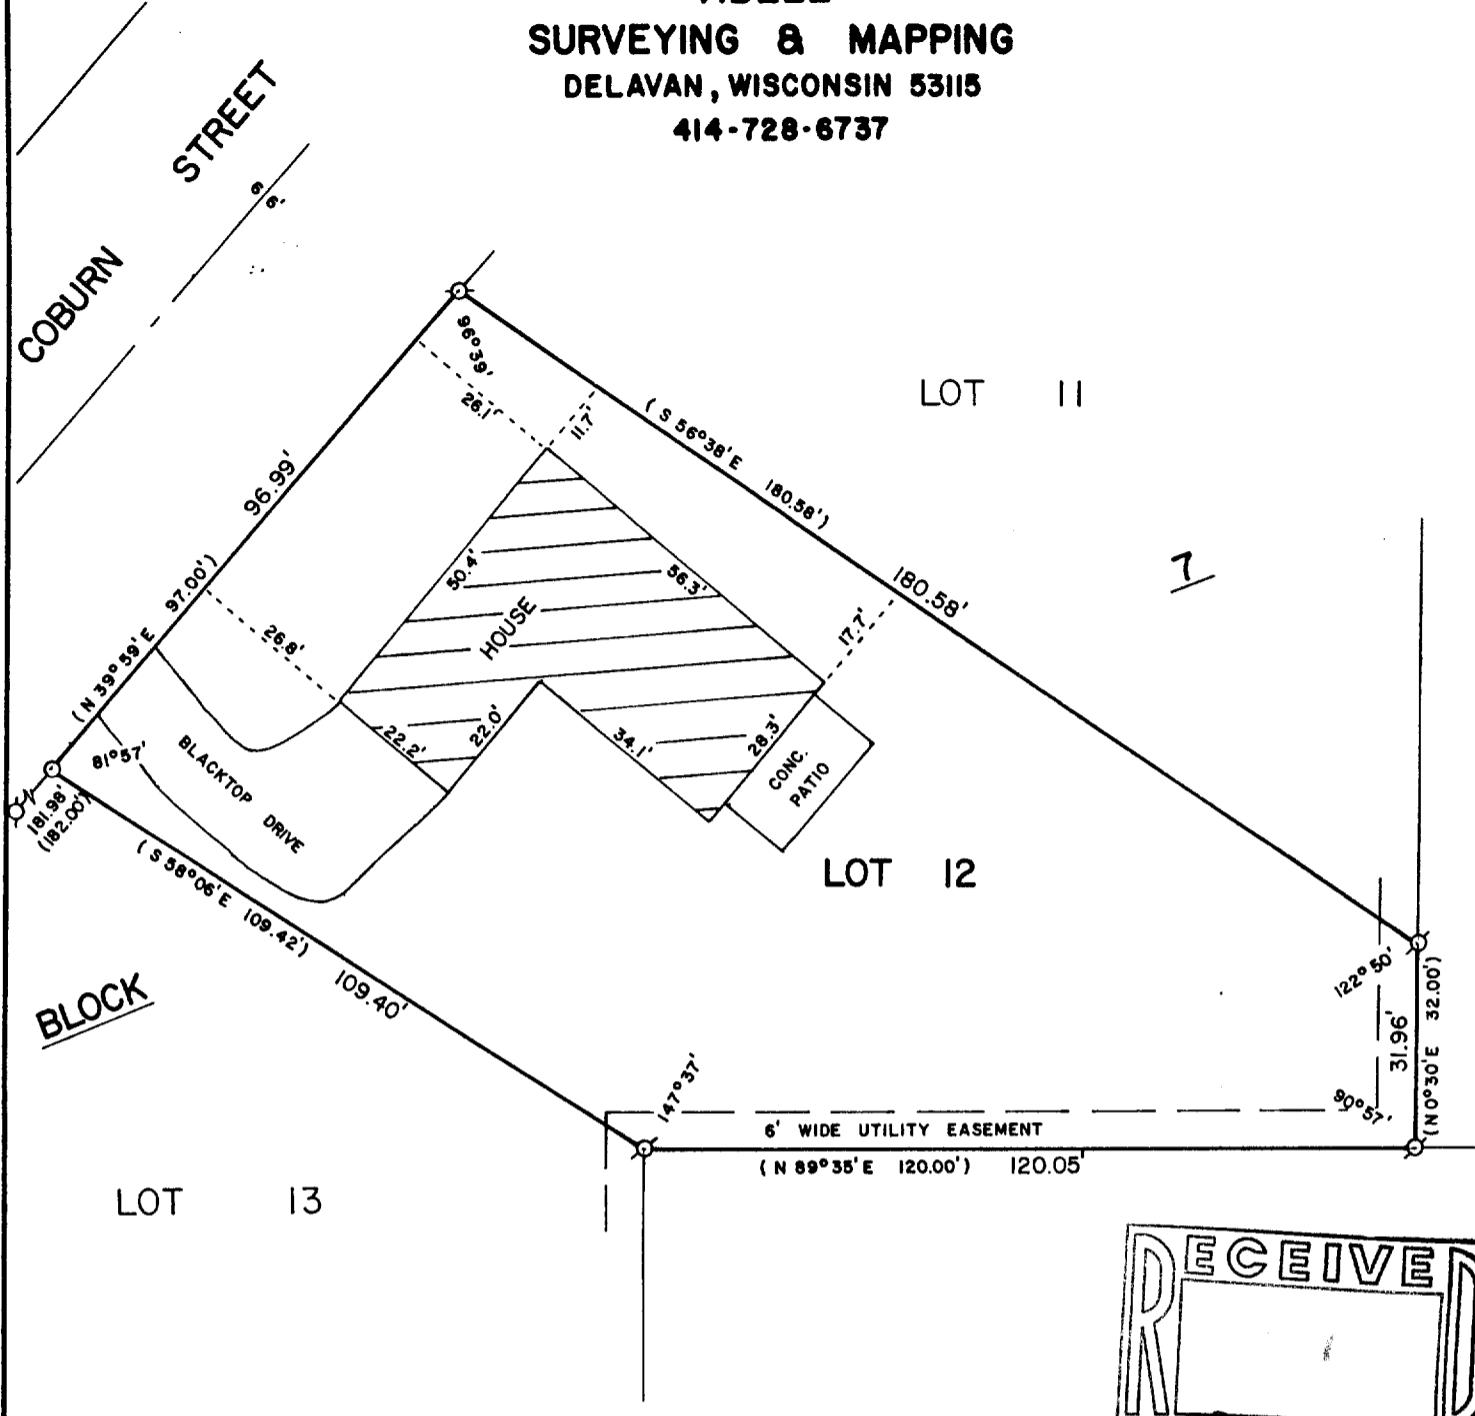

LOT 12, BLOCK 7, SPRINGS PARK SUBDIVISION
ADDITION NO. 2, LOCATED IN THE CITY OF
DELAVAL, WALWORTH COUNTY, WISCONSIN.

ORDERED BY: CENTURY 21 - SKANDIA REALTY
312 S. 7th ST.
DELAVAL, WI. 53115



SCALE - 1"=30'

LEGEND

- ♂ - IRON PIPE FOUND
- - IRON ROD SET
- () - RECORDED AS

I, DAVID F. ABELL, DO HEREBY CERTIFY
THAT I HAVE SURVEYED THE PROPERTY
HEREON DESCRIBED ACCORDING TO THE
OFFICIAL RECORDS AND THAT THE PLAT
HEREON IS A CORRECT REPRESENTATION
OF THE PROPERTY LINES TO THE BEST OF
MY KNOWLEDGE AND BELIEF.

David F. Abell

DAVID F. ABELL
WISCONSIN REGISTERED LAND SURVEYOR, S-1596

January 15, 1988
DATE JOB NUMBER - 88001
NOTE: THIS IS NOT A CERTIFIED COPY UNLESS SEALED.