


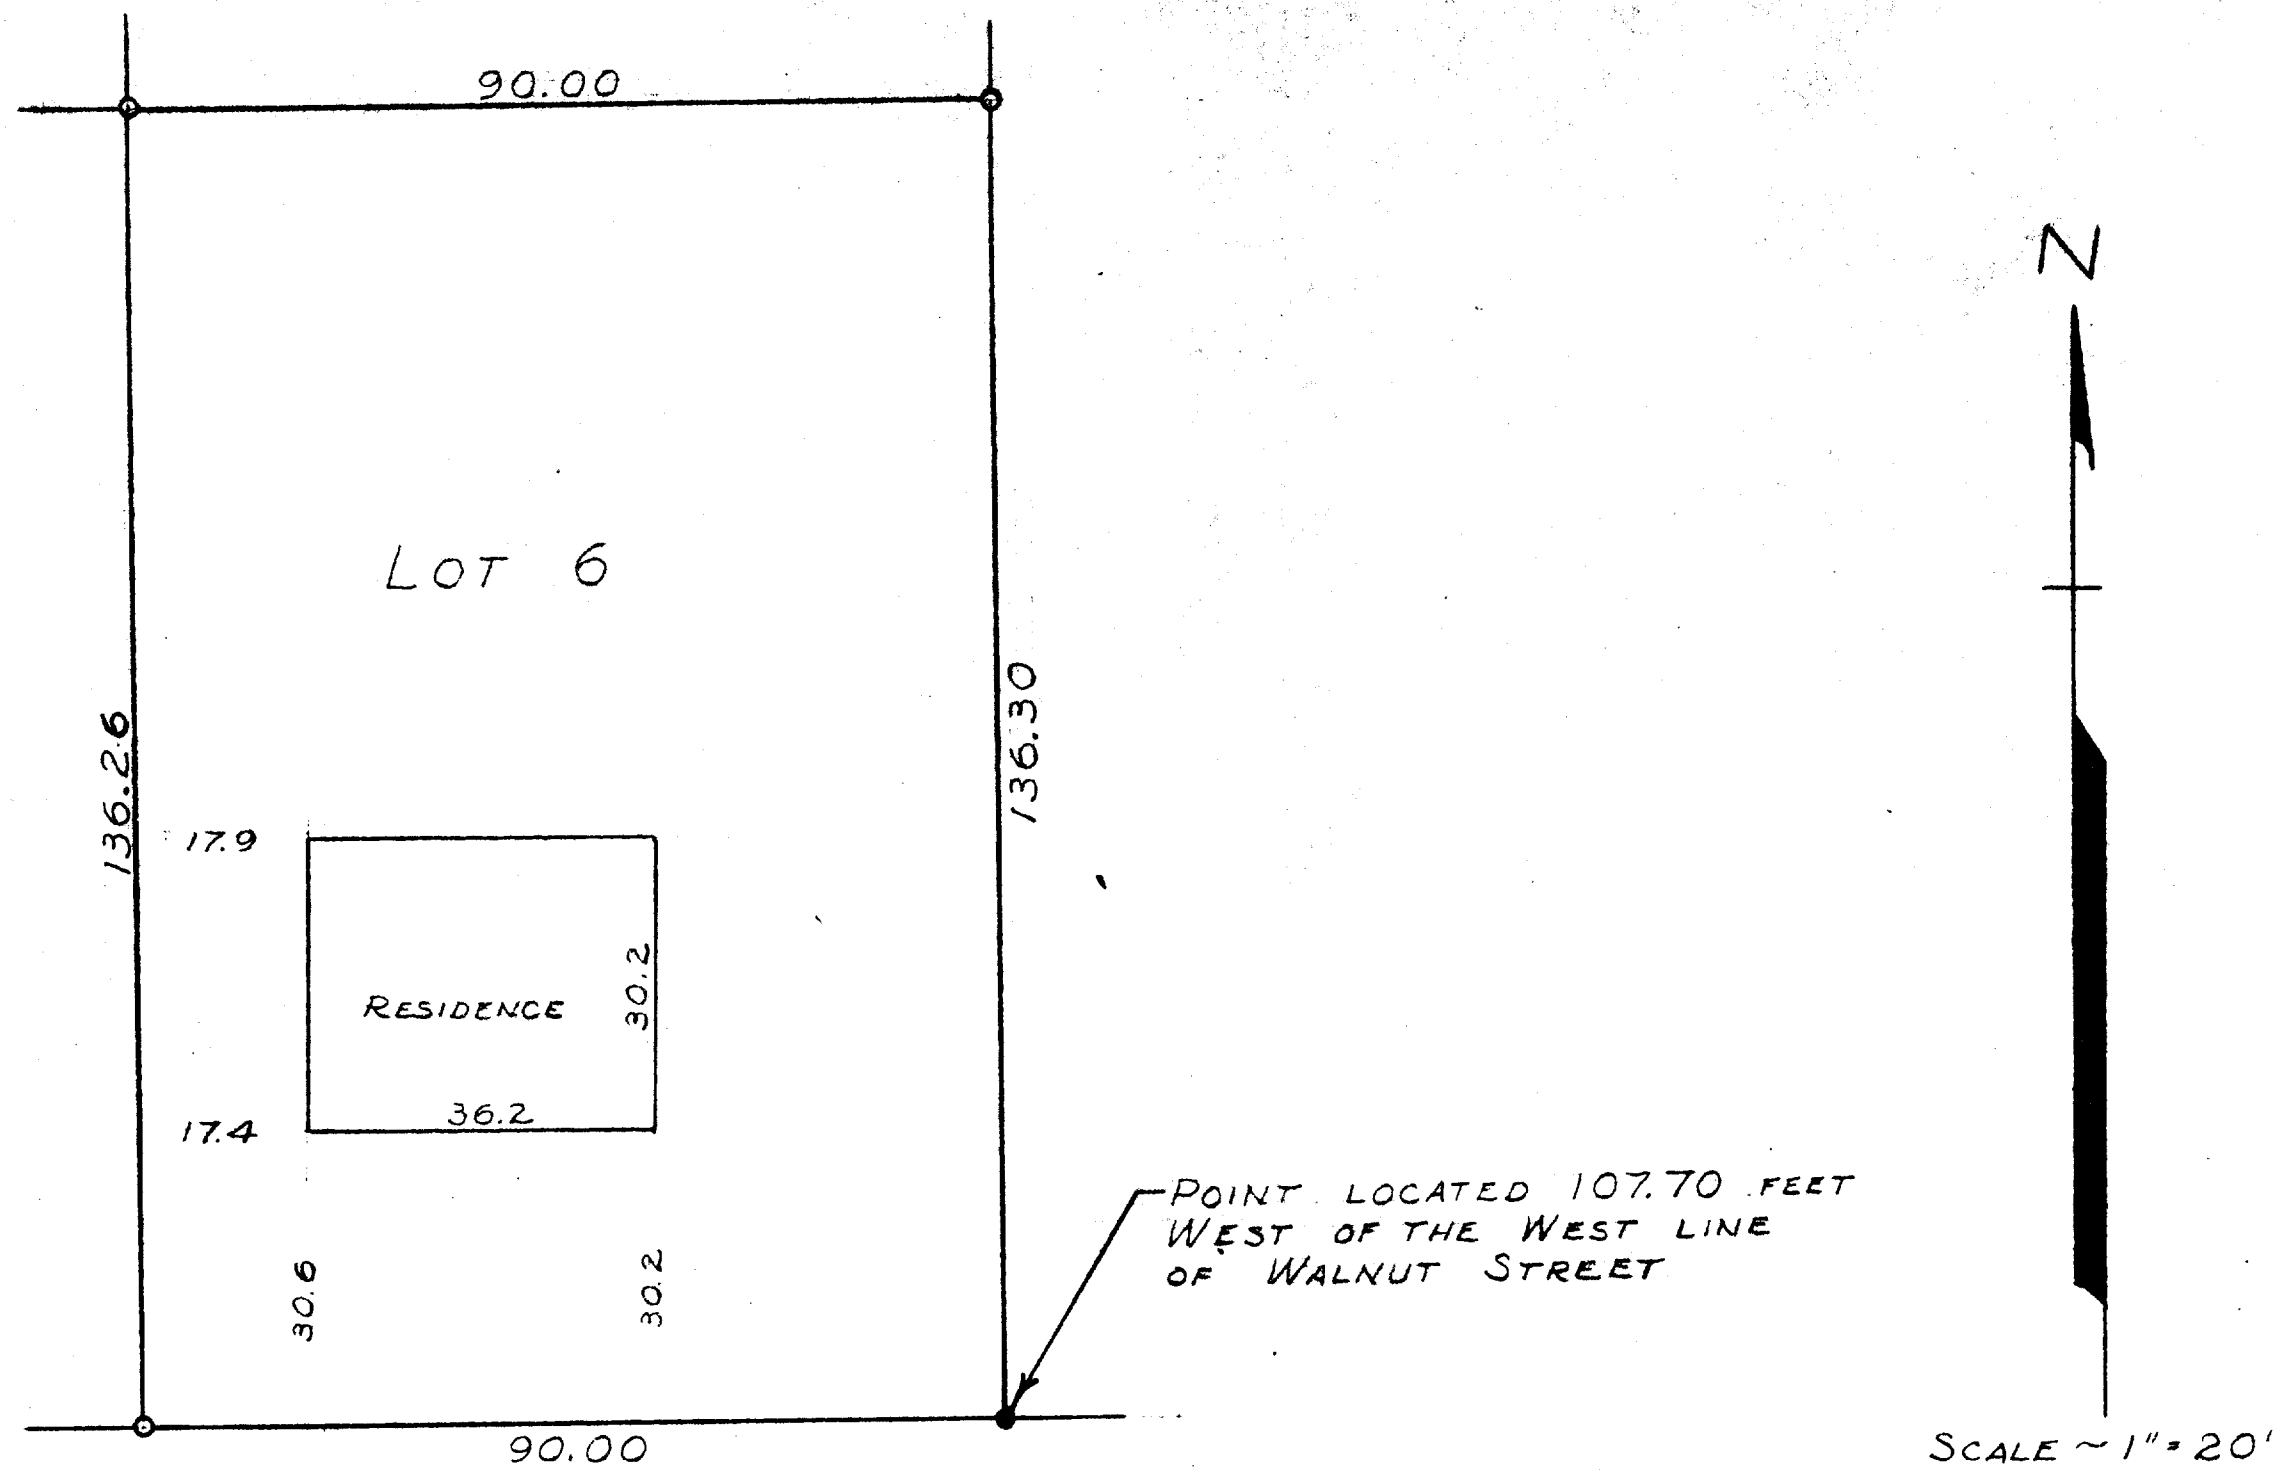

SCALE ~ 1" = 20'
 ● ~ CONC. MON.
 ○ ~ IRON PIPE

WASHINGTON

STREET

STATE OF WISCONSIN } S.S.
 COUNTY OF WALWORTH }

I, GEORGE T. DUNHAM, DO HEREBY CERTIFY THAT I HAVE SURVEYED THE PROPERTY DESCRIBED AS FOLLOWS:

A PARCEL OF LAND LOCATED IN THE SOUTHWEST 1/4 OF SECTION 18, T2NR16E, CITY OF DELAVAN, WALWORTH COUNTY, WISCONSIN, DESCRIBED AS FOLLOWS, TO-WIT: BEGINNING AT A POINT ON THE NORTH LINE OF WASHINGTON STREET, LOCATED 107.70 FEET WEST OF THE WEST LINE OF WALNUT STREET; THENCE NORTH PARALLEL TO THE WEST LINE OF WALNUT STREET 136.30 FEET; THENCE WEST 90.00 FEET TO A POINT LOCATED 136.26 FEET NORTH OF THE NORTH LINE OF WASHINGTON STREET; THENCE SOUTH PARALLEL TO THE WEST OF WALNUT STREET 136.26 FEET TO THE NORTH LINE OF WASHINGTON STREET; THENCE EAST ALONG THE NORTH LINE OF WASHINGTON STREET 90.00 FEET TO THE PLACE OF BEGINNING. SAID LAND WILL BE CALLED LOT 6 OF THE PROPOSED HILLTOP SUBDIVISION IN THE CITY OF DELAVAN, WISCONSIN.

AND THAT THE PLAT SHOWN ABOVE IS A CORRECT REPRESENTATION OF THE PROPERTY LINES AND IMPROVEMENTS LOCATED THEREON.
 SEPT. 5, 1957

Lot 6 of Hilltop XH1-6

George T. Dunham
 GEORGE T. DUNHAM, SURVEYOR
 DELAVAN, WISCONSIN 283