
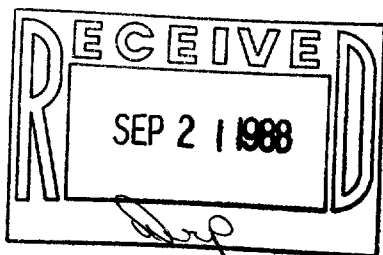


WISCONSIN STREET

LOT 3, BLOCK 4 OF LARNARD'S SUBDIVISION
OF LATIMER'S ADDITION TO THE CITY OF
DELAVER, WALWORTH COUNTY, WISCONSIN.

CHIMNEY EXTENDS
0.6' ONTO LOT 3

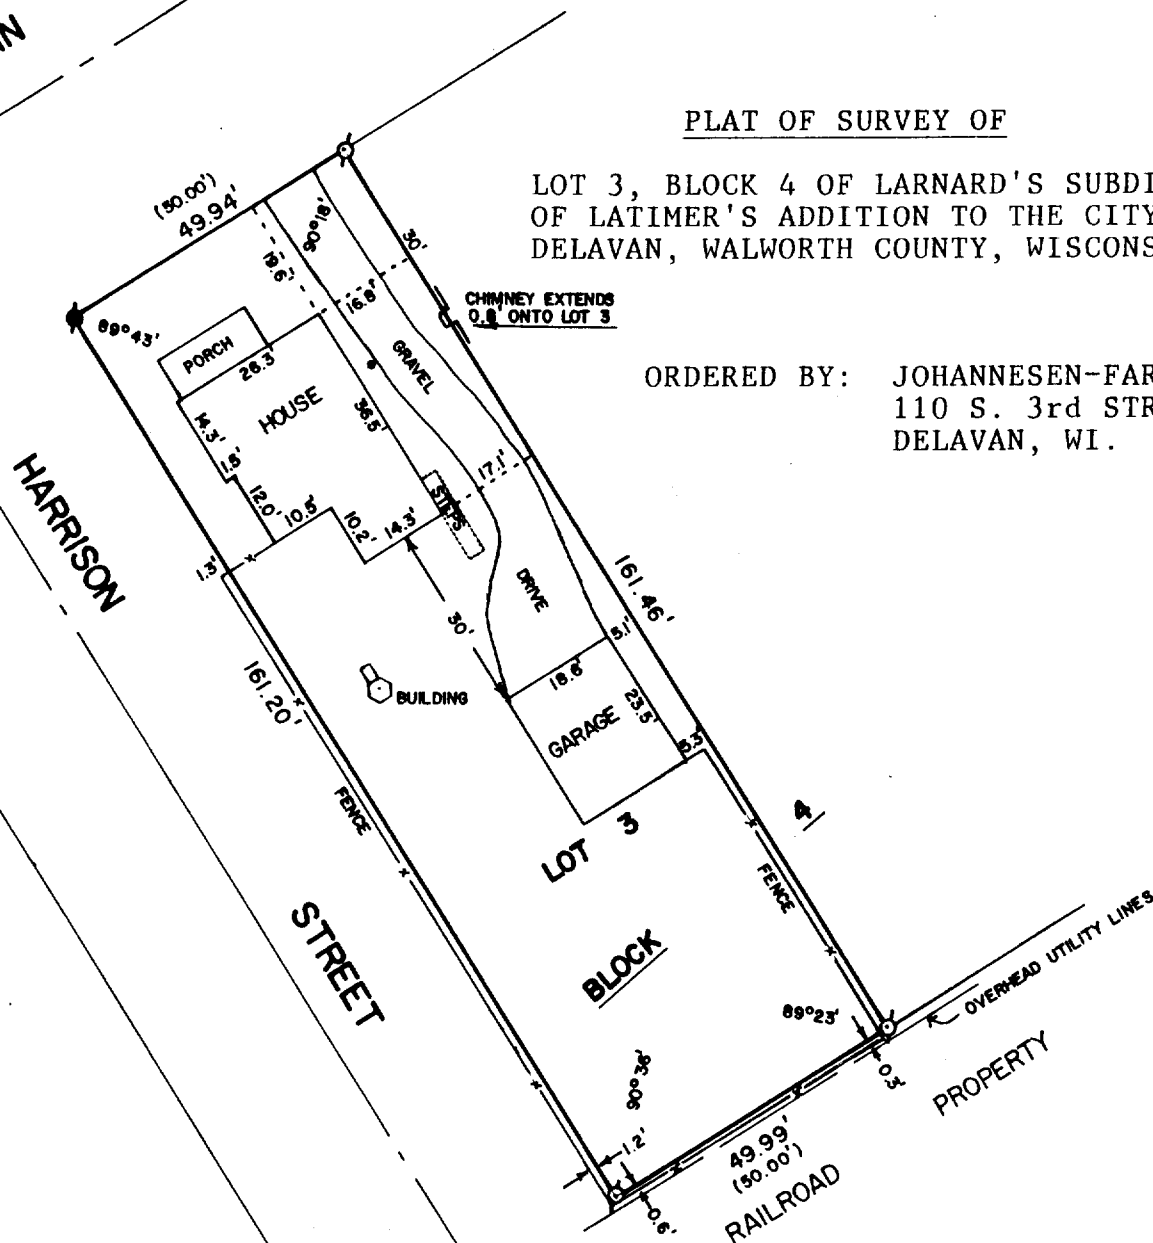

LEGEND

Ø - IRON PIPE FOUND
● - CONCRETE MONUMENT FOUND
• - FILLER PIPE FOR POSSIBLE OIL TANK
() - AS SHOWN ON EXISTING SURVEY RECORDS.

THIS SURVEY IS MADE FOR THE USE OF THE PRESENT OWNERS OF THE PROPERTY, AND ALSO THOSE WHO PURCHASE, MORTGAGE, OR GUARANTEE THE TITLE THERETO WITHIN ONE (1) YEAR FROM DATE HEREOF.

David F. Abell
DAVID F. ABELL
WISCONSIN REGISTERED LAND SURVEYOR, S-1596

DATE August 30, 1988 JOB NUMBER - 88203
NOTE: THIS IS NOT A CERTIFIED COPY UNLESS SEALED. 2-845