
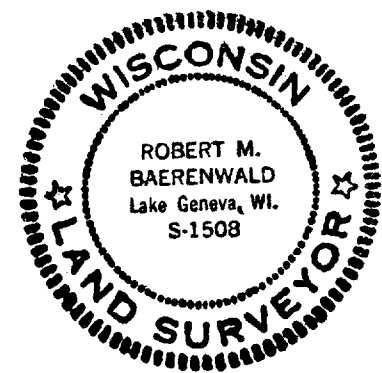


THE NORTH 1/2 OF LOTS 21 AND 22 AND THE EAST 1/2 WEST 1/2 OF LOT 17, BLOCK 2 OF DALLAGE, ARAM AND NGRIE ADDITION TO THE CITY OF DALLAVAN, WALWORTH COUNTY, WISCONSIN.

ORIGIN BY: COLLEGE PARKER-GENEVA LAKES AREA RESEARCH
FOR MAIN STREET
LAKES GENEVA, WISCONSIN
2017

NOTE: IRON PIPE WAS ACCEPTED AS THE ORDER OF THE TWO
 FOUND IRON PIPES AT THE SOUTHWEST CORNER OF BLOCK 1. SOIL
 WAS EXCESSIVE OVERGROW ON THIS BLOCK. ALL MONUMENTS WERE
 ACCEPTED AS FOUND.

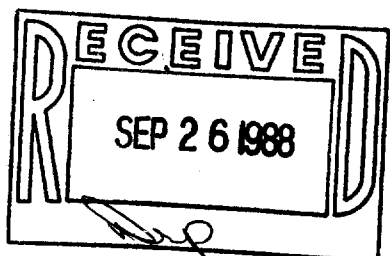

1. NORTH CENTRAL DISTRICT, CHICAGO, ILL. (1967)
 DISTRICT 100-400 AND DISTRICT 100-410, A FLAT
 SURFACED HIGH RISE BUILDING, 100-410, AND LOCATED
 ON THE N. W. CORNER OF THE INTERSECTION OF
 100-410 VILLAGE STREET AND 100-410 N. FULLER
 STREET, CHICAGO, ILL. (1967) (1968) (1969)
 100-410 AND 100-410 VILLAGE STREET, CHICAGO, ILL.

THE DEATH OF THE FATHER OF THE DEFENDANT, BEING
THE LANCET AND LONDON, AT THE MARRIAGE
OF THE DEFENDANT WITH THE PLAINTIFF ONE (1) YEAR FROM
THE DEATH.

Robert M. Hammond
JOHN H. BAILEY
ALBANY REGISTERED LAND OFFICE, 1915

Aug. 4, 1960