

C. M. ST. P. & P. RAILROAD
R. O. W. LINE

(INCOMP. 103994)
N60°48'23"E 1039.83'

(INCOMP. 31872)
N60°05'35"E 310.55'

WRIGHT STREET

BLACKTOP PARKING & STORAGE AREA

GRAVEL PARKING AREA

BUILDING


UTILITY POLE

FLAG POLE

S18°35'35"E 700.23'
(S18°29'E 698.96')

(N18°28'W)
704.52'

DOC. NO. 538178

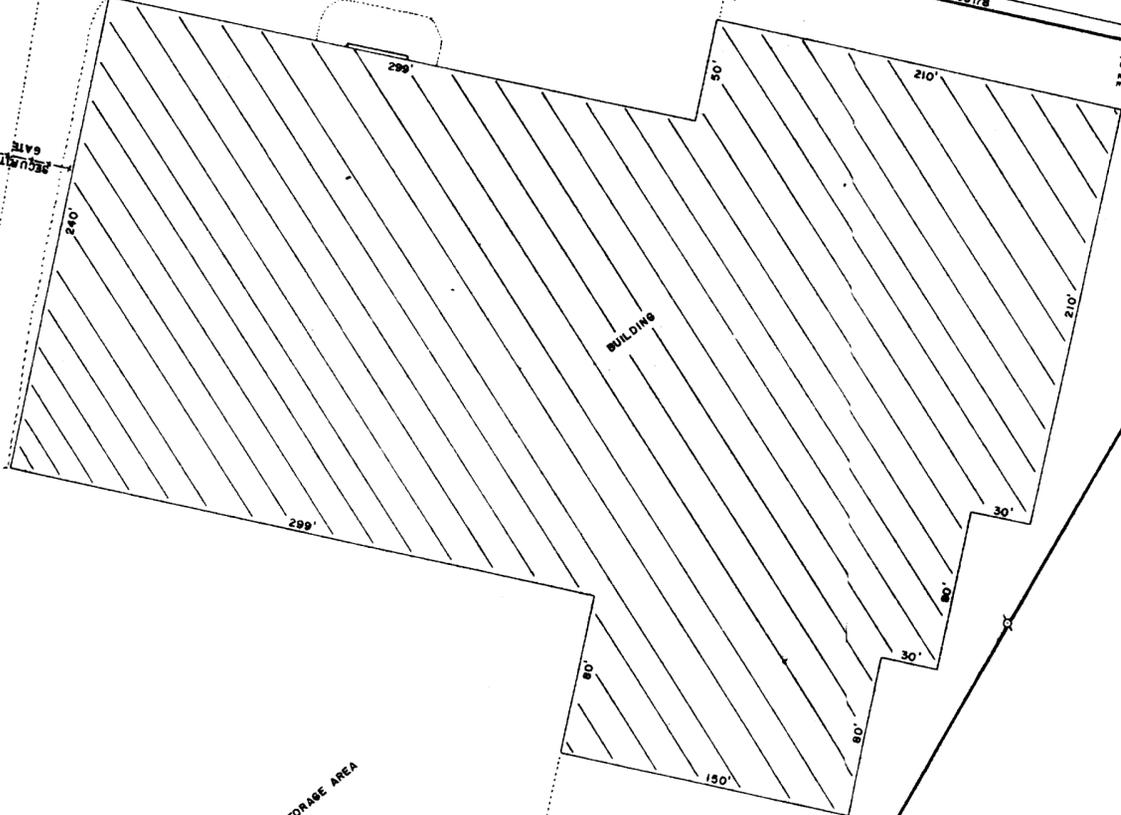

EAST 997.7'
(1008.17')

CENTER OF SECTION 17 TEN RISE

S89°44'00"E 402.08'
(402.197)



SCALE: 1" = 60'
□ - IRON PIPE FOUND
○ - CONCRETE MONUMENT FOUND
() - RECORDED AS

THIS IS THE PLAN OF A SURVEY BY
GABRIEL G. GILBERT DATED SEPTEMBER, 1922.

RECEIVED
SEP 26 1928

PART OF SURVEY

A PART OF THE TRACT OF LAND...
TO THE SURVEYOR...
THE SURVEYOR...
THE WEST LINE OF WHICH...
THE SOUTH LINE OF WHICH...
THE EAST LINE OF WHICH...
THE NORTH LINE OF WHICH...

ORDERED BY: SMITH, LAMAR AND PHELPS
ATLANTA, GEORGIA
2222 BROADWAY, N.E.
ATLANTA, GEORGIA

I, ROBERT M. BAERENWALD, A REGISTERED LAND SURVEYOR...
COUNTY OF WAUKESHA, WISCONSIN...
BUSINESS CREDIT AND CHICAGO TITLE INSURANCE COMPANY...
PROPERTY OF BUILDINGS, STRUCTURES OR OTHER IMPROVEMENTS...
EXCEPT AS SHOWN, NOTED OR DESCRIBED ON SUCH SURVEY PLAT...
THE ABOVE PROPERTY DESCRIPTION INCLUDES ALL OF PARCEL 1 AS SHOWN IN THE SAID TITLE COMMITMENT NUMBER WAI-38573...

THE ABOVE PROPERTY DESCRIPTION INCLUDES ALL OF PARCEL 1 AS SHOWN IN THE SAID TITLE COMMITMENT NUMBER WAI-38573, WHICH PARCELS ARE CONTIGUOUS AND COMPOSE THE ENTIRE PROPERTY AS DESCRIBED ABOVE.

Robert M. Baerenwald
ROBERT M. BAERENWALD
WISCONSIN REGISTERED LAND SURVEYOR, No. 101

DATE: Aug 4, 1928

WISCONSIN COUNTY SURVEYOR
LAKE GENEVA, WISCONSIN
S-1508

