



ABELL  
SURVEYING & MAPPING  
DELAHAN, WISCONSIN 53115  
414-728-6737

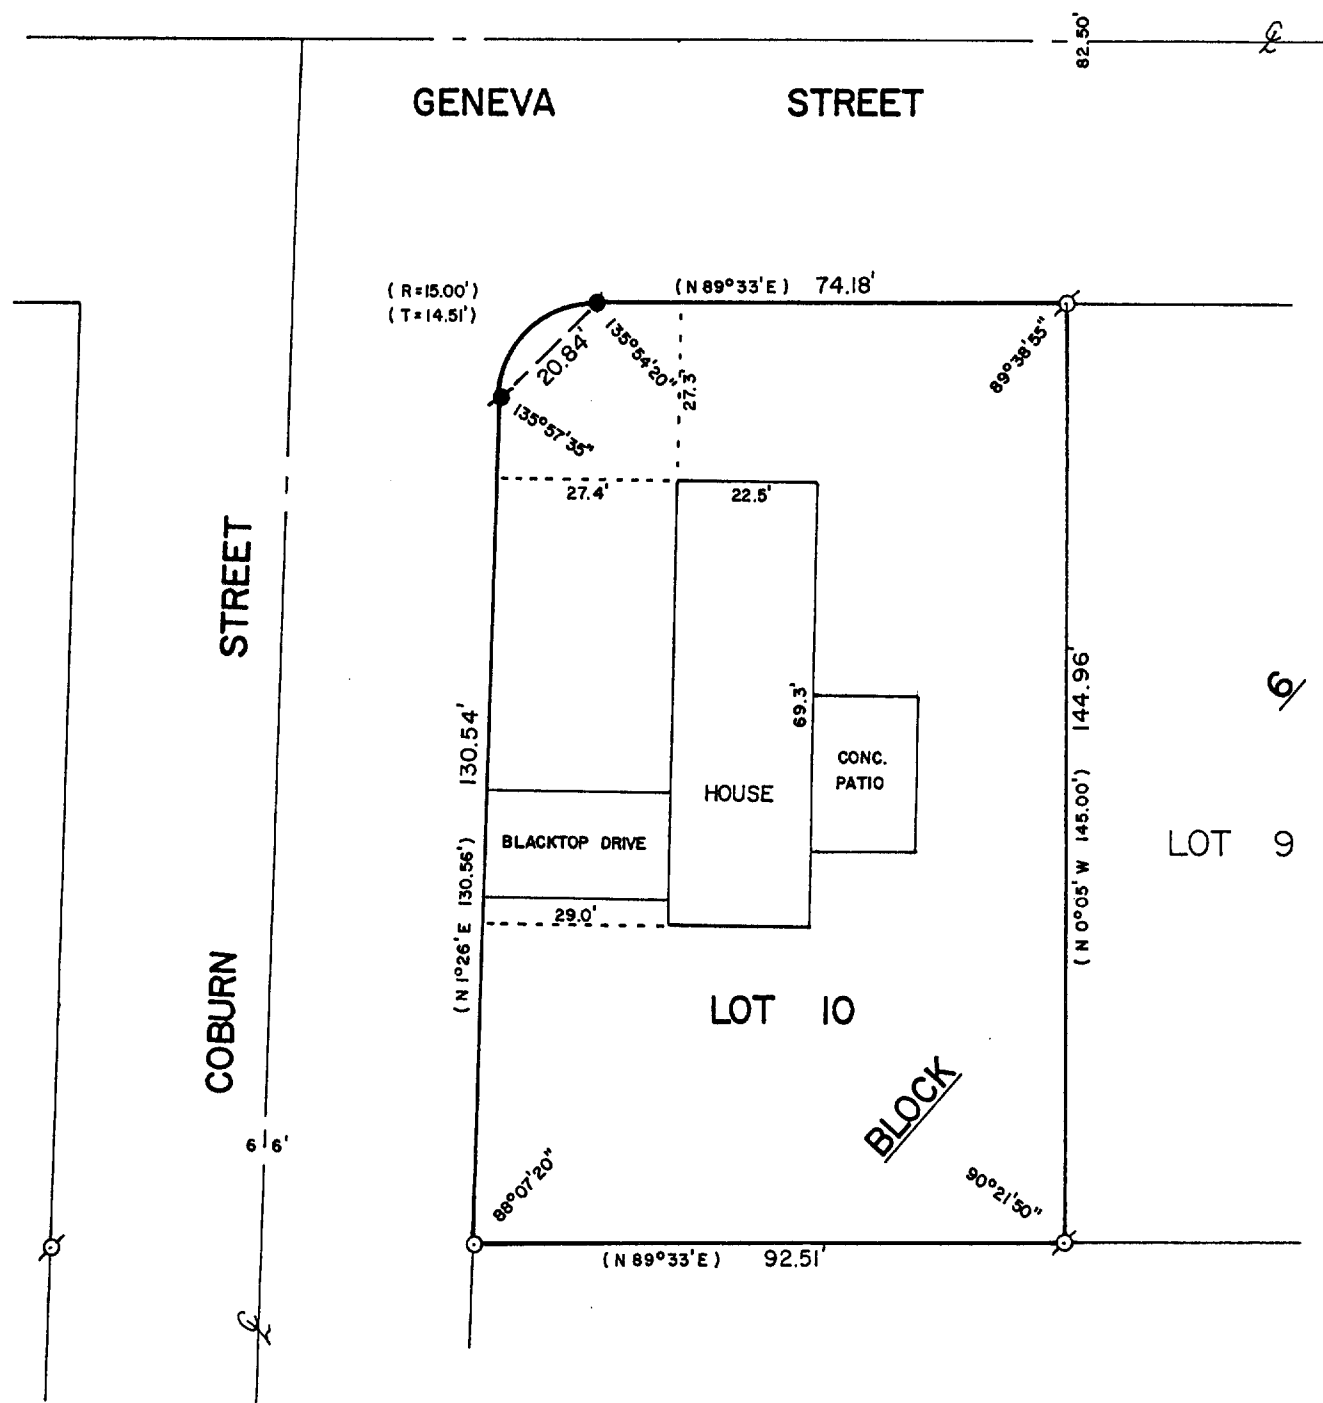

PLAT OF SURVEY OF

LOT 10, BLOCK 6, SPRINGS PARK SUBDIVISION  
ADDITION NO. 1, CITY OF DELAVAL, WALWORTH  
COUNTY, WISCONSIN.

ORDERED BY: CENTURY 21 - SKANDIA REALTY  
312 S. 7th STREET  
DELAVAL, WI. 53115

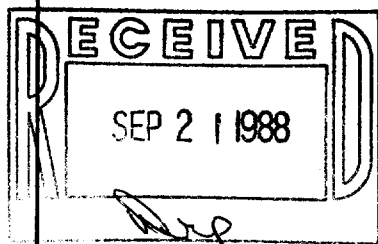

SCALE - 1"=30'

LEGEND

- Ø - IRON PIPE FOUND
- - IRON PIPE FOUND LEANING, RESET IRON PIPE
- - CONCRETE MONUMENT FOUND
- - IRON ROD SET
- ( ) - RECORDED AS

I, DAVID F. ABELL, DO HEREBY CERTIFY  
THAT I HAVE SURVEYED THE PROPERTY  
HEREON DESCRIBED ACCORDING TO THE  
OFFICIAL RECORDS AND THAT THE PLAT  
HEREON IS A CORRECT REPRESENTATION  
OF THE PROPERTY LINES TO THE BEST OF  
MY KNOWLEDGE AND BELIEF.

*David F. Abell*  
DAVID F. ABELL  
WISCONSIN REGISTERED LAND SURVEYOR, S-1596

DATE *July 21, 1988* JOB NUMBER - 88156

NOTE: THIS IS NOT A CERTIFIED COPY UNLESS SEALED. 2-852