


DUNHAM SURVEYING, S.C.
SURVEYING & SUBDIVIDING
DELAVER, WISCONSIN 53115

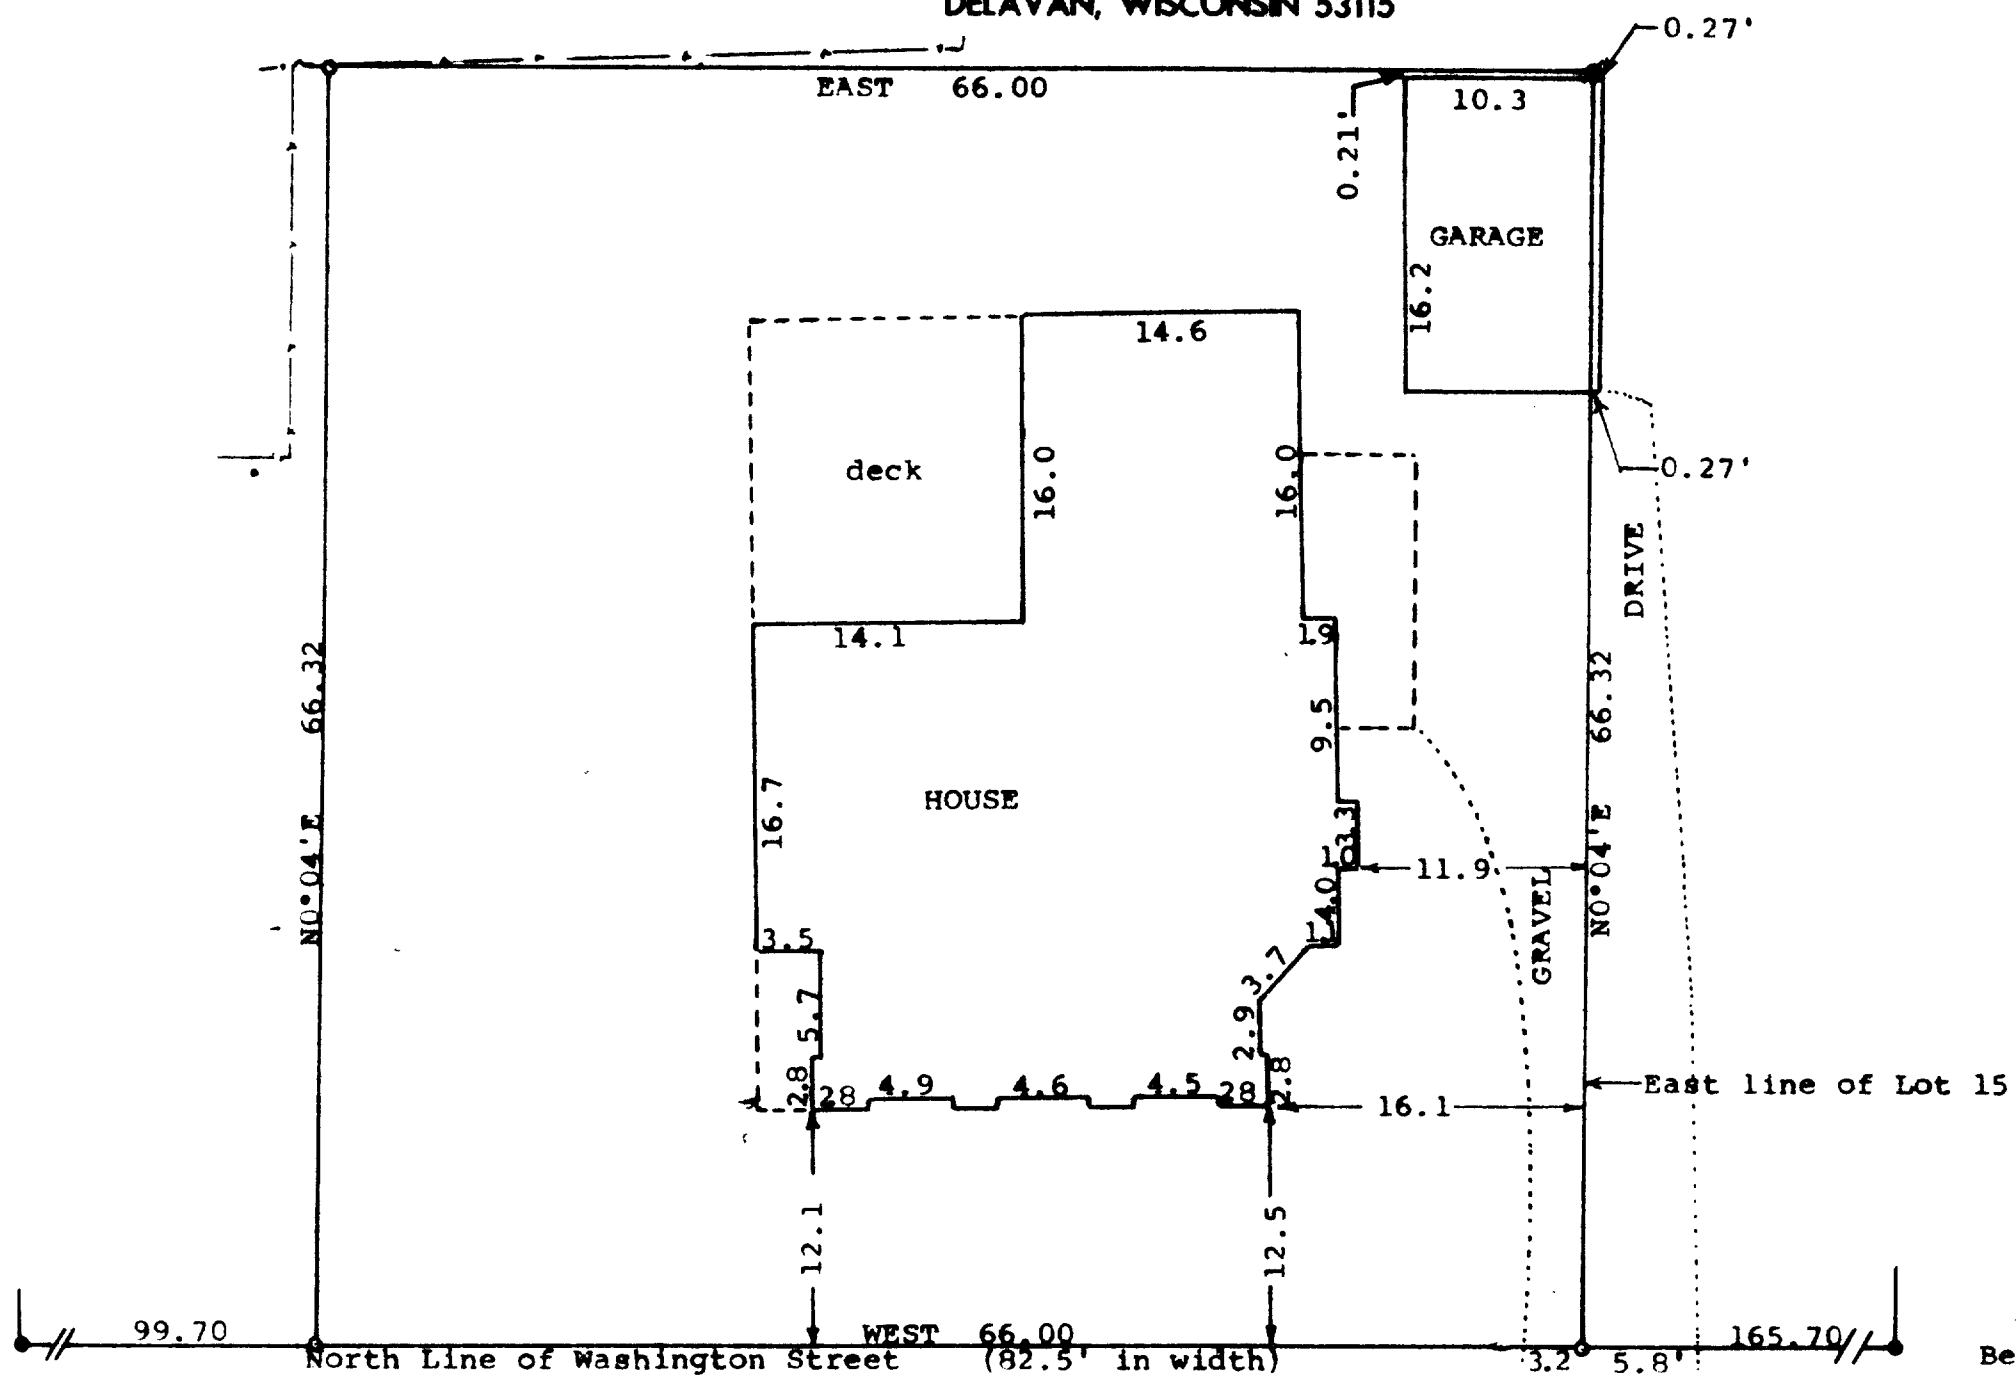

Scale - 1" = 10'
 o = 3/4" Iron Pipe Found
 # = 1/2" Iron Pipe Found
 ● = concrete monument found
 -x-x- = Fence Line
 Bearings referenced to the assumed bearing of West along the north line of Washington Street
 Survey ordered by: Realty World
 Carmin Realtors
 811 E. Geneva Street
 Delavan, WI 53115

STATE OF WISCONSIN)
 COUNTY OF WALWORTH) SS

I, George T. Dunham, Surveyor, certify that I have surveyed the property described as follows:

The East 66.00 feet of Lot 15, Block 1 of Passage, Aram, and Downie's Addition to the Village (now City) of Delavan, Walworth County, Wisconsin.

and that the above map is a true representation thereof and shows the size and location of the property, its exterior boundaries, the location of all visible structures and dimensions of all principal buildings thereon, boundary fences, apparent easements, roadways and visible encroachments, if any, and that I have surveyed the property hereon described, according to the official records, to the best of my knowledge and belief.
 May 18, 1988

George T. Dunham
 George T. Dunham, Surveyor

