


DUNHAM SURVEYING, S.C.
SURVEYING & SUBDIVIDING
DELAVER, WISCONSIN 53115

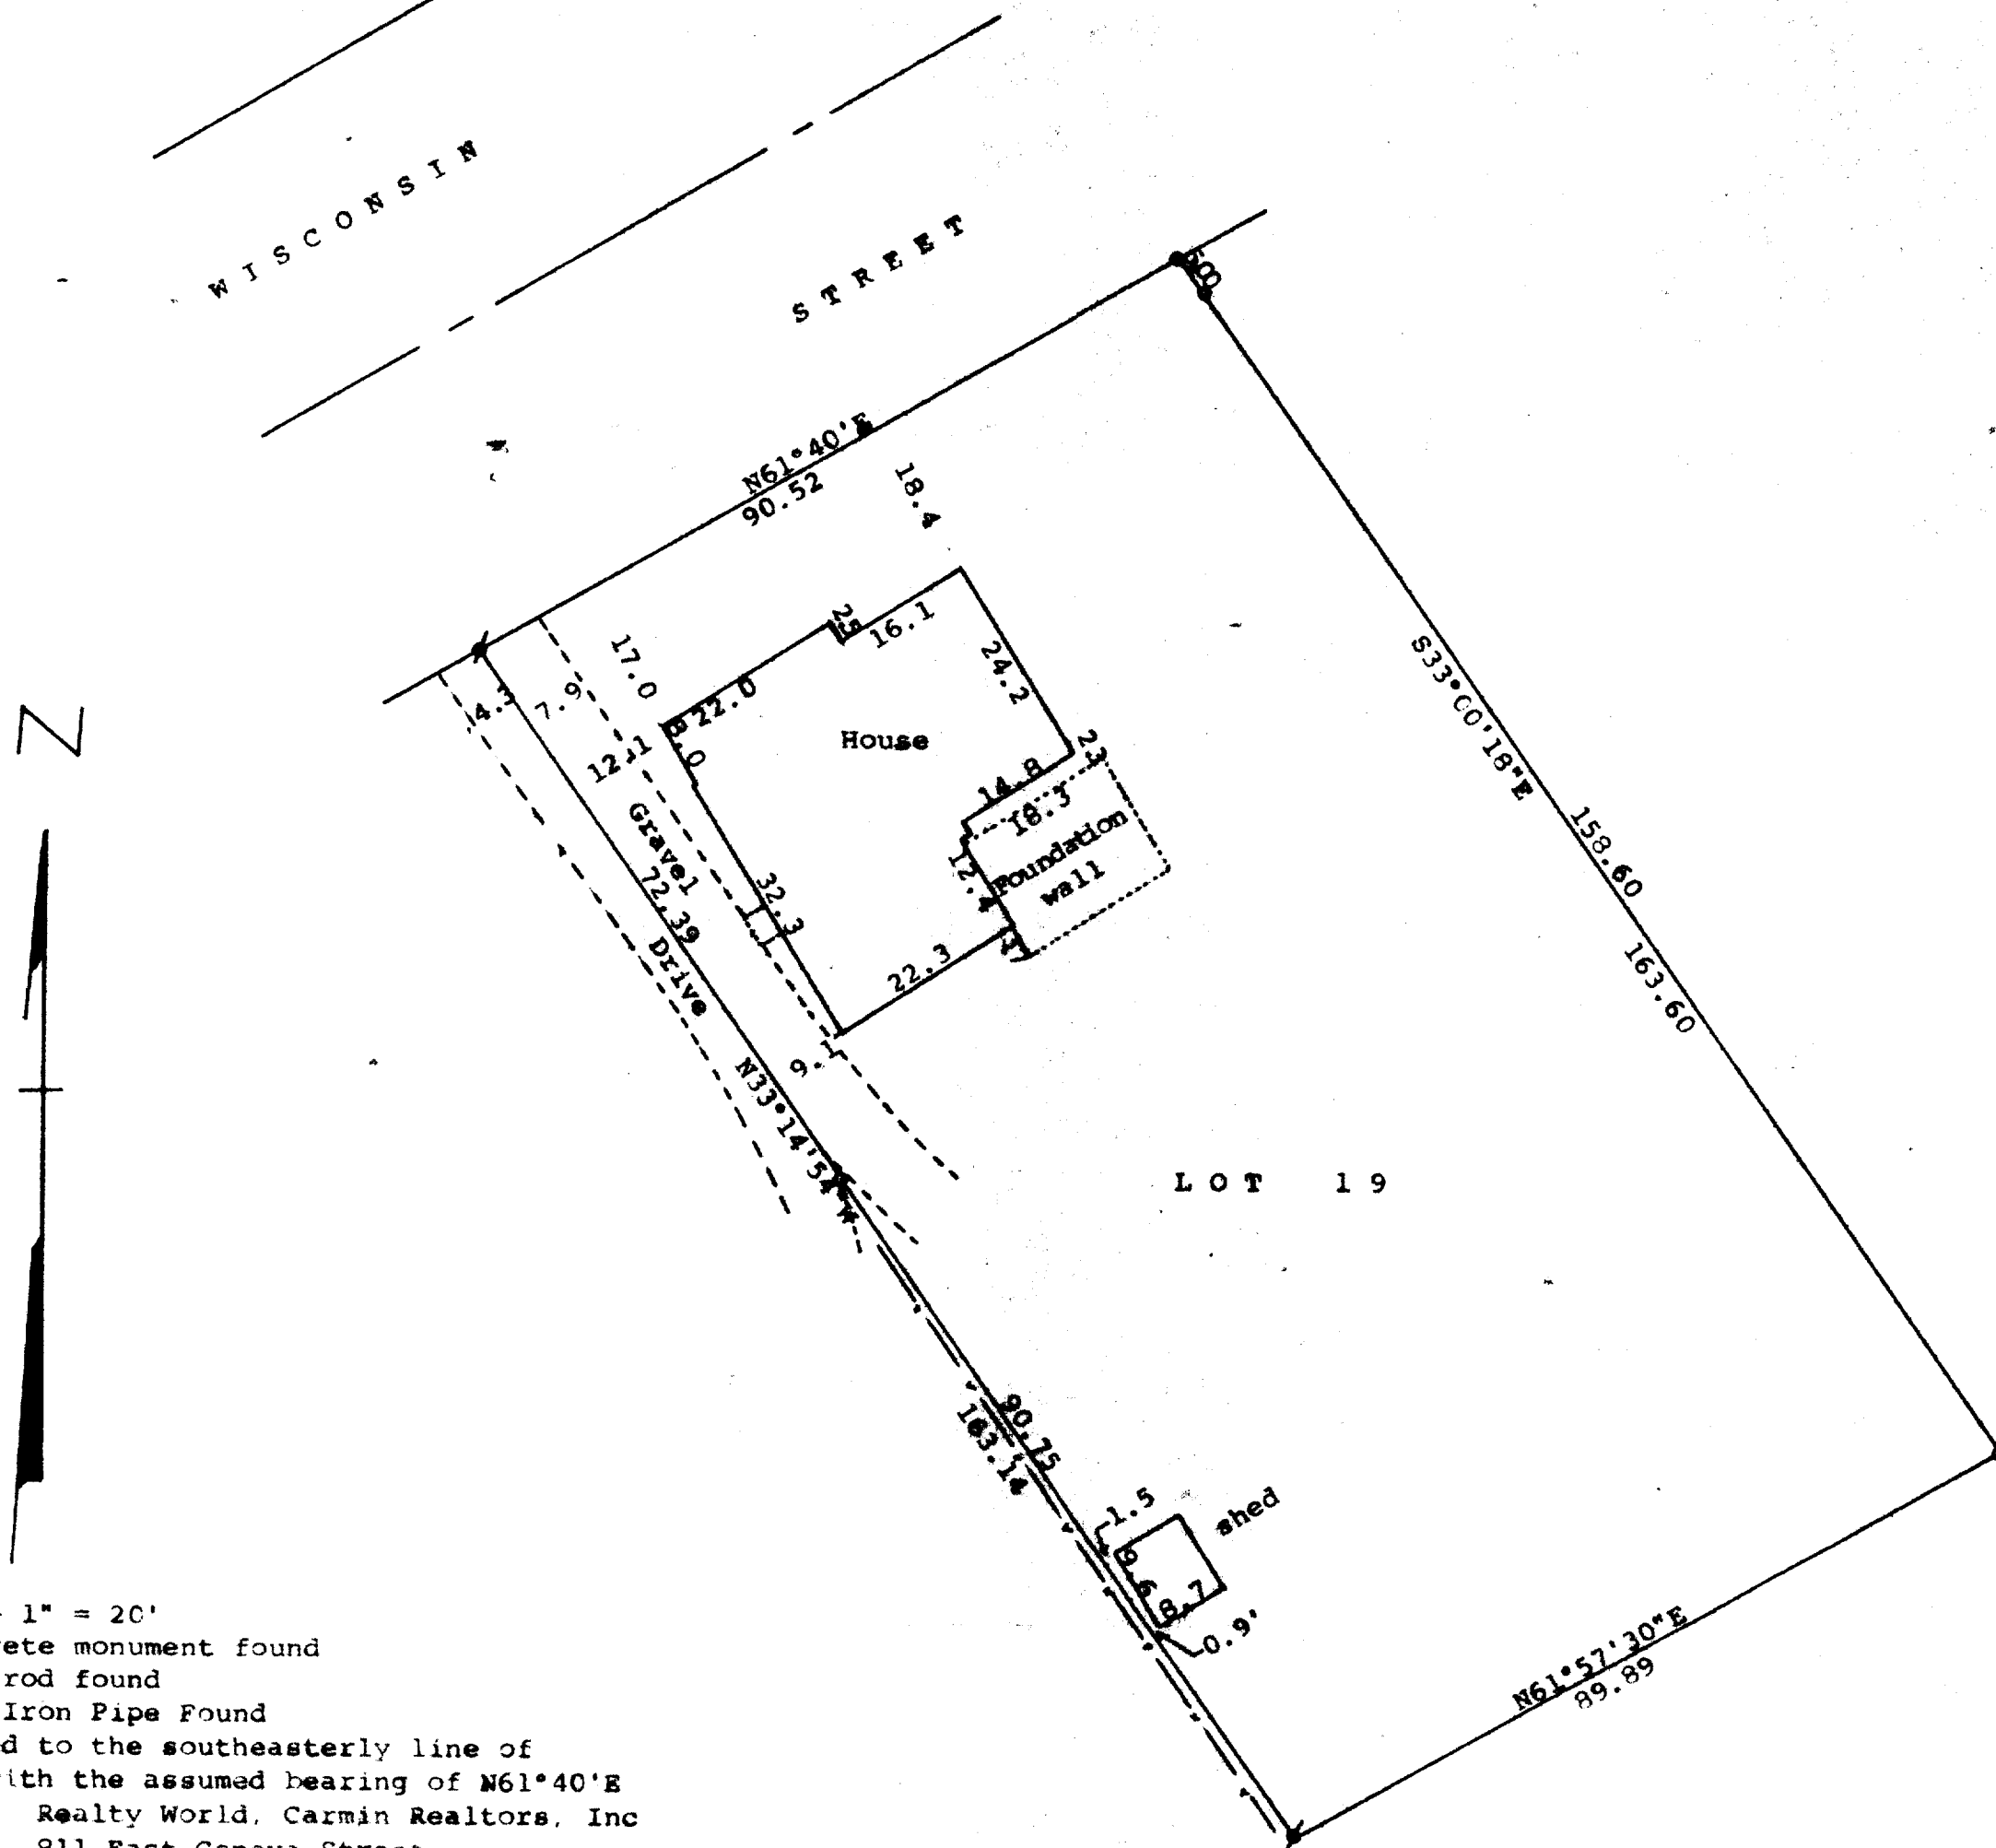

Scale - 1" = 20'

• = concrete monument found

• = iron rod found

o = 3/4" Iron Pipe Found

Bearings referenced to the southeasterly line of Wisconsin Street with the assumed bearing of N61°40'E
 Survey ordered by: Realty World, Carmin Realtors, Inc
 811 East Geneva Street
 Delavan, WI 53115

- - - - - fence line


STATE OF WISCONSIN) SS
 COUNTY OF WALWORTH)

I, George T. Dunham, Surveyor, certify that I have surveyed the property described as follows:

Lot 19, Block 6 of Converse's Subdivision located in the City of Delavan, Walworth County, Wisconsin

and that the plat shown hereon is a true representation thereof and shows the size and location of the property, its exterior boundaries, the location of all visible structures and dimensions of all principal buildings thereon, boundary fences, apparent easements, roadways and visible encroachments, if any, and that I have surveyed the property hereon described, according to the official records, to the best of my knowledge and belief.

May 31, 1988

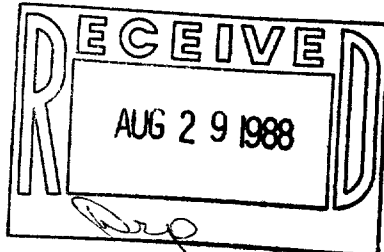

George T. Dunham
 George T. Dunham, Surveyor

