


DUNHAM SURVEYING, S.C.
SURVEYING & SUBDIVISION
DELAVER, WISCONSIN 53115

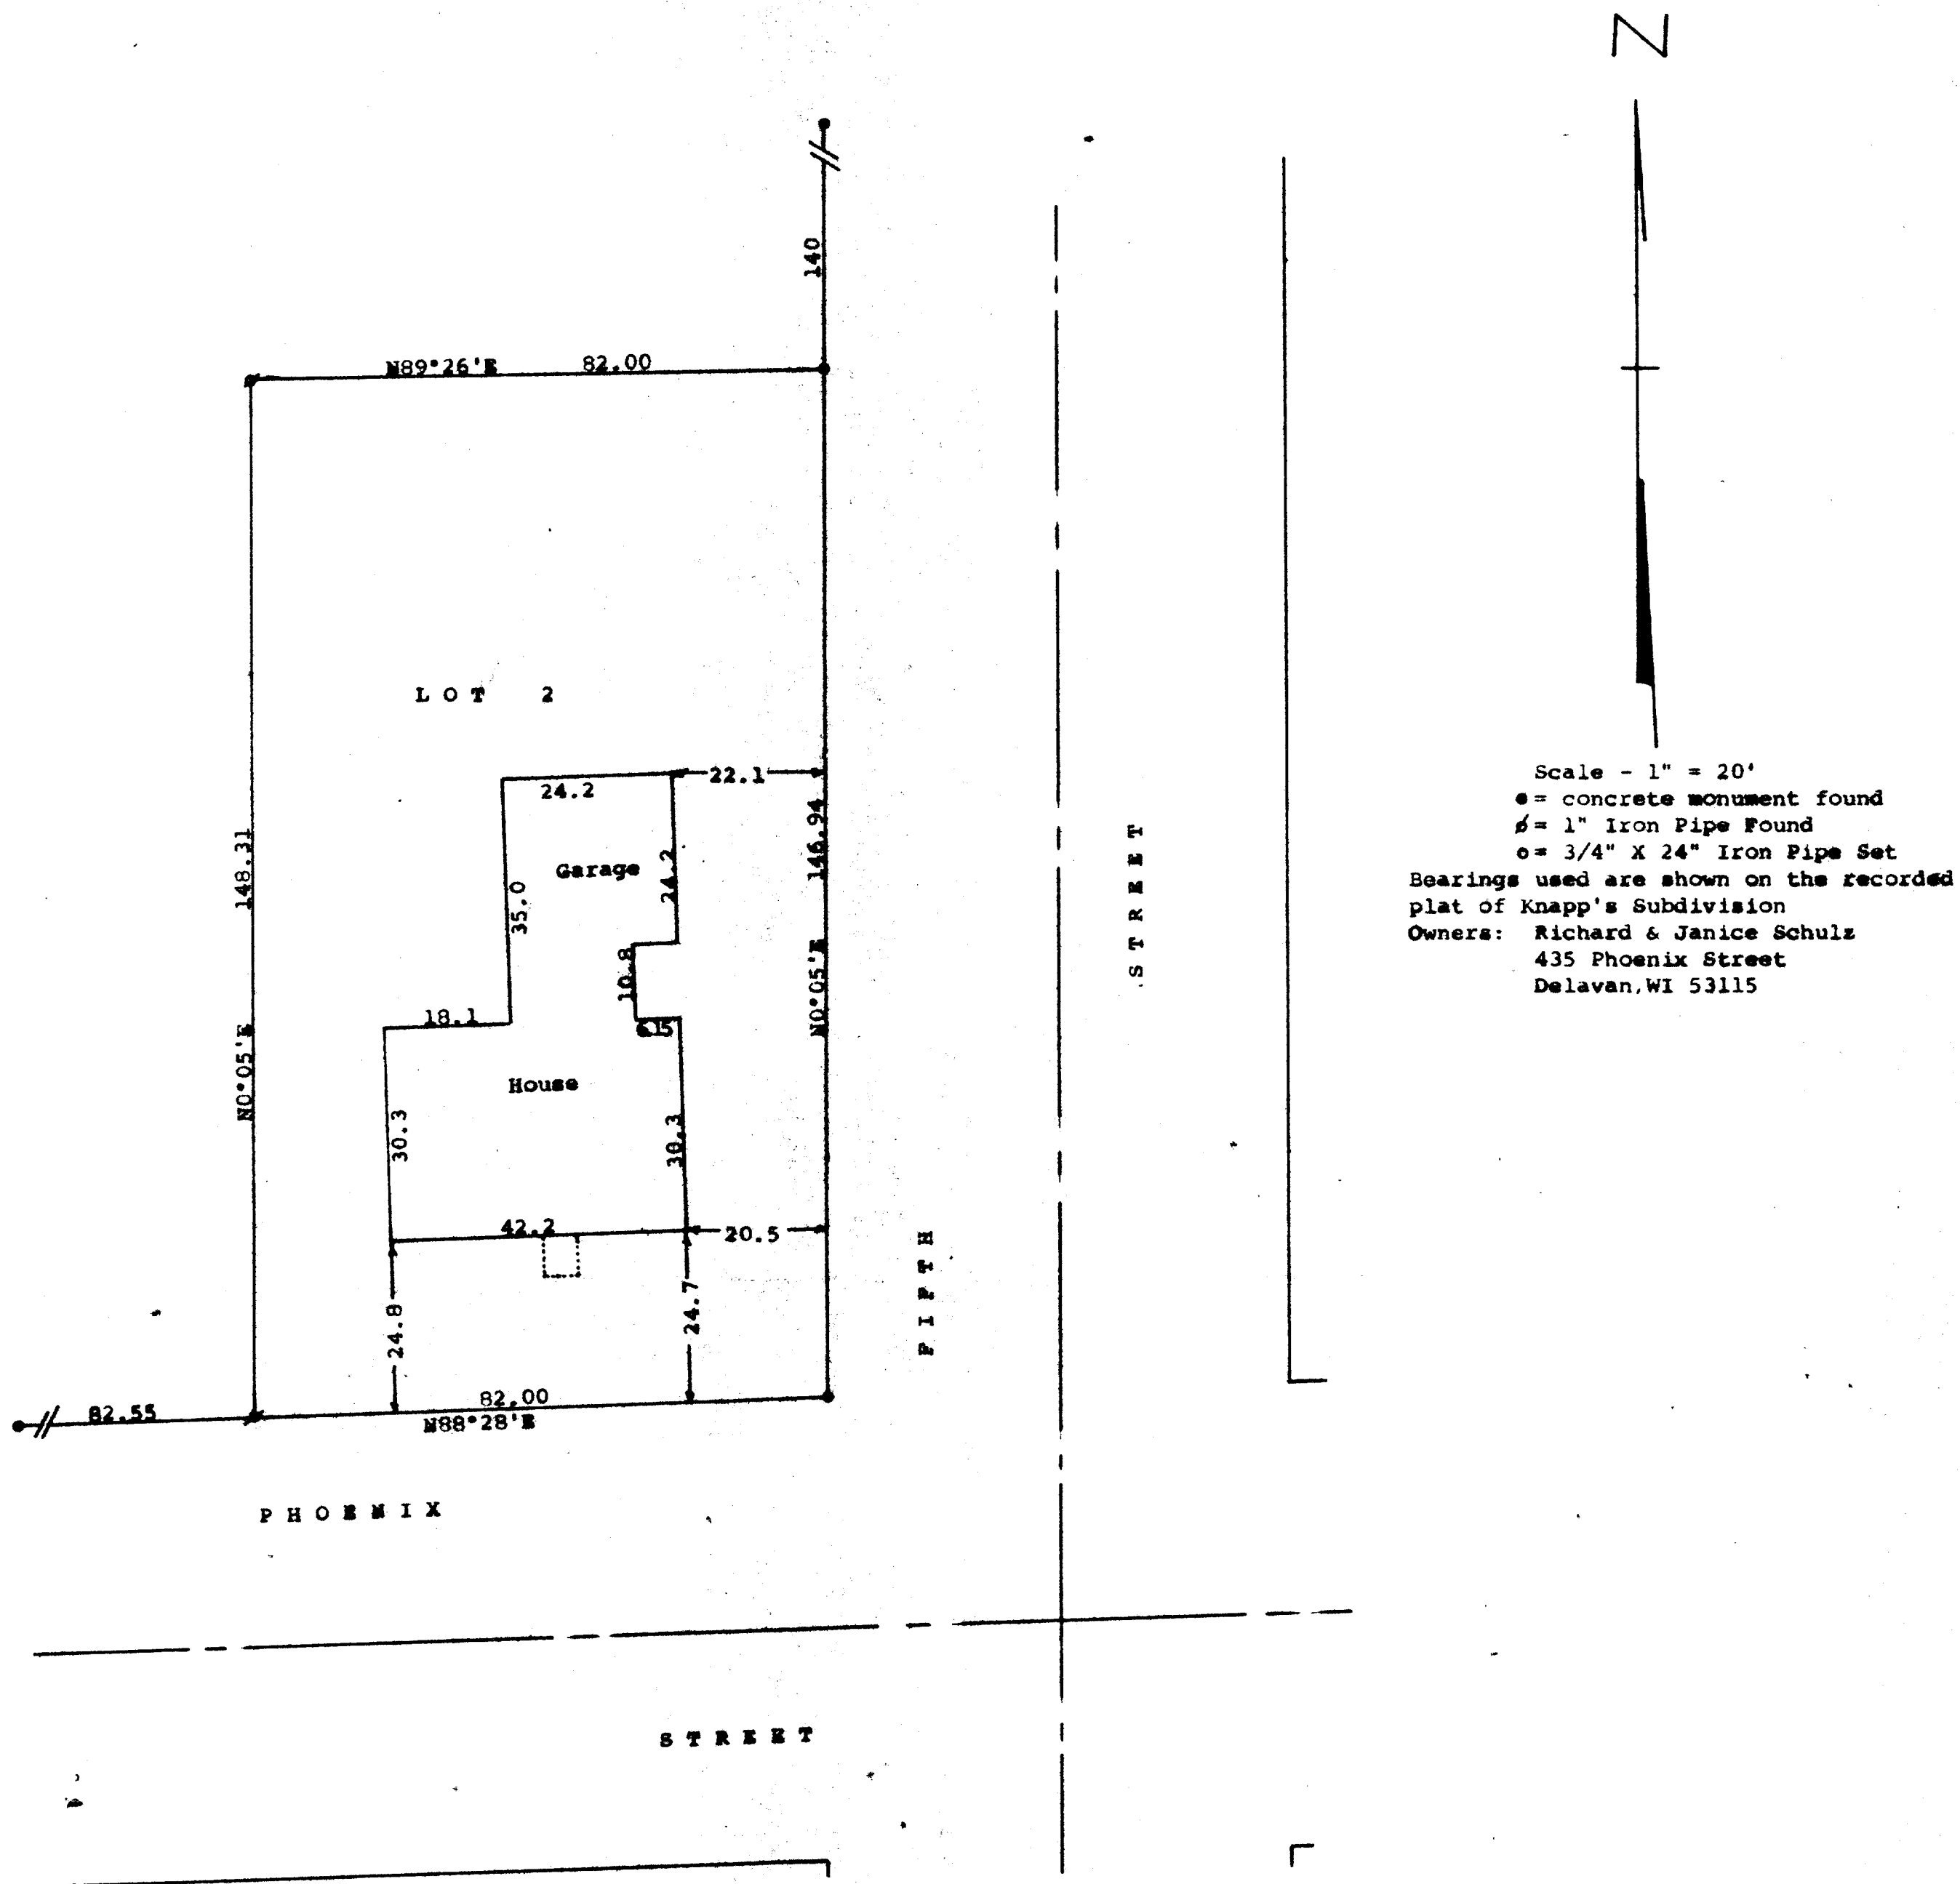


STATE OF WISCONSIN)
COUNTY OF WALWORTH) ss

I, George T. Dunham, Surveyor, certify that I have surveyed the property described as follows:

Lot 2 in Knapp's Subdivision located in the City of Delavan, Walworth County, Wisconsin,

and that the plat shown hereto is a correct representation thereof and shows the size and location of the property, its exterior boundaries, the location of all visible structures and dimensions of all principal buildings thereon, boundary fences, apparent easements, roadways and visible encroachments, if any, and that I have surveyed the property hereto described, according to the official records, to the best of my knowledge and belief.

June 11, 1988

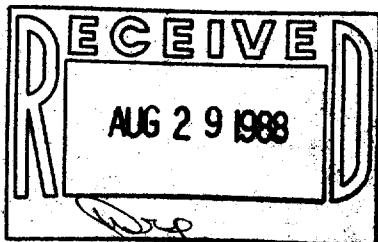

George T. Dunham
George T. Dunham, Surveyor

