


DUNHAM SURVEYING, S.C.
SURVEYING & SUBDIVIDING
DELAVER, WISCONSIN 53115



HERMAN

STREET

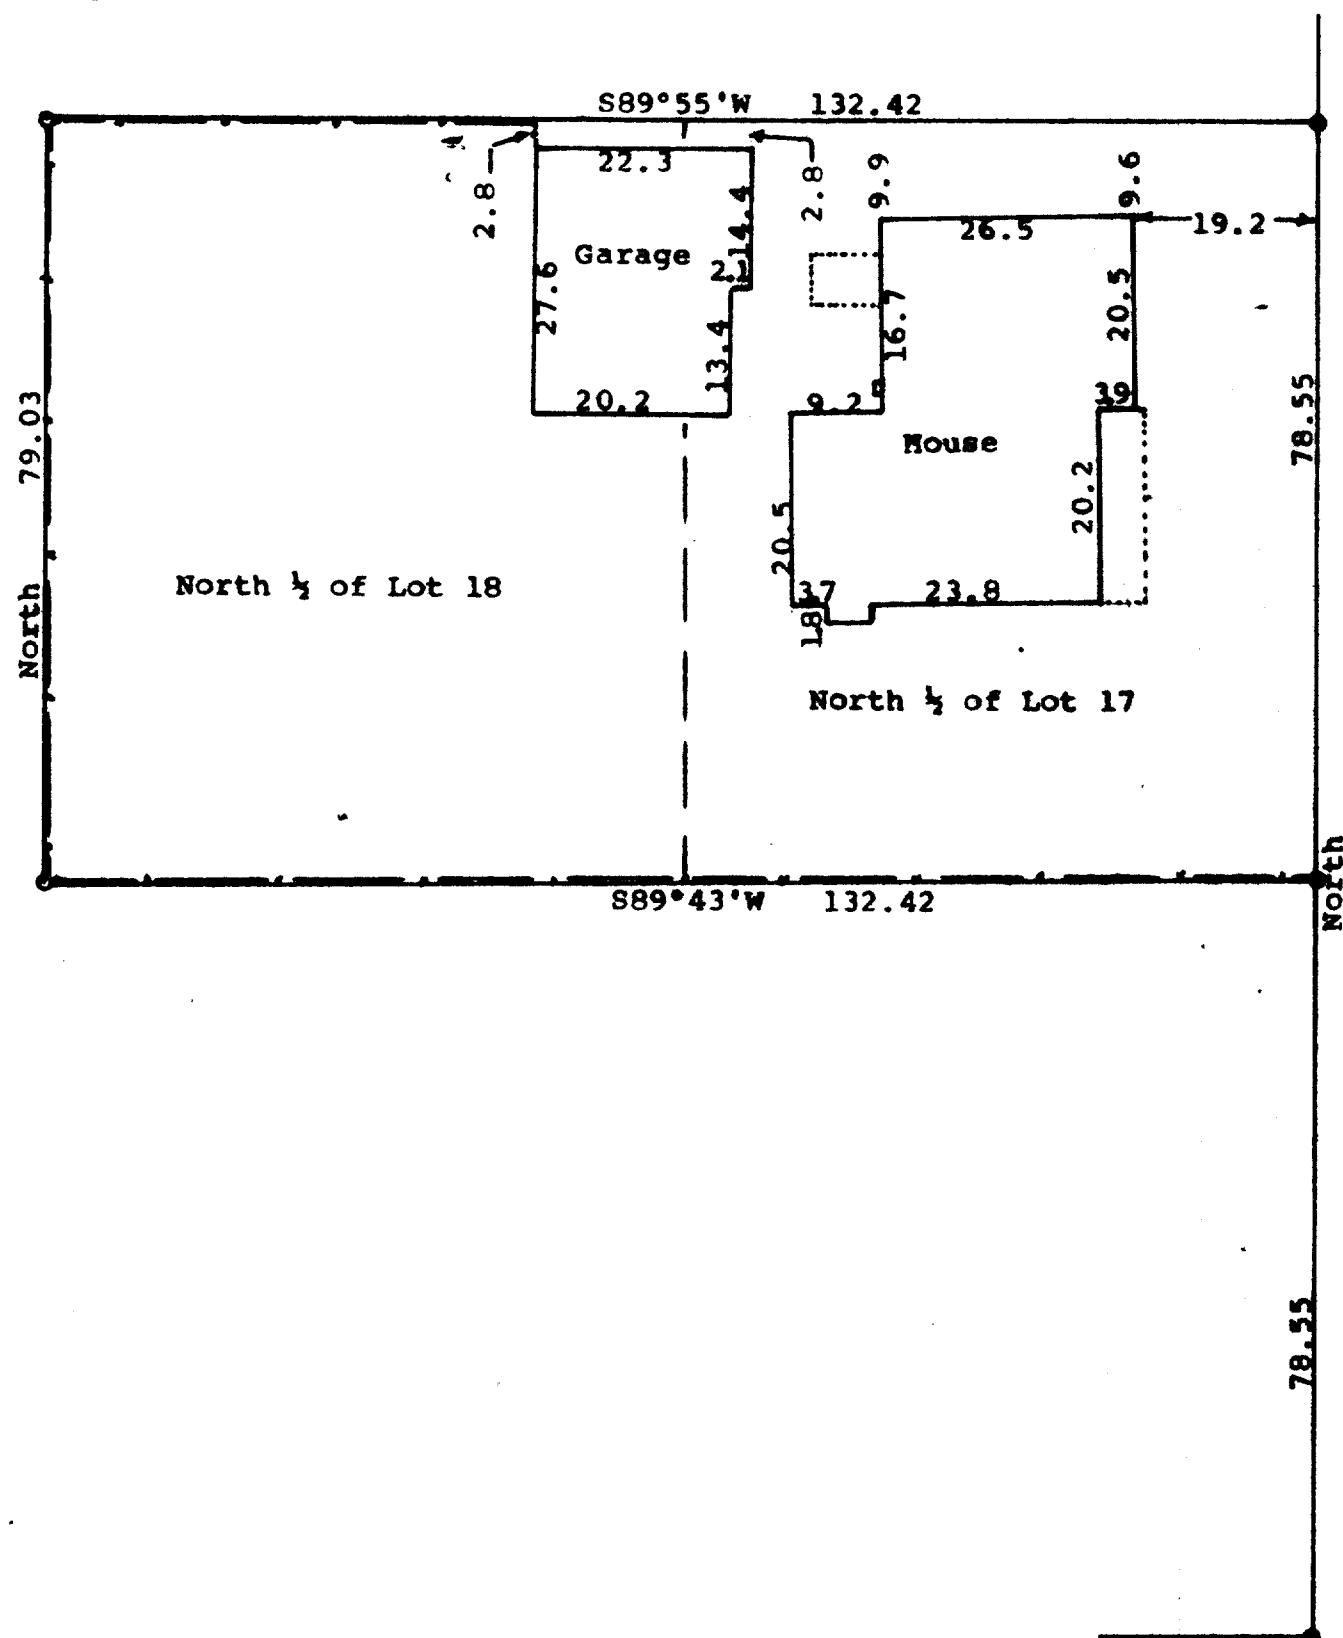

Scale - 1" = 20'

● = concrete monument found

○ = 1" Iron Pipe Found

— = fence line

Bearings referenced to the west line of Herman Street with the assumed bearing of North

Survey ordered by:

Realty World, Carmin Realtors

811 East Geneva Street

Delavan, WI 53115


STATE OF WISCONSIN) ss
COUNTY OF WALWORTH)

I, George T. Dunham, Surveyor, certify that I have surveyed the property described as follows:

the North 1/4 of Lots 17 and 18 in Block 11 of Passage, Aram & Downie Addition City of Delavan, Walworth County, Wisconsin

and that the plat shown hereon is a correct representation thereof and shows the size and location of the property, its exterior boundaries, the location of all visible structures and dimensions of all principal buildings thereon, boundary fences, apparent easements, roadways and visible encroachments, if any, and that I have surveyed the property hereon described, according to the official records, to the best of my knowledge and belief.

October 25, 1988

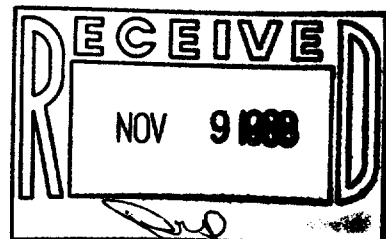

George T. Dunham
George T. Dunham, Surveyor

