


DUNHAM SURVEYING, S.C.  
SURVEYING & SUBDIVIDING  
DELAVER, WISCONSIN 53115

FIFTH

STREET

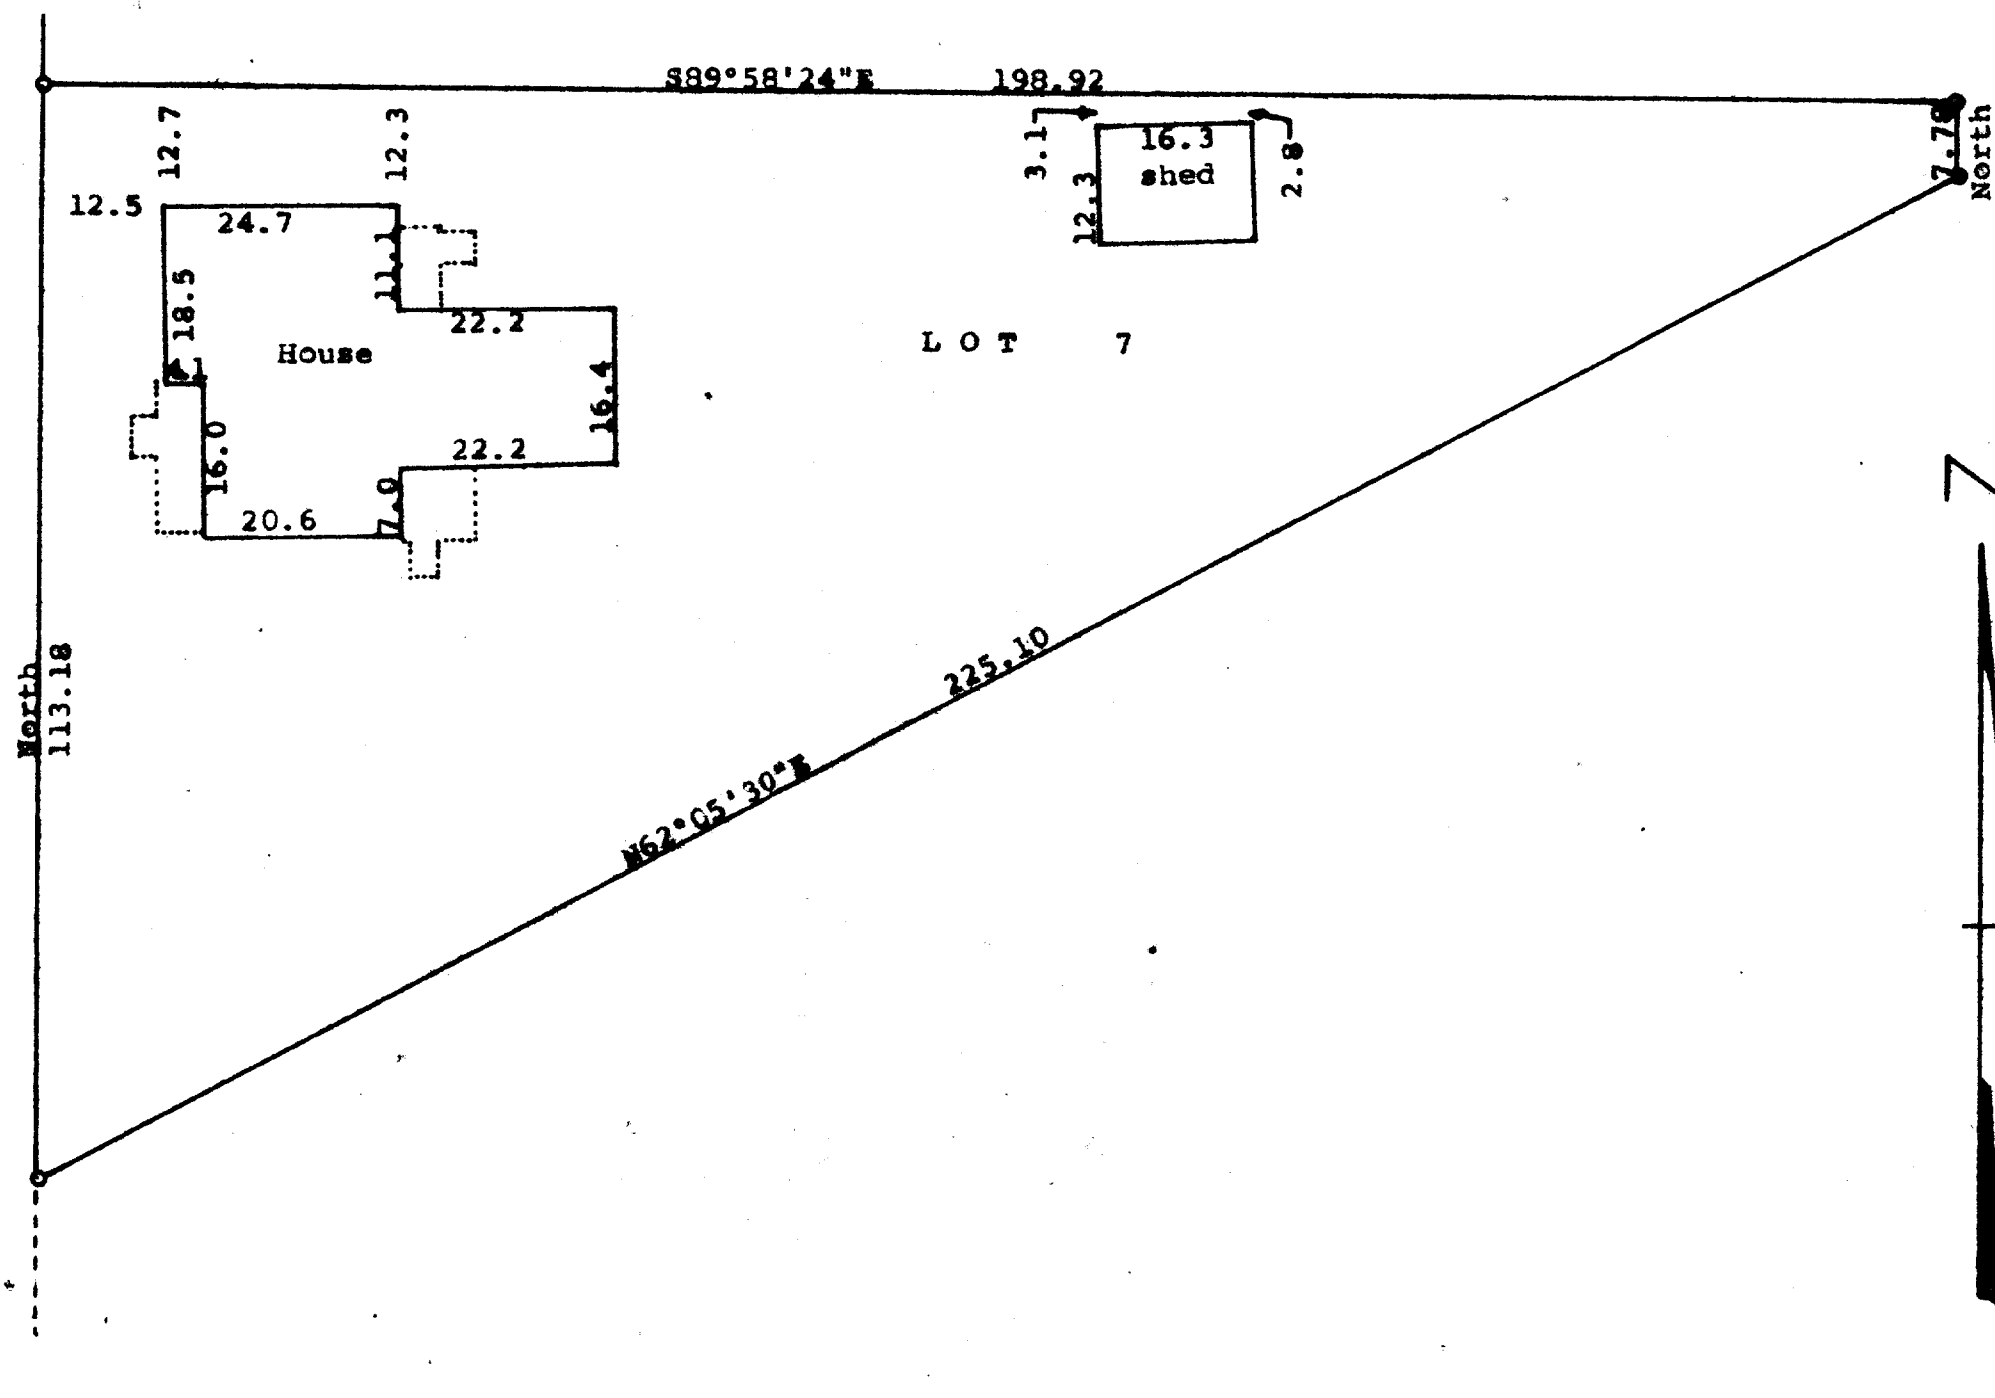

Scale - 1" = 20'  
O = 3/4" Iron Pipe Found  
Bearings referenced to the east  
line of Fifth Street with the  
assumed bearing of North  
Survey ordered by:  
Realty World, Carmia Realtors  
811 East Geneva Street  
Delavan, WI 53115


STATE OF WISCONSIN) SS  
COUNTY OF WALWORTH)

I, George T. Dunham, Surveyor, certify that I have surveyed  
the property described as follows:

Lot 7 in Block 4 in Passage, Aram and Downie Addition located  
in the Village (Now City) of Delavan, Walworth County,  
Wisconsin,

and that the plat shown hereon is a correct representation thereof and  
shows the size and location of the property, its exterior boundaries,  
the location of all visible structures and dimensions of all principal  
buildings thereon, boundary fences, apparent easements, roadways and  
visible encroachments, if any, and that I have surveyed the property hereon  
described, according to the official records, to the best of my knowledge  
and belief.

September 1, 1988

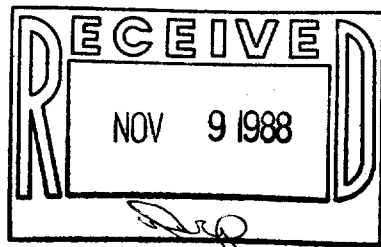

*George T. Dunham*  
George T. Dunham, Surveyor

