

Order Number: T-65697

Commitment Number:

1. Effective date: August 8, 1988 at 8:00 a.m.

2. Policy or Policies to be issued:

Amount of Insurance

A. ALTA Owner's Policy
Proposed Insured:

\$ 43,000.00

Ronald Siedelmann and Camille T. Siedelmann

B. ALTA Loan Policy
Proposed Insured:

C.

3. The estate or interest in the land described or referred to in this commitment and covered herein is fee simple and the therein is at the effective date hereof vested in:

J. David Carroll, as Personal Representative of the Estate of Marie A. Dooley, deceased

4. The land referred to in this commitment is described as follows:

Parcel I: The South 6 feet of the North 32.25 feet of Lot 4, in Block 24 in the City of Delavan.

Parcel II: The South 44 feet of Lot number 4 in Block number 24 in the original plat of the Village (now City) of Delavan, as recorded in the office of the Register of Deeds for said Walworth County, Wisconsin.

Tax Key No. XOP-248 (Note: 1987 net tax is \$1,068.66)

ORDERED BY: The Brannin
Okandia Realty, Inc.
312 S. 5th St.
Delavan, WI 53115
408-3418

SURVEYED BY:

Jensen Surveying & Mapping S.C.
45 S. Wisconsin St. P.O. Box 322
Elkhorn, Wisconsin. 53121
(414) 723-3434


Mapping Date: August 23, 1988

Bearings
referenced
to the West
line of
Second
Street
assumed as
NORTH

SCALE: 1" = 30'

LEGEND

- Found iron pipe
- x Found chiseled cross
- () Recorded dimension

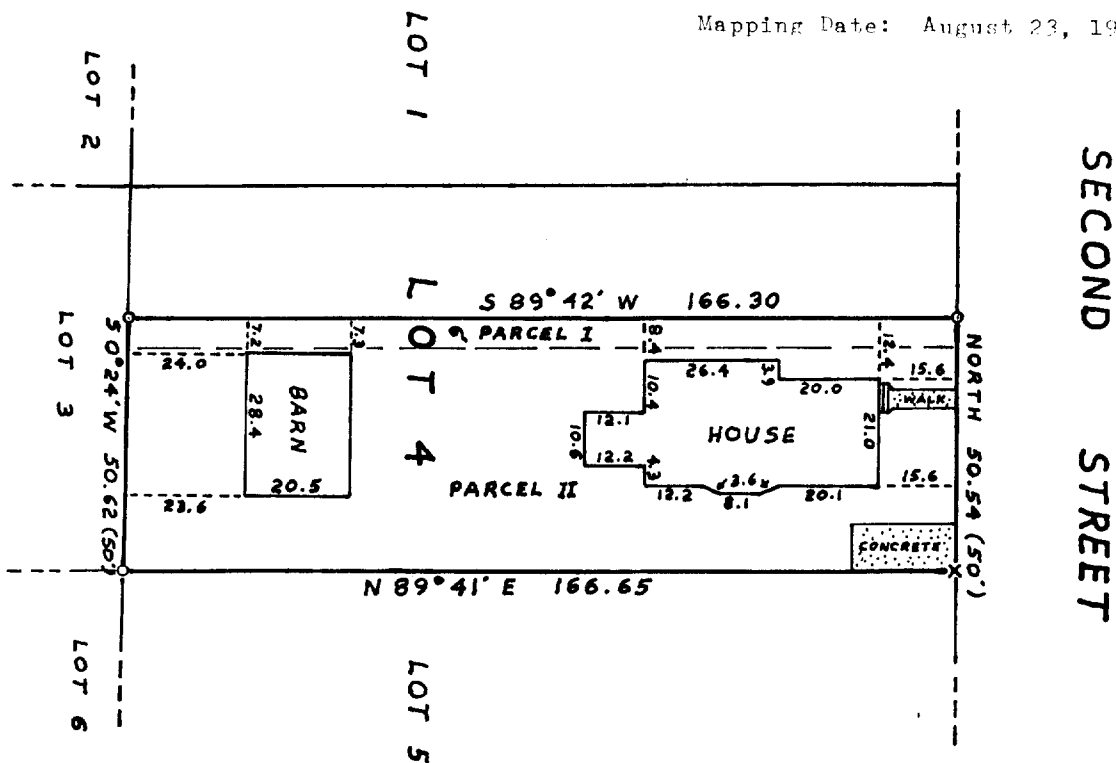


Note: This survey plat is not certified unless signed and sealed in red ink.

Copyright © 1988 by Jensen Surveying & Mapping S.C.

All rights reserved. No part of this survey plat may be reproduced or transmitted in any form by any means - graphic, electronic, or mechanical, including photocopying, tracing, or information storage and retrieval systems - without permission in writing from Thomas P.A. Jensen, Jensen Surveying & Mapping S.C.

I, Thomas P.A. Jensen, Wisconsin Registered Land Surveyor, do hereby certify that this survey was performed by me, or under my direction, in full compliance with the owner's/agent's instructions and Chapter A-E 5 of the Wisconsin Administrative Code "Minimum Standards For Property Surveys"; and that this map is a true and correct representation thereof to the best of my knowledge

Thomas P.A. Jensen R.L.S-1084
Jensen Surveying & Mapping S.C.

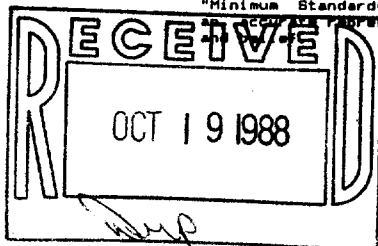

2-886

1988.088