



DUNHAM SURVEYING, S. C.
SURVEYING & SUBDIVIDING
DELAVER, WISCONSIN 53115

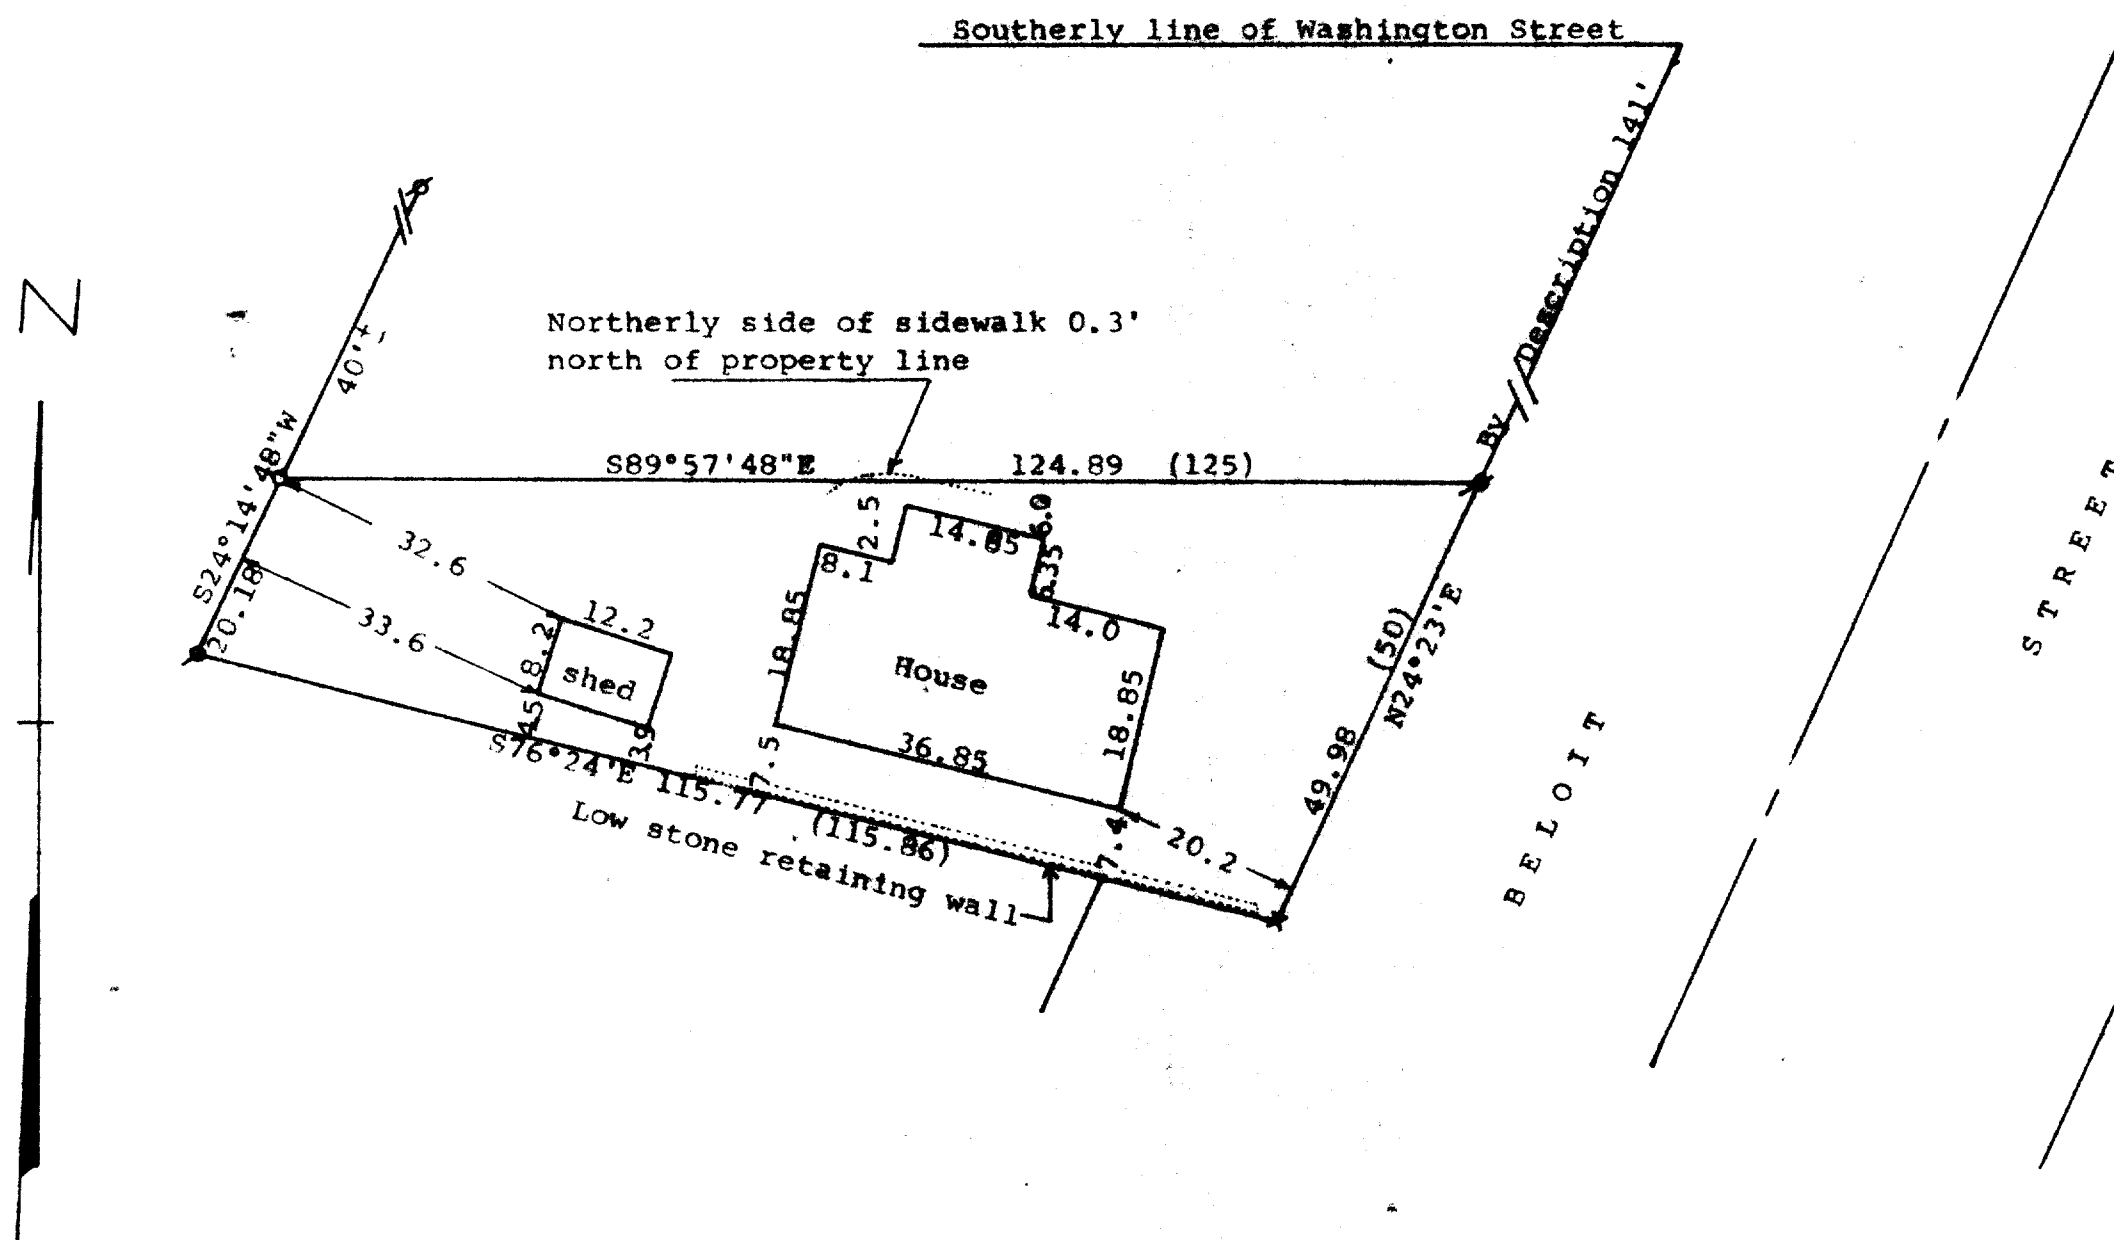

Scale - 1" = 20'
X = Cross in Concrete Found
P = 1" Iron Pipe Found
O = 3/4" X 24" Iron Pipe Set
(00.0) = Recorded distance
Owner: Emil Vosicky
212 Beloit Street
Delavan, WI 53115
Bearings referenced to the recorded bearing
of S76°24'E along the southerly line of the
property surveyed.

STATE OF WISCONSIN) SS
COUNTY OF WALWORTH)

I, George T. Dunham, Surveyor, certify that I have surveyed the
property described as follows:

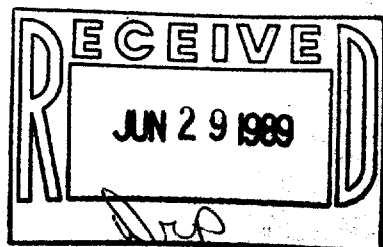

A parcel of land located in the Southwest 1/4 of Section 18, T 2 N,
R 16 E, City of Delavan, Walworth County, Wisconsin, described as
follows: Commencing at a point where the west line of Beloit
Street intersects the south line of Washington Street; thence
southwesterly along the west side of Beloit Street 141 feet to
the place of beginning; thence west parallel with the south line
of Washington Street 125 feet; thence southwesterly parallel
with the west line of Beloit Street 20.18 feet; thence S76°24' E
115.86 feet to the west line of Beloit Street; thence northeasterly
along the west line of Beloit Street 50.00 feet to the place of
beginning.

and that the plat shown hereon is a correct representation thereof and shows
the size and location of the property, its exterior boundaries, the location
of all visible structures and dimensions of all principal buildings thereon,
boundary fences, apparent easements, roadways and visible encroachments, if
any, and that I have surveyed the property hereon described, according to the
official records, to the best of my knowledge and belief.
February 20, 1989

George T. Dunham
George T. Dunham, Surveyor

2-903

