

DUNHAM SURVEYING, S.C.  
SURVEYING & SUBDIVIDING  
DELAVER, WISCONSIN 53115

N



Scale - 1" = 20'

● = Concrete Monument Found


⊙ = 3/4" Iron Pipe Found

○ = 1" Iron Pipe Found

--- = Fence Line

Bearings used are those shown on the recorded plat  
of The Robert L. Shirk Subdivision

Owner: Rod Sickler  
1009 Racine Street  
Delavan, WI 53115

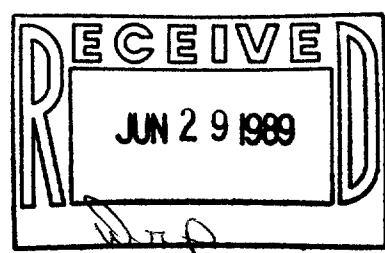

STATE OF WISCONSIN)  
COUNTY OF WALWORTH) ss

I, George T. Dunham, Surveyor, certify that I have surveyed the property  
described as follows:

Lot 7, The Robert L. Shirk Subdivision located in the City of Delavan,  
Walworth County, Wisconsin.

and that the plat shown hereon is a correct representation thereof and shows  
the site and location of the property, its exterior boundaries, the location  
of all visible structures and dimensions of all principal buildings thereon,  
boundary fences, apparent easements, roadways and visible encroachments, if  
any, and that I have surveyed the property hereon described according to the  
official records, to the best of my knowledge and belief.

February 2, 1989

*George T. Dunham*  
George T. Dunham, Surveyor

2-906

