


FIFTH

STREET

WASHINGTON

STREET

N

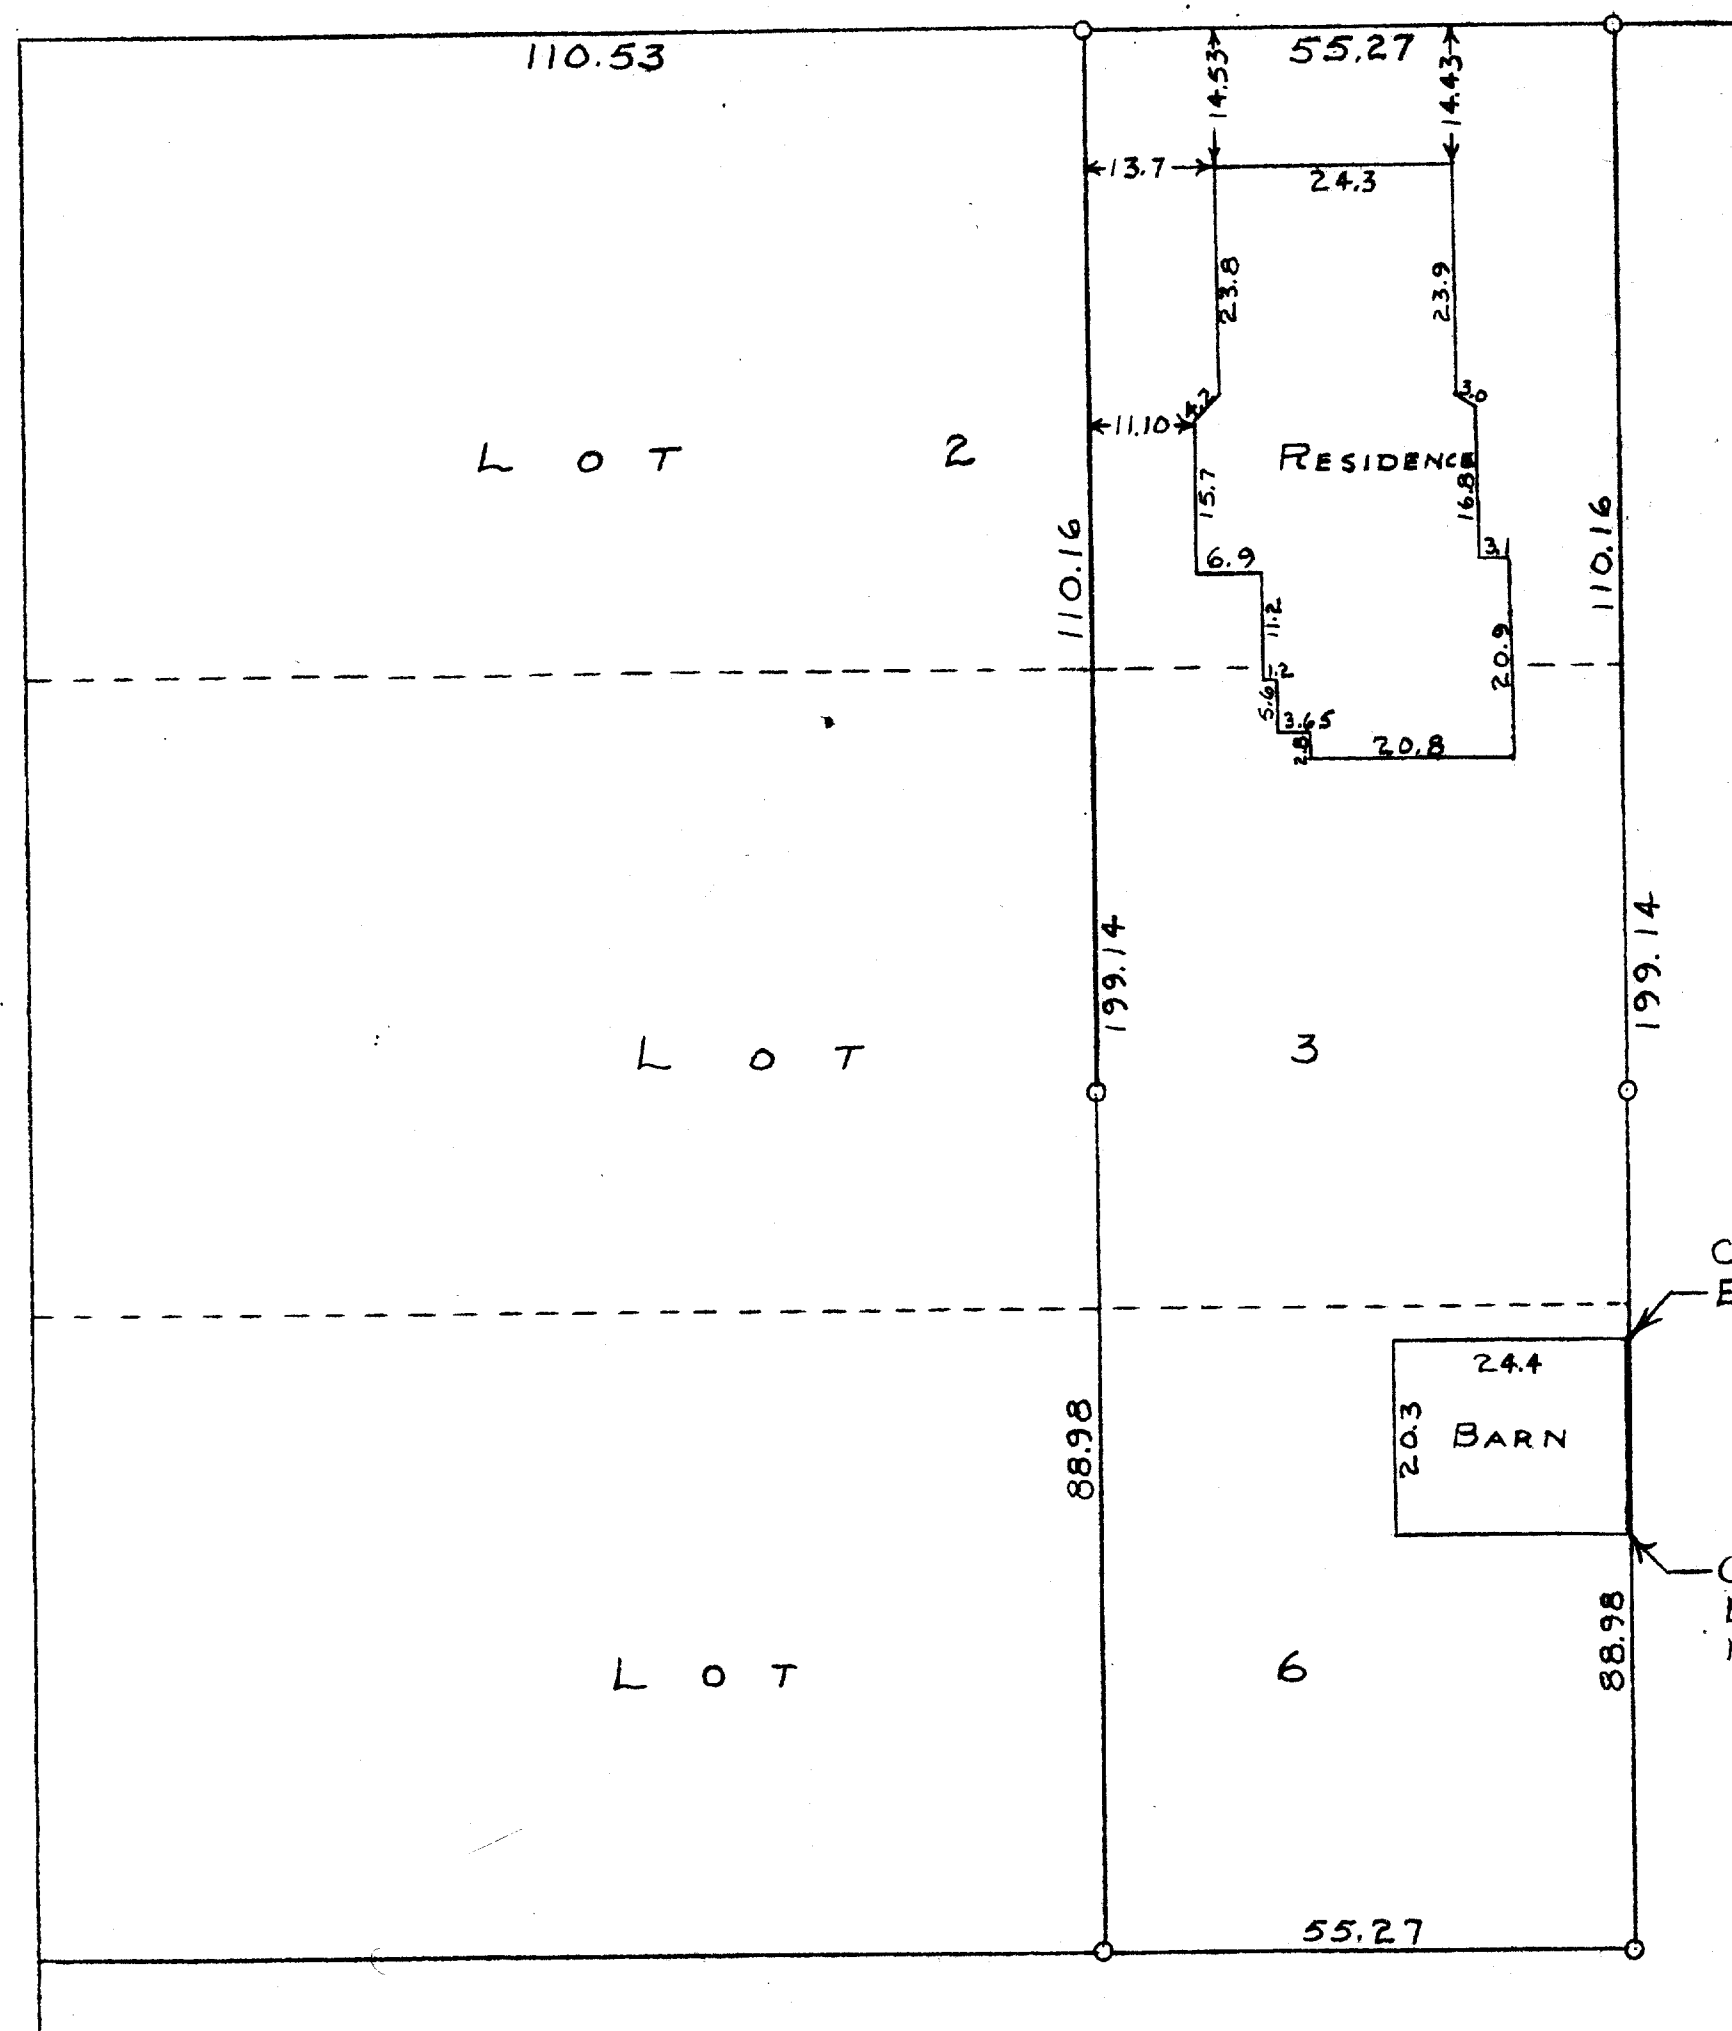

SCALE-1"=20'
0=IRON PIPE

CORNER ON LOT LINE
EAVES 1.48' EAST

CORNER 0.06' WEST OF
LOT LINE. EAVES EXTEND
1.46' EAST

PLAT OF SURVEY OF THE EAST 1/3 OF LOTS 2, 3, AND 6, BLOCK 5
PASSAGE, ARAM, AND DOWNIE ADDITION TO THE CITY OF DELAVAN,
WALWORTH COUNTY, WISCONSIN
DEC. 4, 1957

George T. Dunham
GEORGE T. DUNHAM, SURVEYOR
DELAHAN, WISCONSIN

2-91

VR-72