


DUNHAM SURVEYING, S.C.
 SURVEYING & SUBDIVIDING
 DELAVAN, WISCONSIN 53115

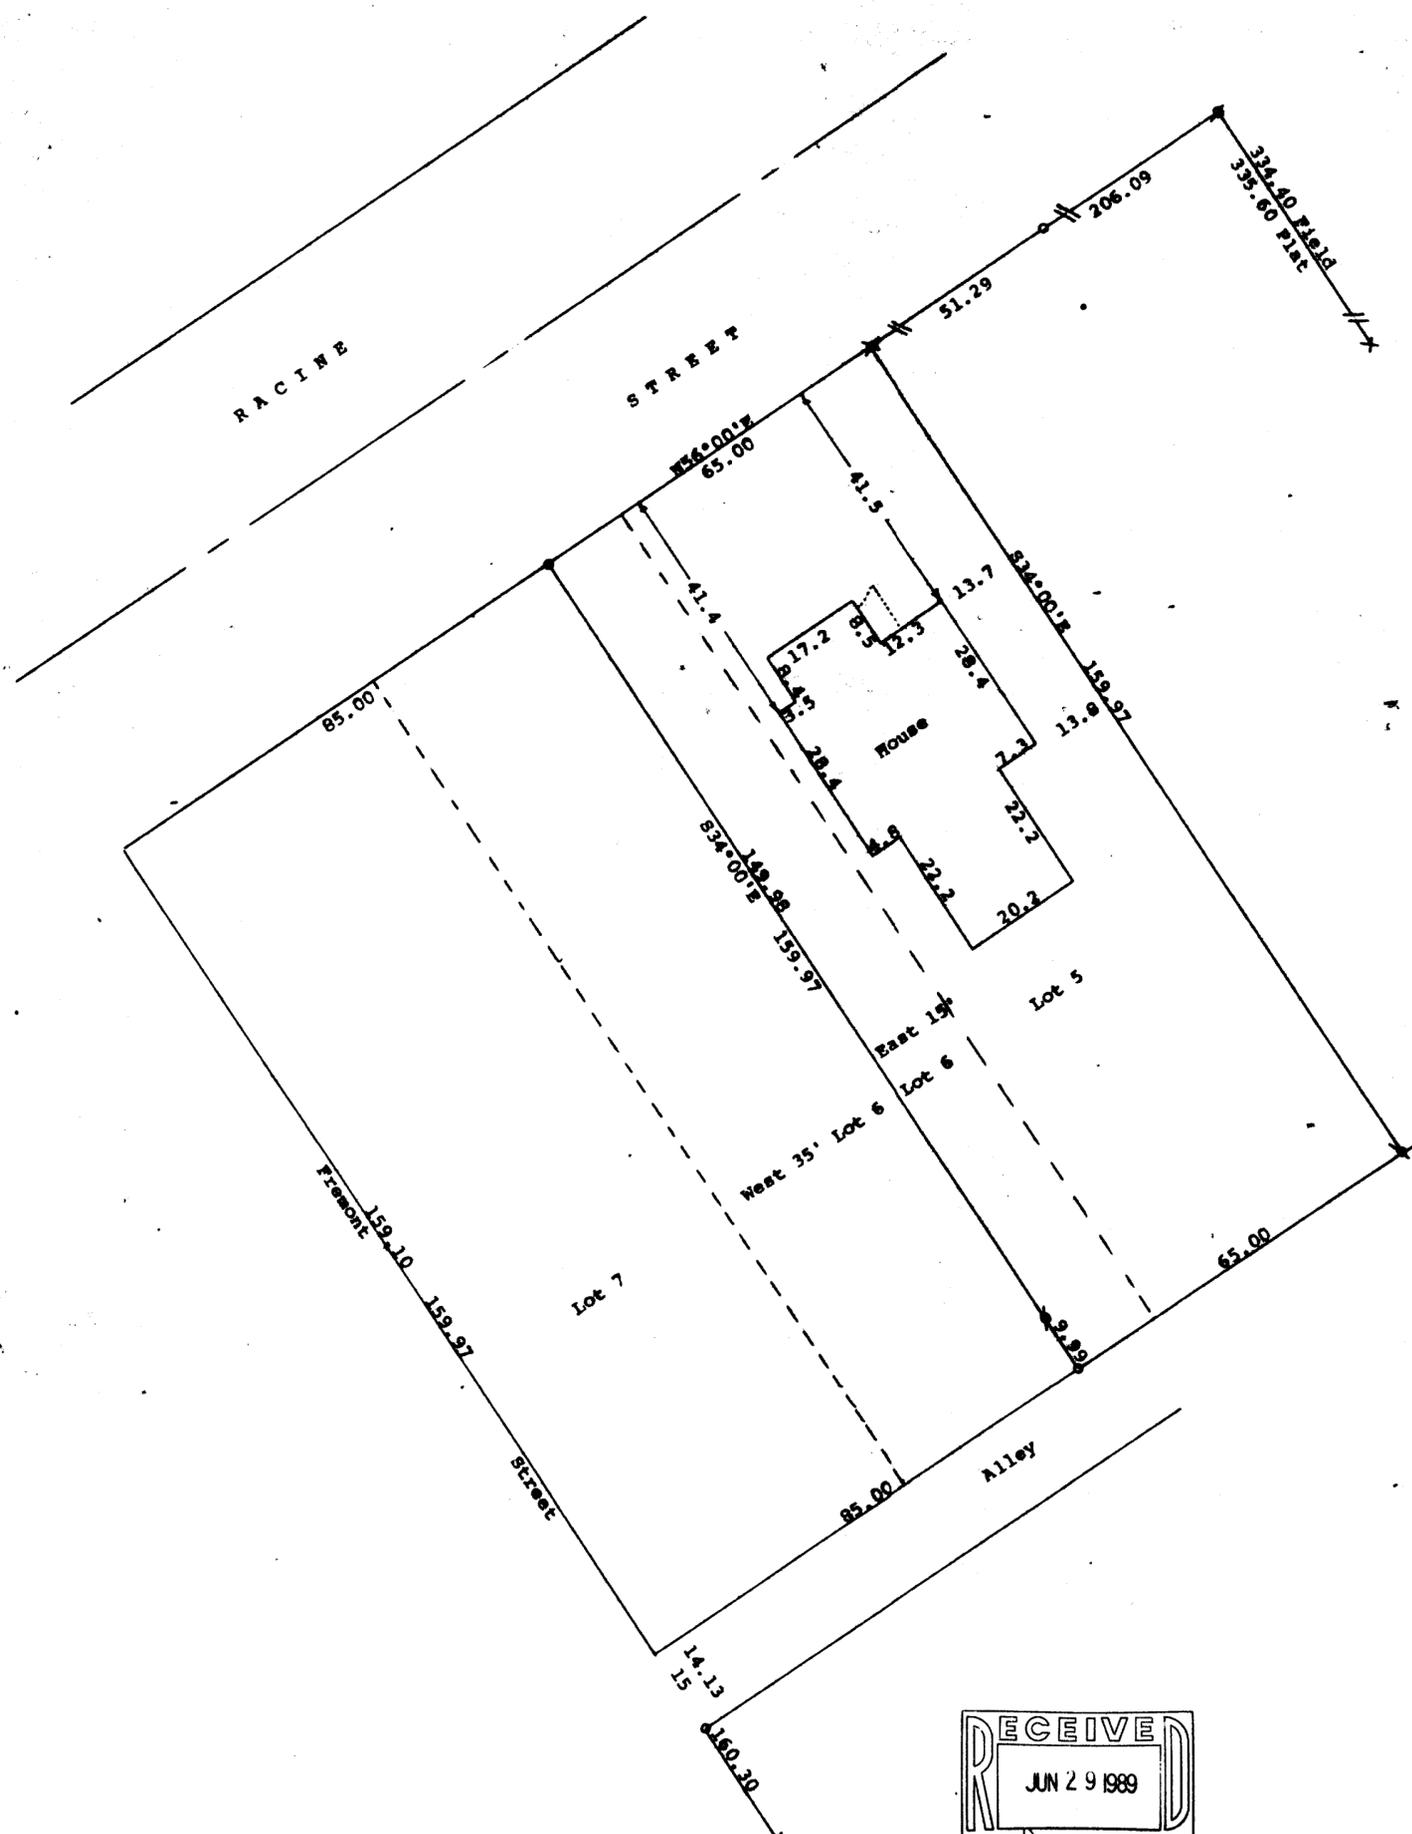


Scale - 1" = 20'

- X = Cross in concrete found
- = 1" Iron Pipe found
- = concrete monument found
- ⊥ = bent 3/4" Iron Pipe found, pulled and reset 1 1/4" X 24" iron pipe
- ⊗ = 3/4" X 10" Iron Pipe Found, reset 1 1/4" X 24" Iron Pipe
- ⊕ = 1 1/4" X 24" Iron Pipe Set
- = 3/4" X 24" Iron Pipe Set

Bearings referenced to the assumed bearing of N56°E along the southerly line of Racine Street

Survey ordered by:
 Dean Anderson, Realtor
 619 Phoenix Street
 Delavan, WI 53115

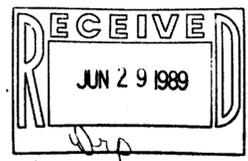

STATE OF WISCONSIN)
 COUNTY OF WALWORTH) SS

I, George T. Dunham, Surveyor, certify that I have surveyed the property described as follows:
 Lot 5 and the easterly 15 feet of Lot 6, all in Block 2 in Converse Subdivision in the City of Delavan, Walworth County, Wisconsin, and that the map shown hereon is a correct representation thereof and shows the size and location of the property, its exterior boundaries, the location of all visible structures and dimensions of all principal buildings thereon, boundary fences, apparent easements, roadways and visible encroachments, if any, and that I have surveyed the property hereon described, according to the official records, to the best of my knowledge and belief.
 June 22, 1989

George T. Dunham
 George T. Dunham, Surveyor.
 2-914

