


FOURTH

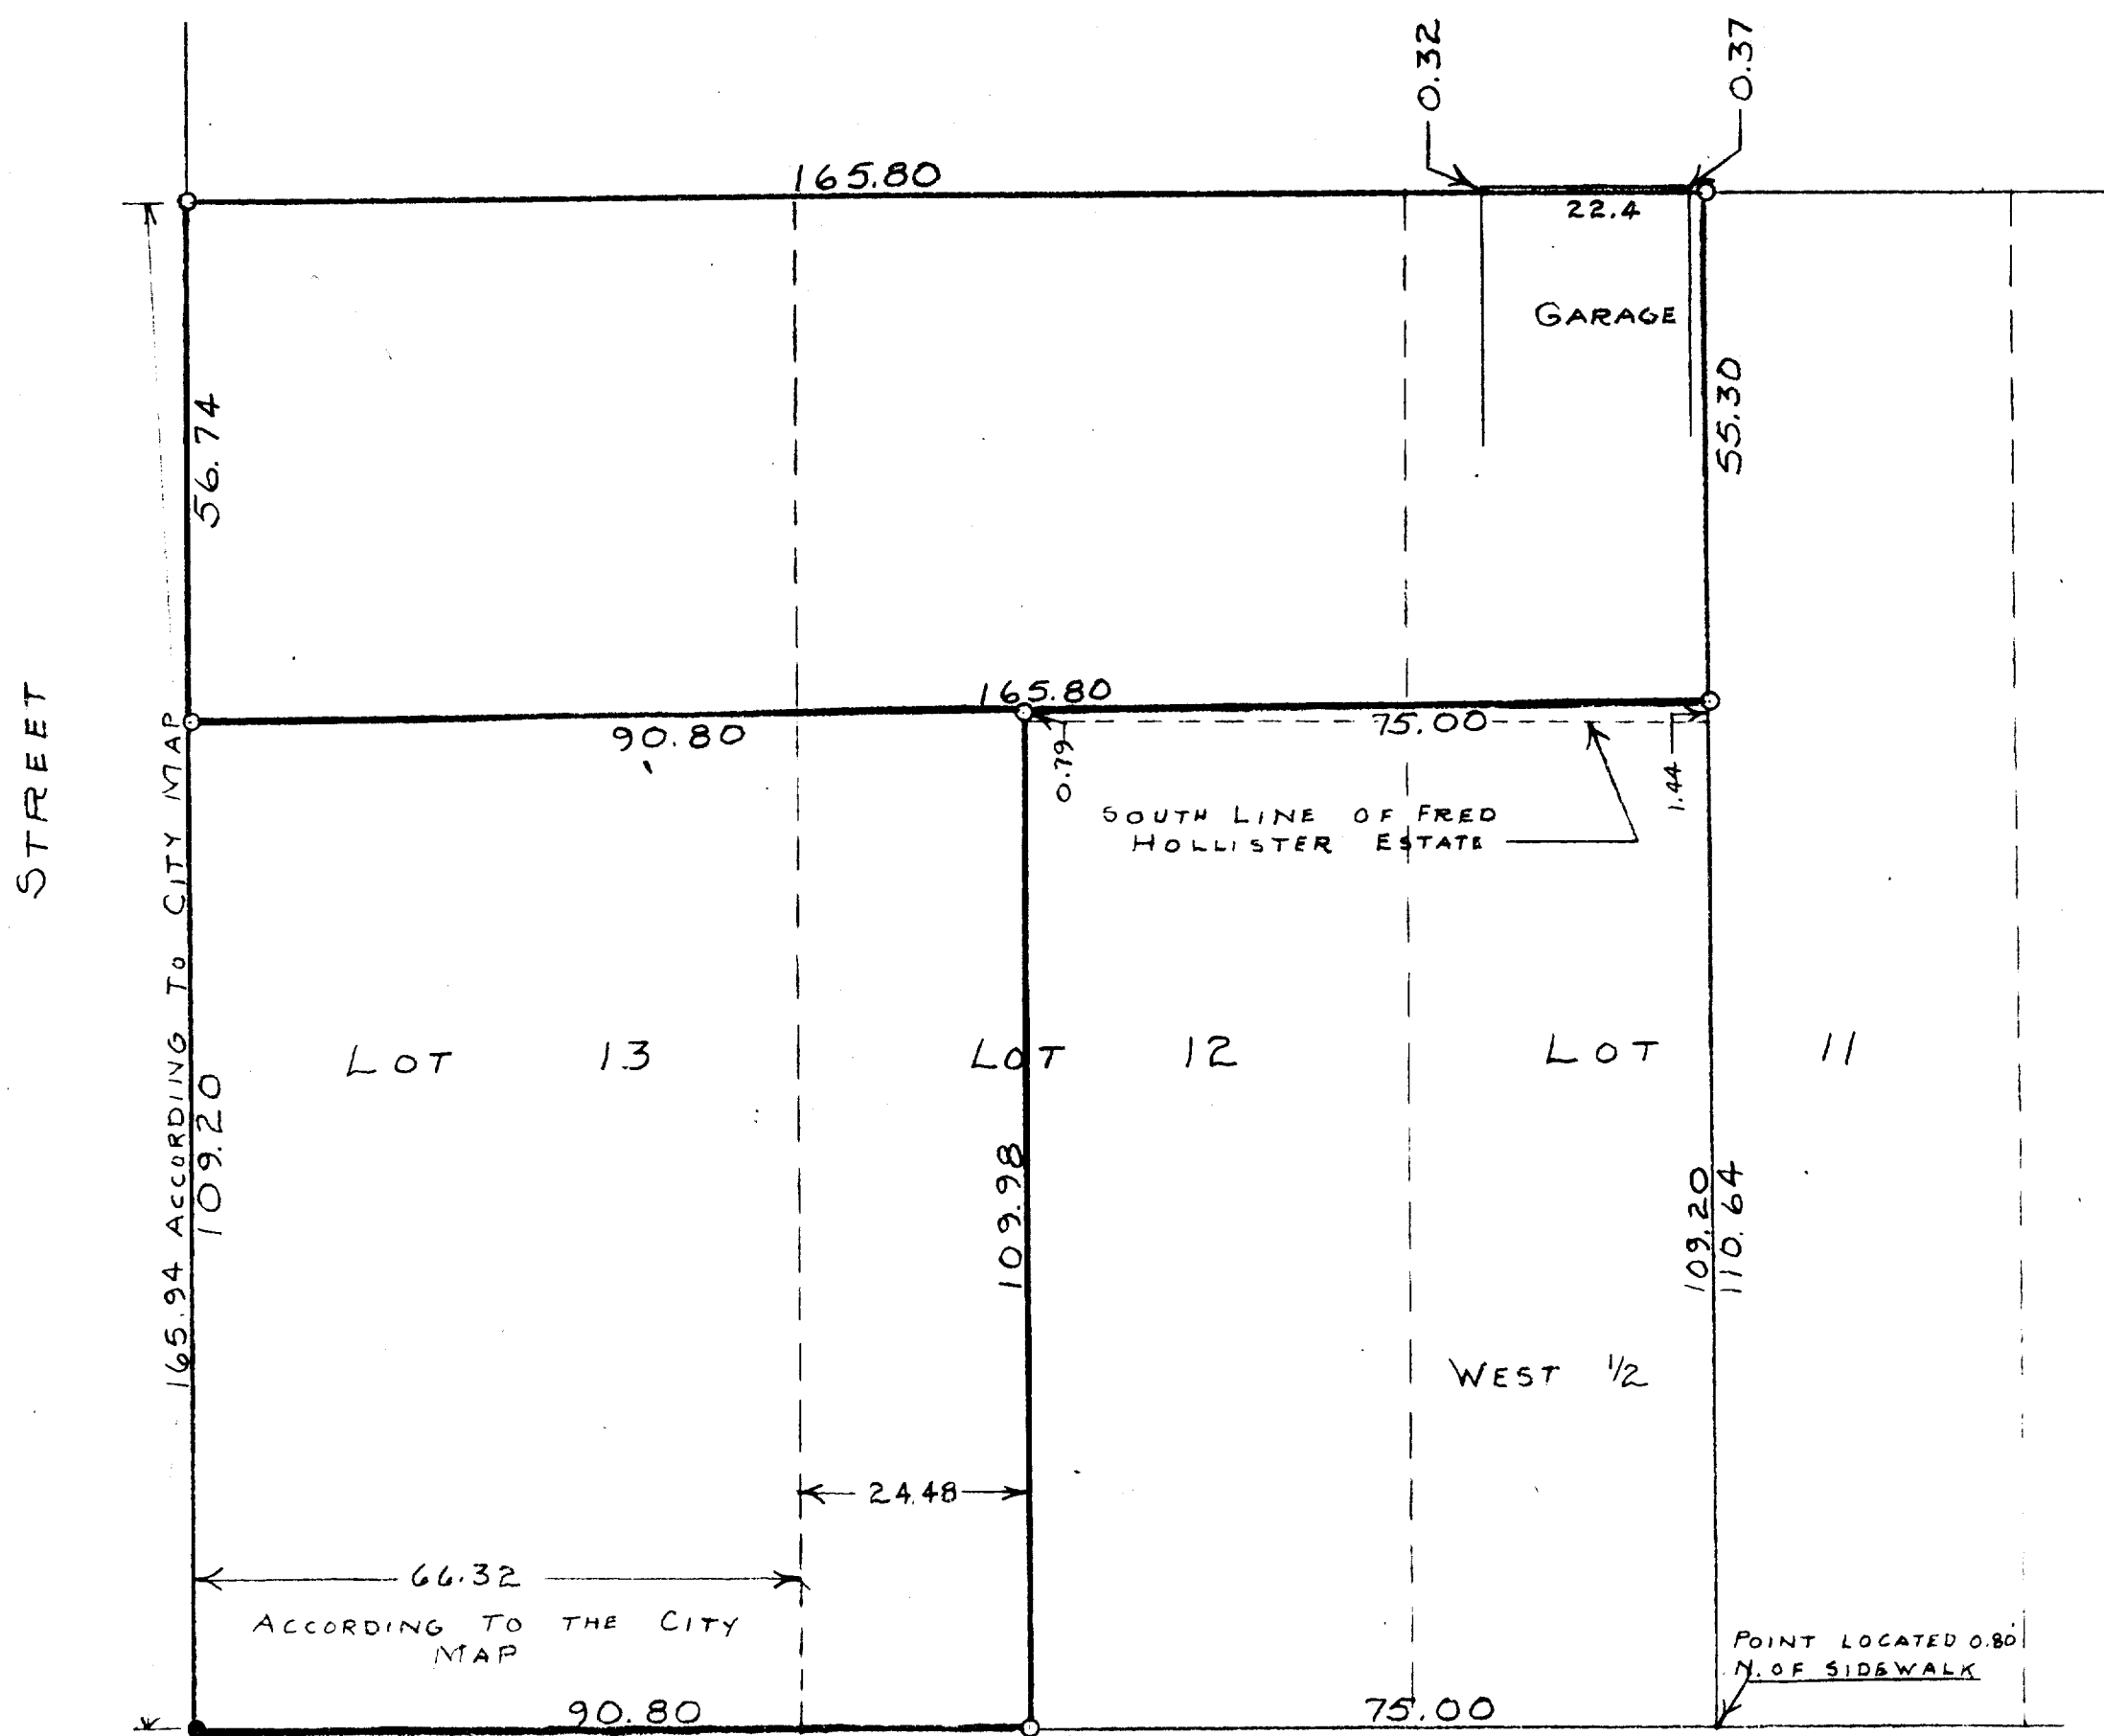

N

SCALE-1"=20'
 0=IRON PIPE
 ●=CONC. MONUMENT

WISCONSIN

STREET

PLAT OF SURVEY OF LAND LOCATED IN LOTS 13, 12, AND THE WEST 1/2 OF LOT 11, BLOCK 2, PASSAGE, ARAM, AND DOWNIE ADDITION TO THE CITY OF DELAVAN, WALWORTH COUNTY, WISCONSIN
 DEC. 23, 1957
 REVISED MARCH 21, 1958

George T. Dunham
 GEORGE T. DUNHAM, SURVEYOR
 DELAVAN, WISCONSIN

STATE OF WISCONSIN)
 WALWORTH COUNTY) ss
 I, GEORGE T. DUNHAM, DO HEREBY CERTIFY THAT I HAVE SURVEYED THE PROPERTY DESCRIBED AS FOLLOWS:
 THE WEST 1/2 OF LOT 11, LOT 12 AND LOT 13, BLOCK 2 OF PASSAGE, ARAM, AND DOWNIE ADDITION TO THE CITY OF DELAVAN, WALWORTH COUNTY, WISCONSIN
 AND THAT THE PLAT SHOWN ABOVE IS A CORRECT REPRESENTATION OF THE PROPERTY LINES
 JUNE 2, 1959

George T. Dunham
 GEORGE T. DUNHAM, SURVEYOR
 DELAVAN, WISCONSIN