


RIM OF MANHOLE 9602
FLOW LINE = 87.00

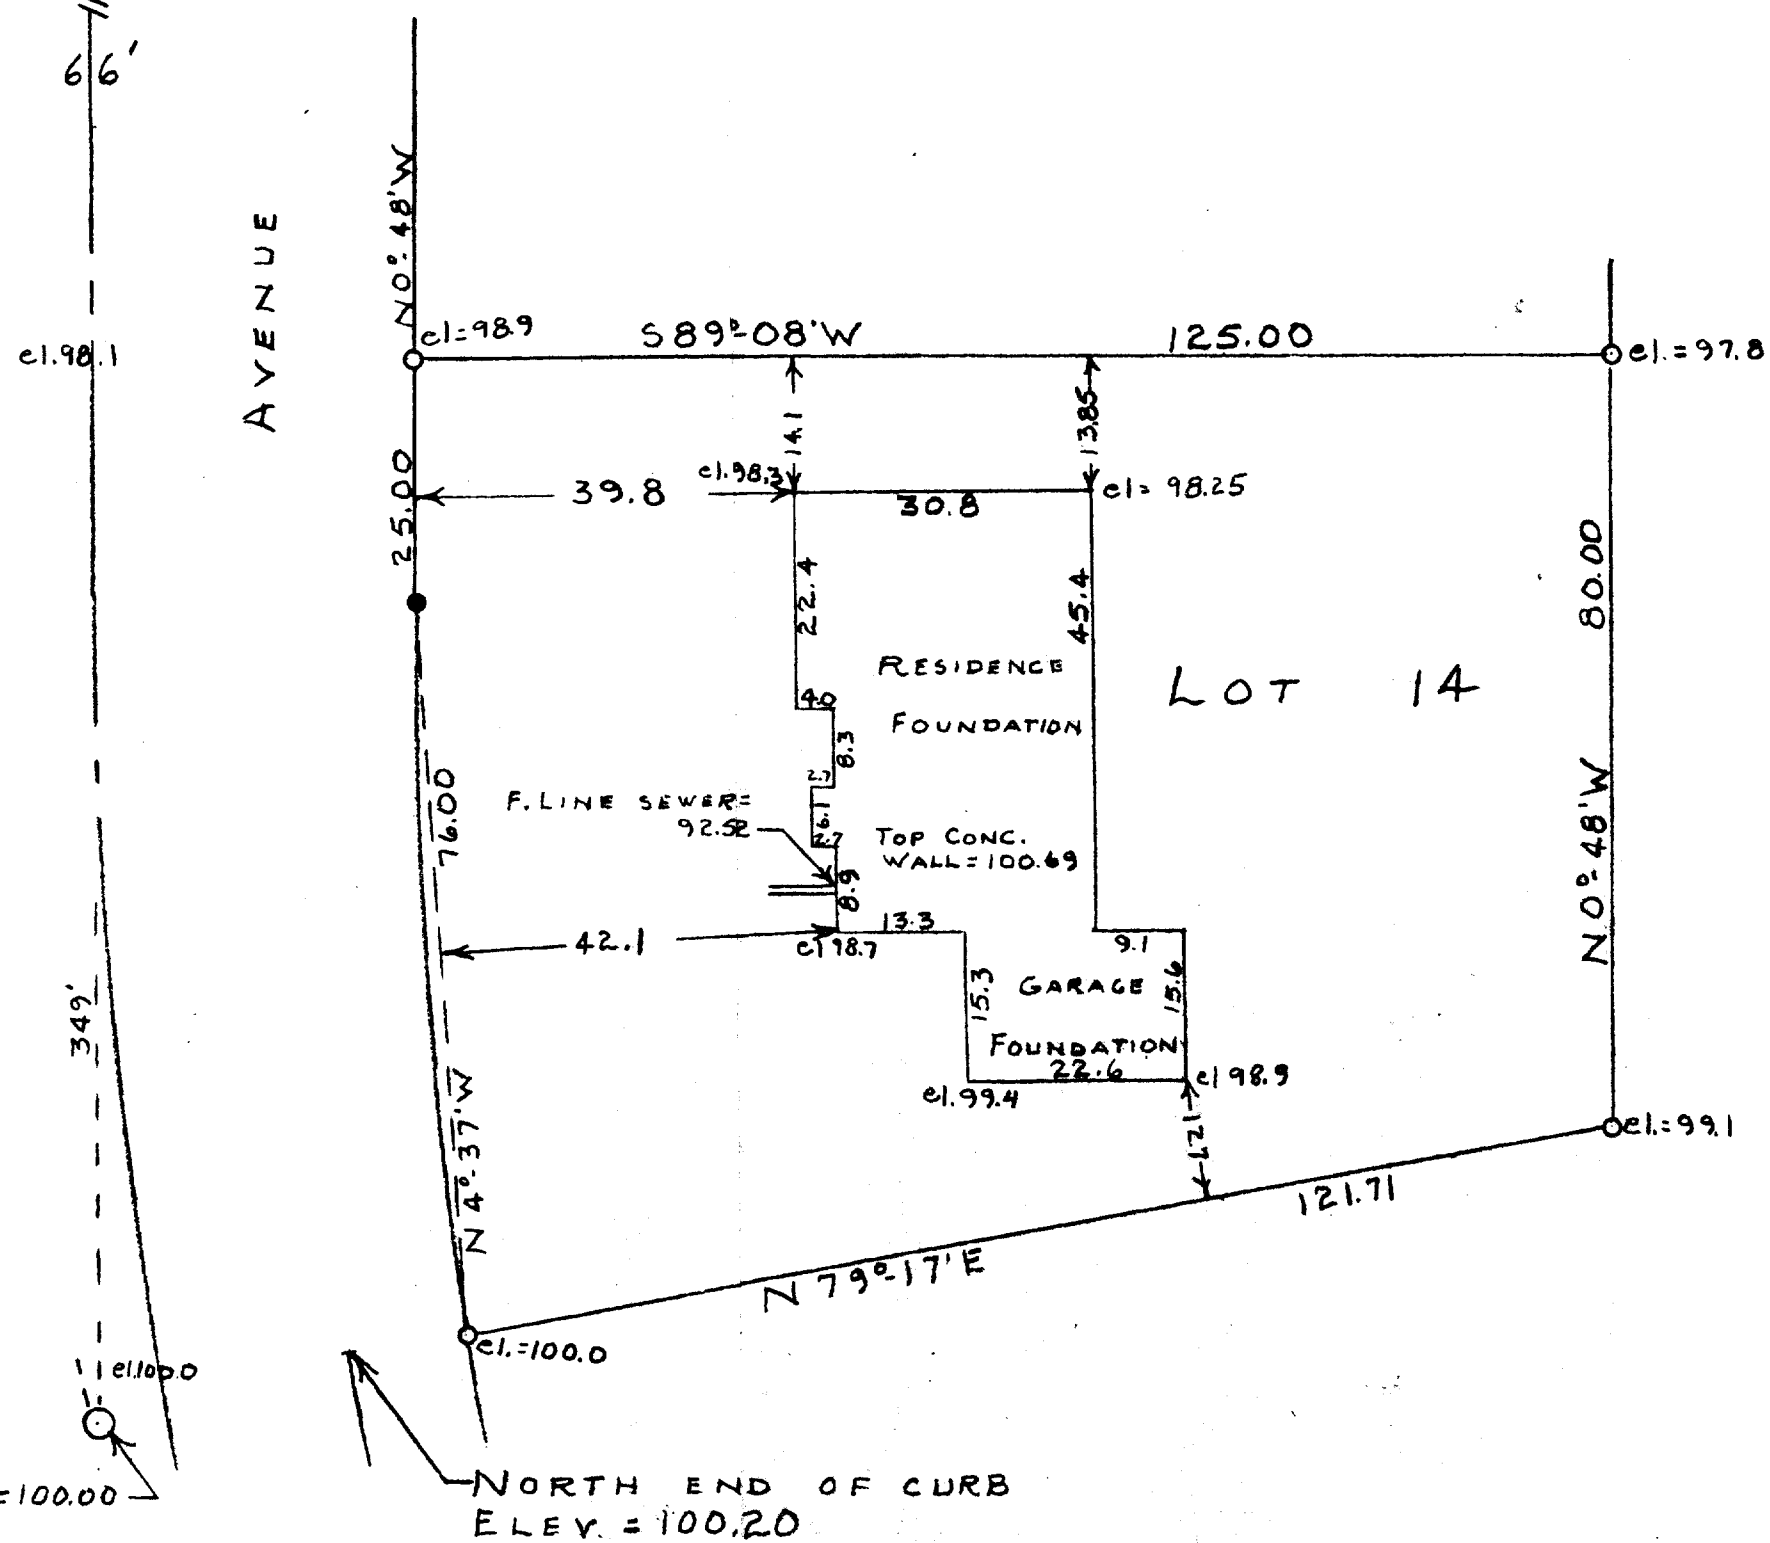

SCALE - 1" = 20'
O = IRON PIPE
● = CONC. MONU.

STATE OF WISCONSIN)
WALWORTH COUNTY)

I, GEORGE T. DUNHAM, DO HEREBY CERTIFY THAT I HAVE
SURVEYED THE PROPERTY DESCRIBED AS FOLLOWS:

LOT 14, BLOCK 3 OF ALLYNHURST SUBDIVISION LOCATED
IN THE CITY OF DELAVAN, WALWORTH COUNTY, WISCONSIN
AND THAT THE PLAT SHOWN ABOVE IS A CORRECT REPRESENTATION
OF THE PROPERTY LINES AND OF THE IMPROVEMENTS LOCATED THEREON.
OCT. 1957

George T. Dunham
GEORGE T. DUNHAM
DELAVAN, WISCONSIN
WIS. LAND SURVEYOR S-306

2-93