


**ABELL
SURVEYING & MAPPING
DELAVER, WISCONSIN 53115
414-728-6787**

ORDERED BY: THE RAULAND AGENCY
118 KENOSHA ST.
WALWORTH, WI. 53184

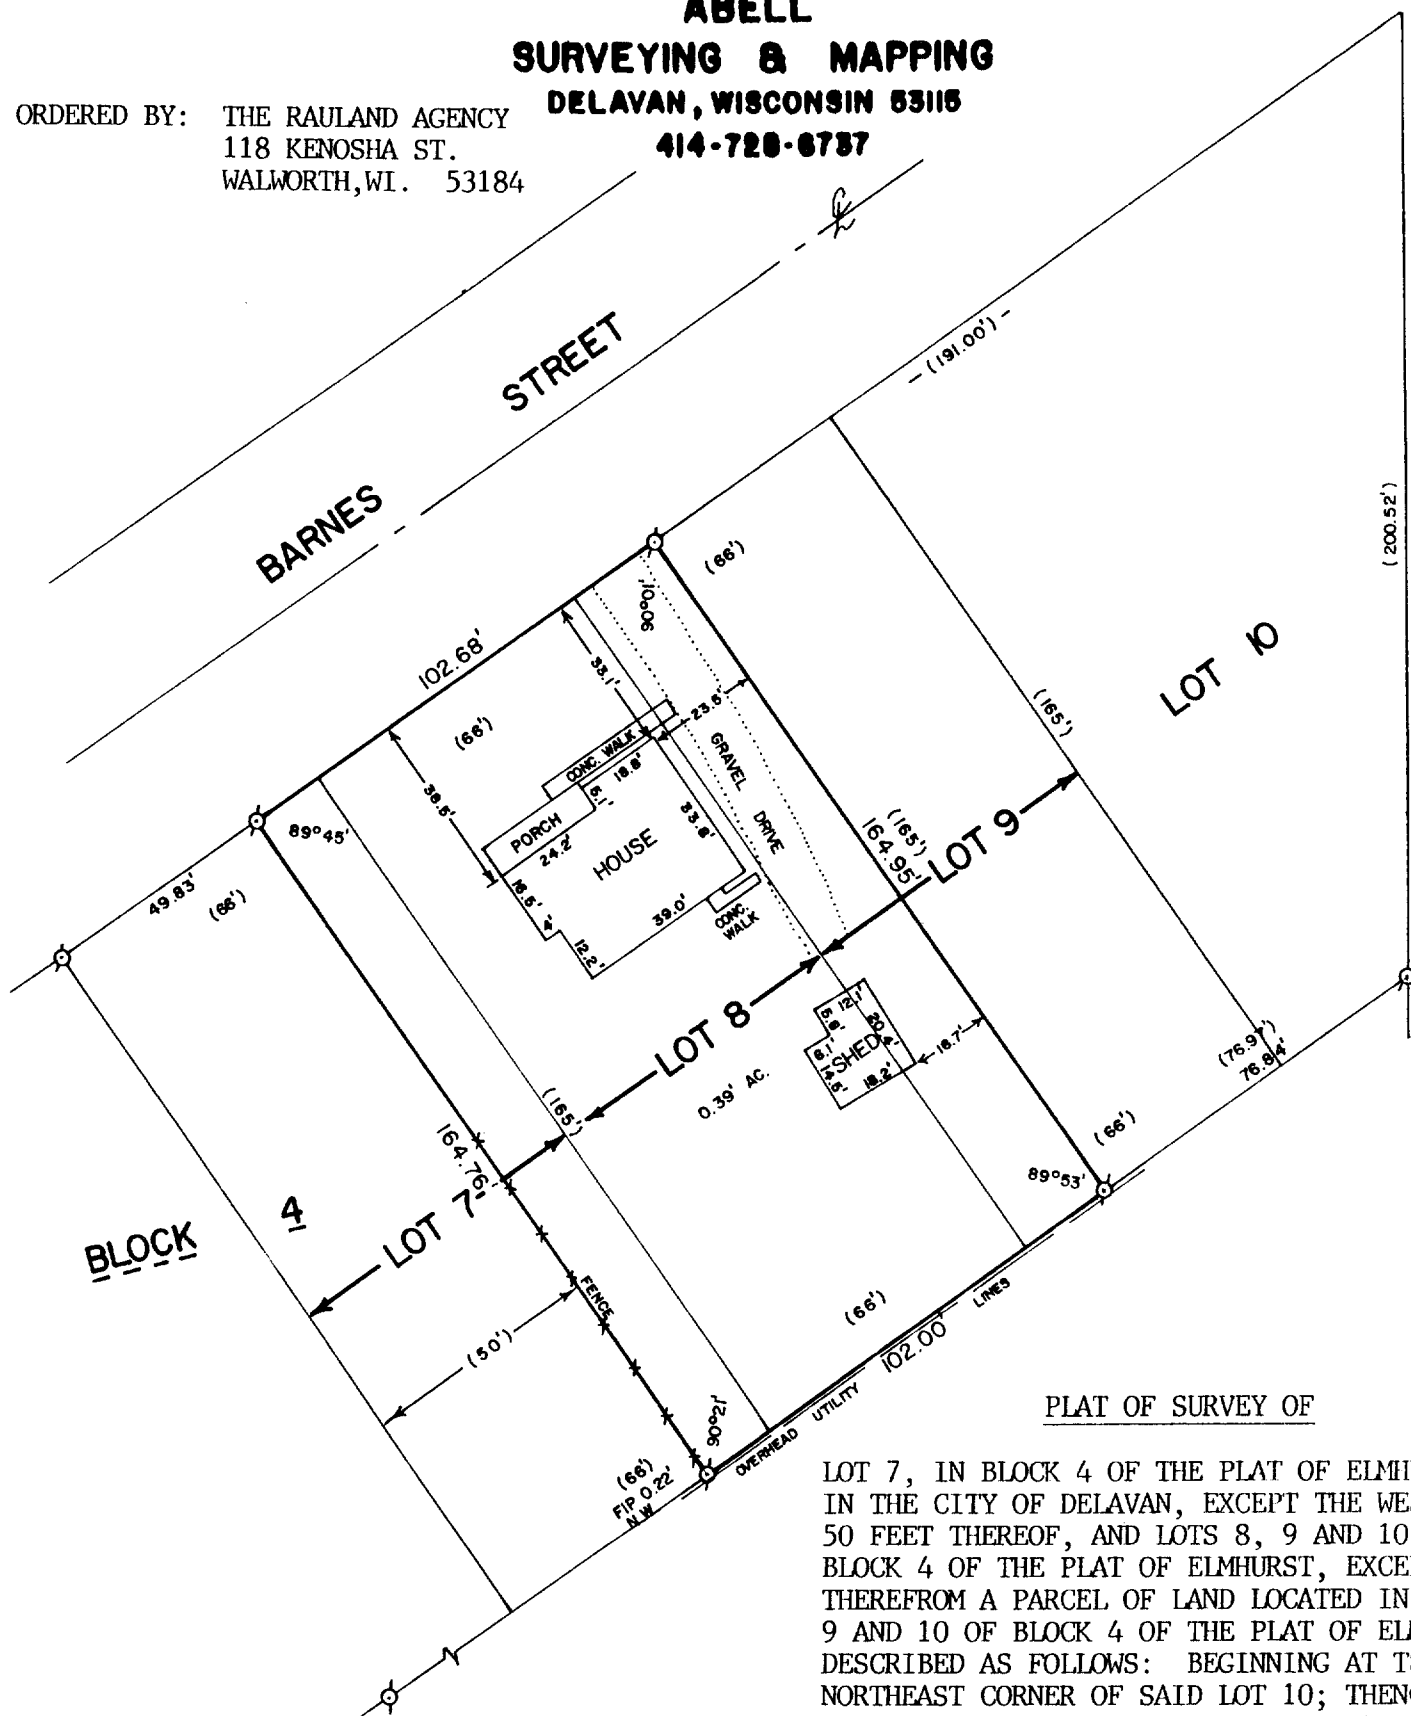

PLAT OF SURVEY OF

LOT 7, IN BLOCK 4 OF THE PLAT OF ELMHURST
IN THE CITY OF DELAVER, EXCEPT THE WEST
50 FEET THEREOF, AND LOTS 8, 9 AND 10 IN
BLOCK 4 OF THE PLAT OF ELMHURST, EXCEPTING
THEREFROM A PARCEL OF LAND LOCATED IN LOTS
9 AND 10 OF THE PLAT OF ELMHURST,
DESCRIBED AS FOLLOWS: BEGINNING AT THE
NORTHEAST CORNER OF SAID LOT 10; THENCE
SOUTHWESTERLY ALONG THE NORTHERLY LINE OF


SAID LOTS 9 AND 10, 191.00 FEET; THENCE SOUTHEASTERLY AT RIGHT ANGLES TO THE NORTHERLY
LINE OF SAID LOTS 9 AND 10, 165.00 FEET; THENCE NORTHEASTERLY ALONG THE SOUTHEASTERLY
LINE OF SAID LOTS 9 AND 10, 76.97 FEET TO THE SOUTHEASTERLY CORNER OF SAID LOT 10;
THENCE NORTH ALONG THE EAST LINE OF SAID LOT 10, 200.52 FEET TO THE PLACE OF BEGINNING.



SCALE - 1"=40'

LEGEND

⊙ - IRON PIPE FOUND
() - RECORDED AS

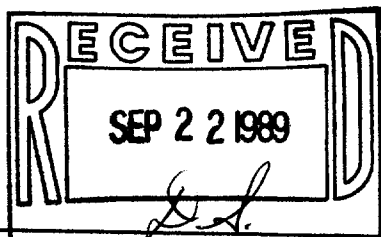

I HEREBY CERTIFY THAT I HAVE SURVEYED THE ABOVE DESCRIBED PROPERTY AND THAT THE
ABOVE MAP IS A TRUE REPRESENTATION THEREOF AND SHOWS THE SIZE AND LOCATION OF
THE PROPERTY, ITS EXTERIOR BOUNDARIES, THE LOCATION OF ALL VISIBLE STRUCTURES
AND DIMENSIONS OF ALL PRINCIPAL BUILDINGS THEREON, BOUNDARY FENCES, APPARENT
EASEMENTS, ROADWAYS AND VISIBLE ENCROACHMENTS, IF ANY, TO THE BEST OF MY
KNOWLEDGE AND BELIEF.

THIS SURVEY IS MADE FOR THE USE OF THE PRESENT OWNERS OF THE PROPERTY, AND ALSO
THOSE WHO PURCHASE, MORTGAGE, OR GUARANTEE THE TITLE THERETO WITHIN ONE (1) YEAR
FROM DATE HEREOF.

David F. Abell

DAVID F. ABELL
WISCONSIN REGISTERED LAND SURVEYOR, S-1596

DATE *August 19, 1989* JOB NUMBER - 89172
NOTE: THIS IS NOT A CERTIFIED COPY UNLESS SEALED.