


N

SCALE ~ 1" = 20'
 O ~ IRON PIPE
 ● ~ CONC. MON

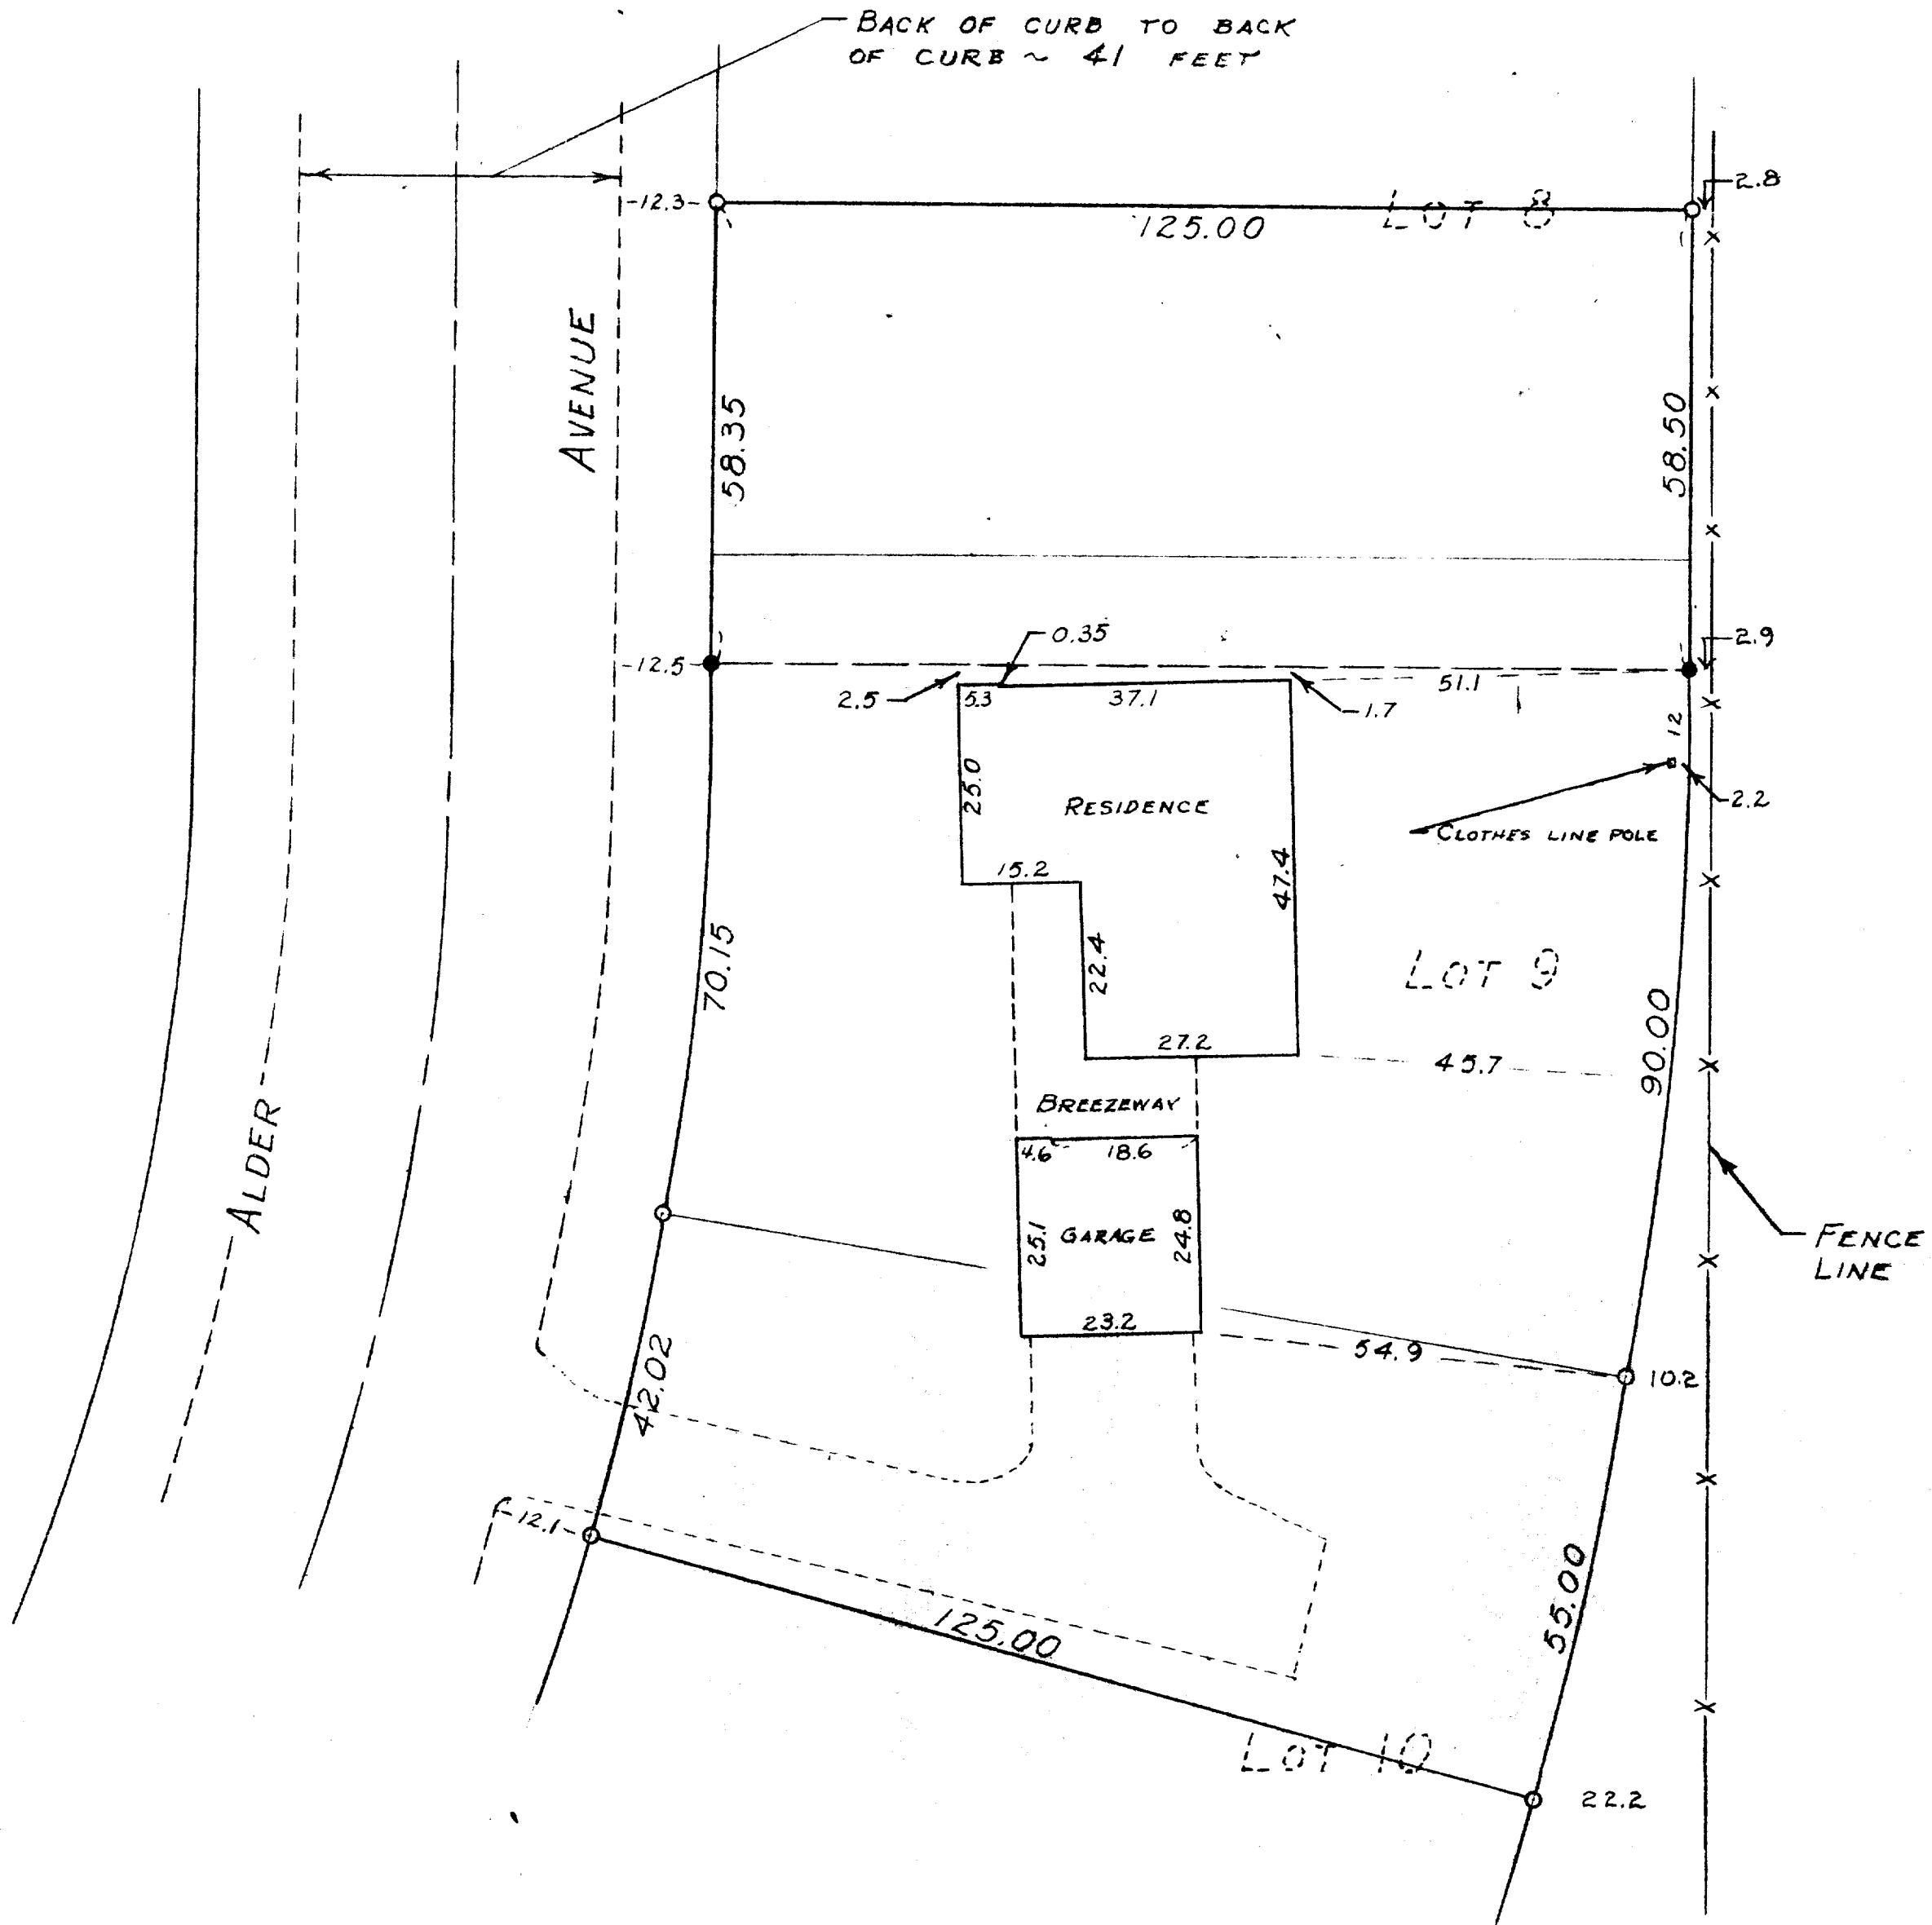

PLAT OF SURVEY OF THE SOUTH 1/2 OF LOT 8, LOT 9 AND THE NORTHERLY 1/2 OF LOT 10, BLOCK 2 OF ALLYNHURST SUBDIVISION LOCATED IN THE CITY OF DELAVAN, WALWORTH COUNTY, WISCONSIN, JUNE, 1958

George T. Dunham
 GEORGE T. DUNHAM, SURVEYOR
 DELAVAN, WISCONSIN

2-95

XAS-16