


**ABELL
SURVEYING & MAPPING
DELAVAN, WISCONSIN 53115
414-728-6737
LOT 81**

TURTLE CREEK DRIVE

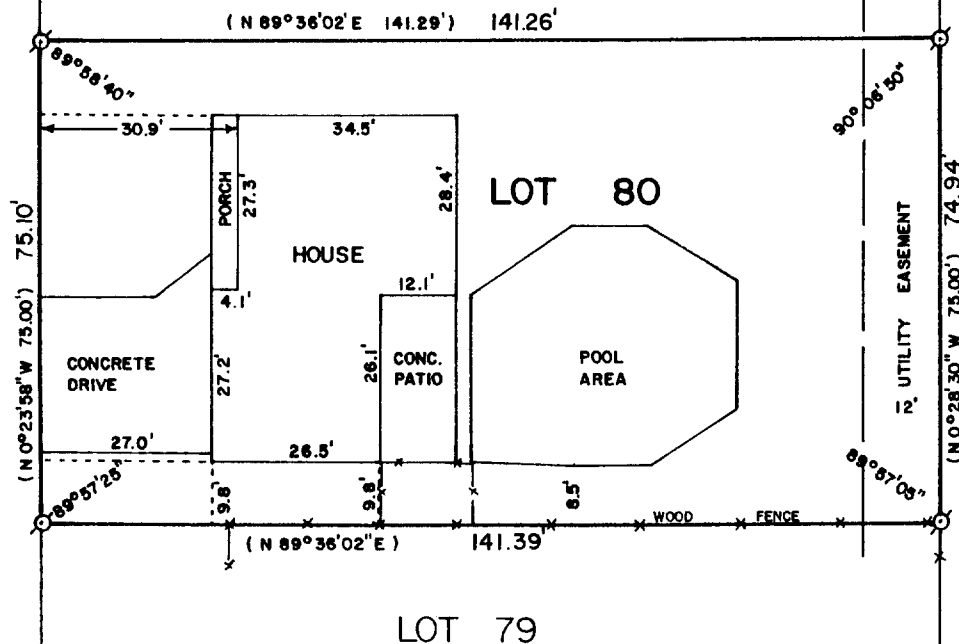


PLAT OF SURVEY OF

LOT 80 OF TURTLE CREEK SUBDIVISION, LOCATED
IN THE SOUTHWEST 1/4 OF THE SOUTHEAST 1/4 OF
SECTION 13, T2N, R15E, CITY OF DELAVAN, WALWORTH
COUNTY, WISCONSIN.

ORDERED BY: CENTURY 21 - SKANDIA REALTY
312 S. 7th STREET
DELAVAN, WI. 53115

REVISED: JAN. 2, 1990
ORDERED BY: COLDWELL BANKER
RT. 5, BOX 5
ELKHORN, WI. 53121

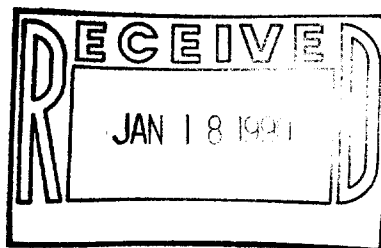

SCALE - 1"=30'

LEGEND

⊙ - IRON PIPE FOUND
() - RECORDED AS

I, DAVID F. ABELL, DO HEREBY CERTIFY
THAT I HAVE SURVEYED THE PROPERTY
HEREON DESCRIBED ACCORDING TO THE
OFFICIAL RECORDS AND THAT THE PLAT
HEREON IS A CORRECT REPRESENTATION
OF THE PROPERTY LINES TO THE BEST OF
MY KNOWLEDGE AND BELIEF.

David F. Abell
DAVID F. ABELL
WISCONSIN REGISTERED LAND SURVEYOR, S-1596

March 14, 1988
DATE JOB NUMBER - 88031

NOTE: THIS IS NOT A CERTIFIED COPY UNLESS SEALED.

XTC-80