


**ABELL
SURVEYING & MAPPING
DELAVAN, WISCONSIN 53115
414-728-6737**


COTTONWOOD STREET

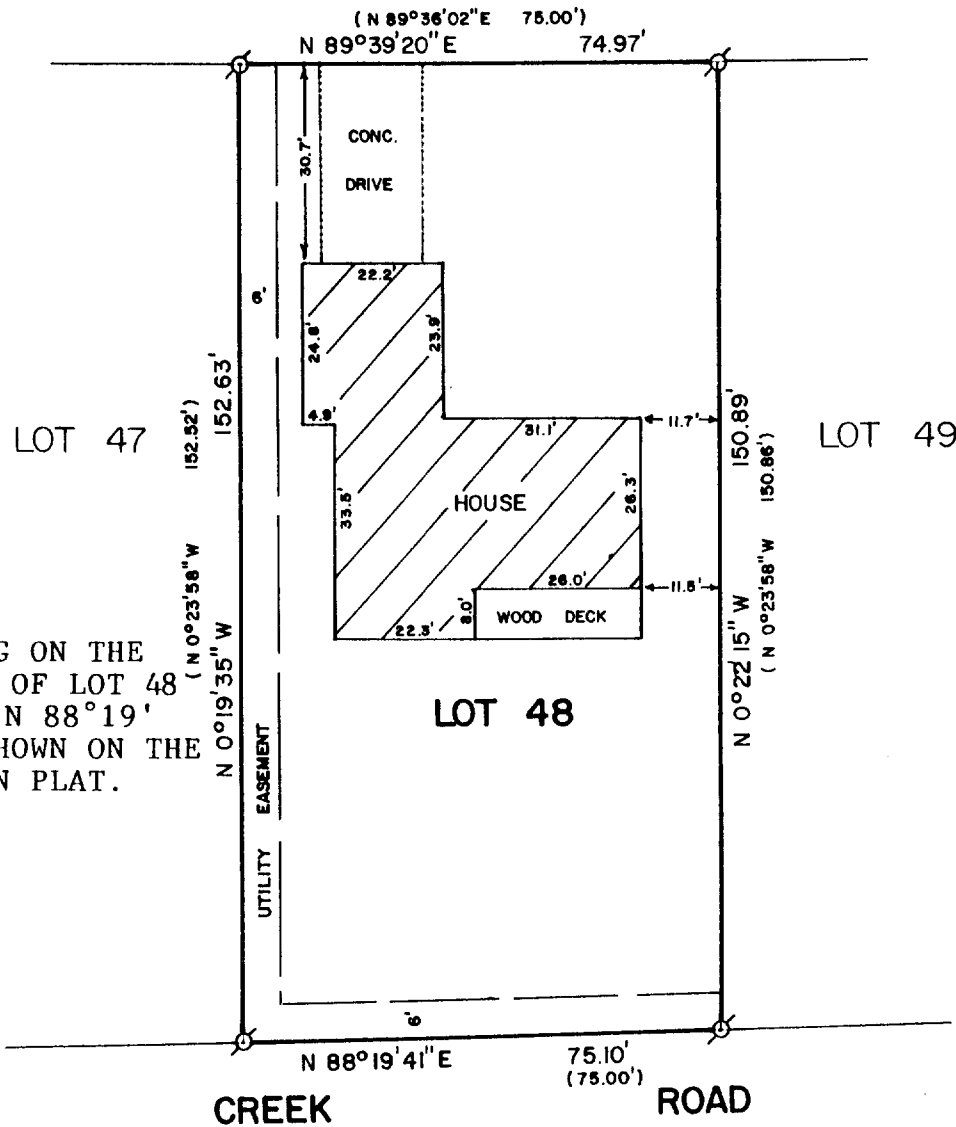

NOTE: THE BEARING ON THE SOUTH LINE OF LOT 48 IS ASSUMED N 88°19' 41" E AS SHOWN ON THE SUBDIVISION PLAT.

PLAT OF SURVEY OF

LOT 48 OF TURTLE CREEK SUBDIVISION, LOCATED IN THE CITY OF DELAVAN, WALWORTH COUNTY, WISCONSIN.

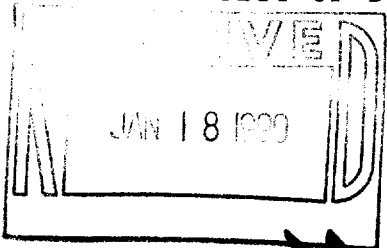

ORDERED BY: JAMES M. HART
1130 COTTONWOOD ST.
DELAVAN, WI. 53115

I, DAVID F. ABELL, DO HEREBY CERTIFY THAT I HAVE SURVEYED THE PROPERTY HEREON DESCRIBED ACCORDING TO THE OFFICIAL RECORDS AND THAT THE PLAT HEREON IS A CORRECT REPRESENTATION OF THE PROPERTY LINES TO THE BEST OF MY KNOWLEDGE AND BELIEF.

David F. Abell

DAVID F. ABELL
WISCONSIN REGISTERED LAND SURVEYOR, S-1596

October 10, 1989

DATE JOB NUMBER - 89219

NOTE: THIS IS NOT A CERTIFIED COPY UNLESS SEALED.

SCALE - 1"=30'

LEGEND

Ø - IRON PIPE FOUND
() - RECORDED AS

XTC - 48

C - DELAVAN