


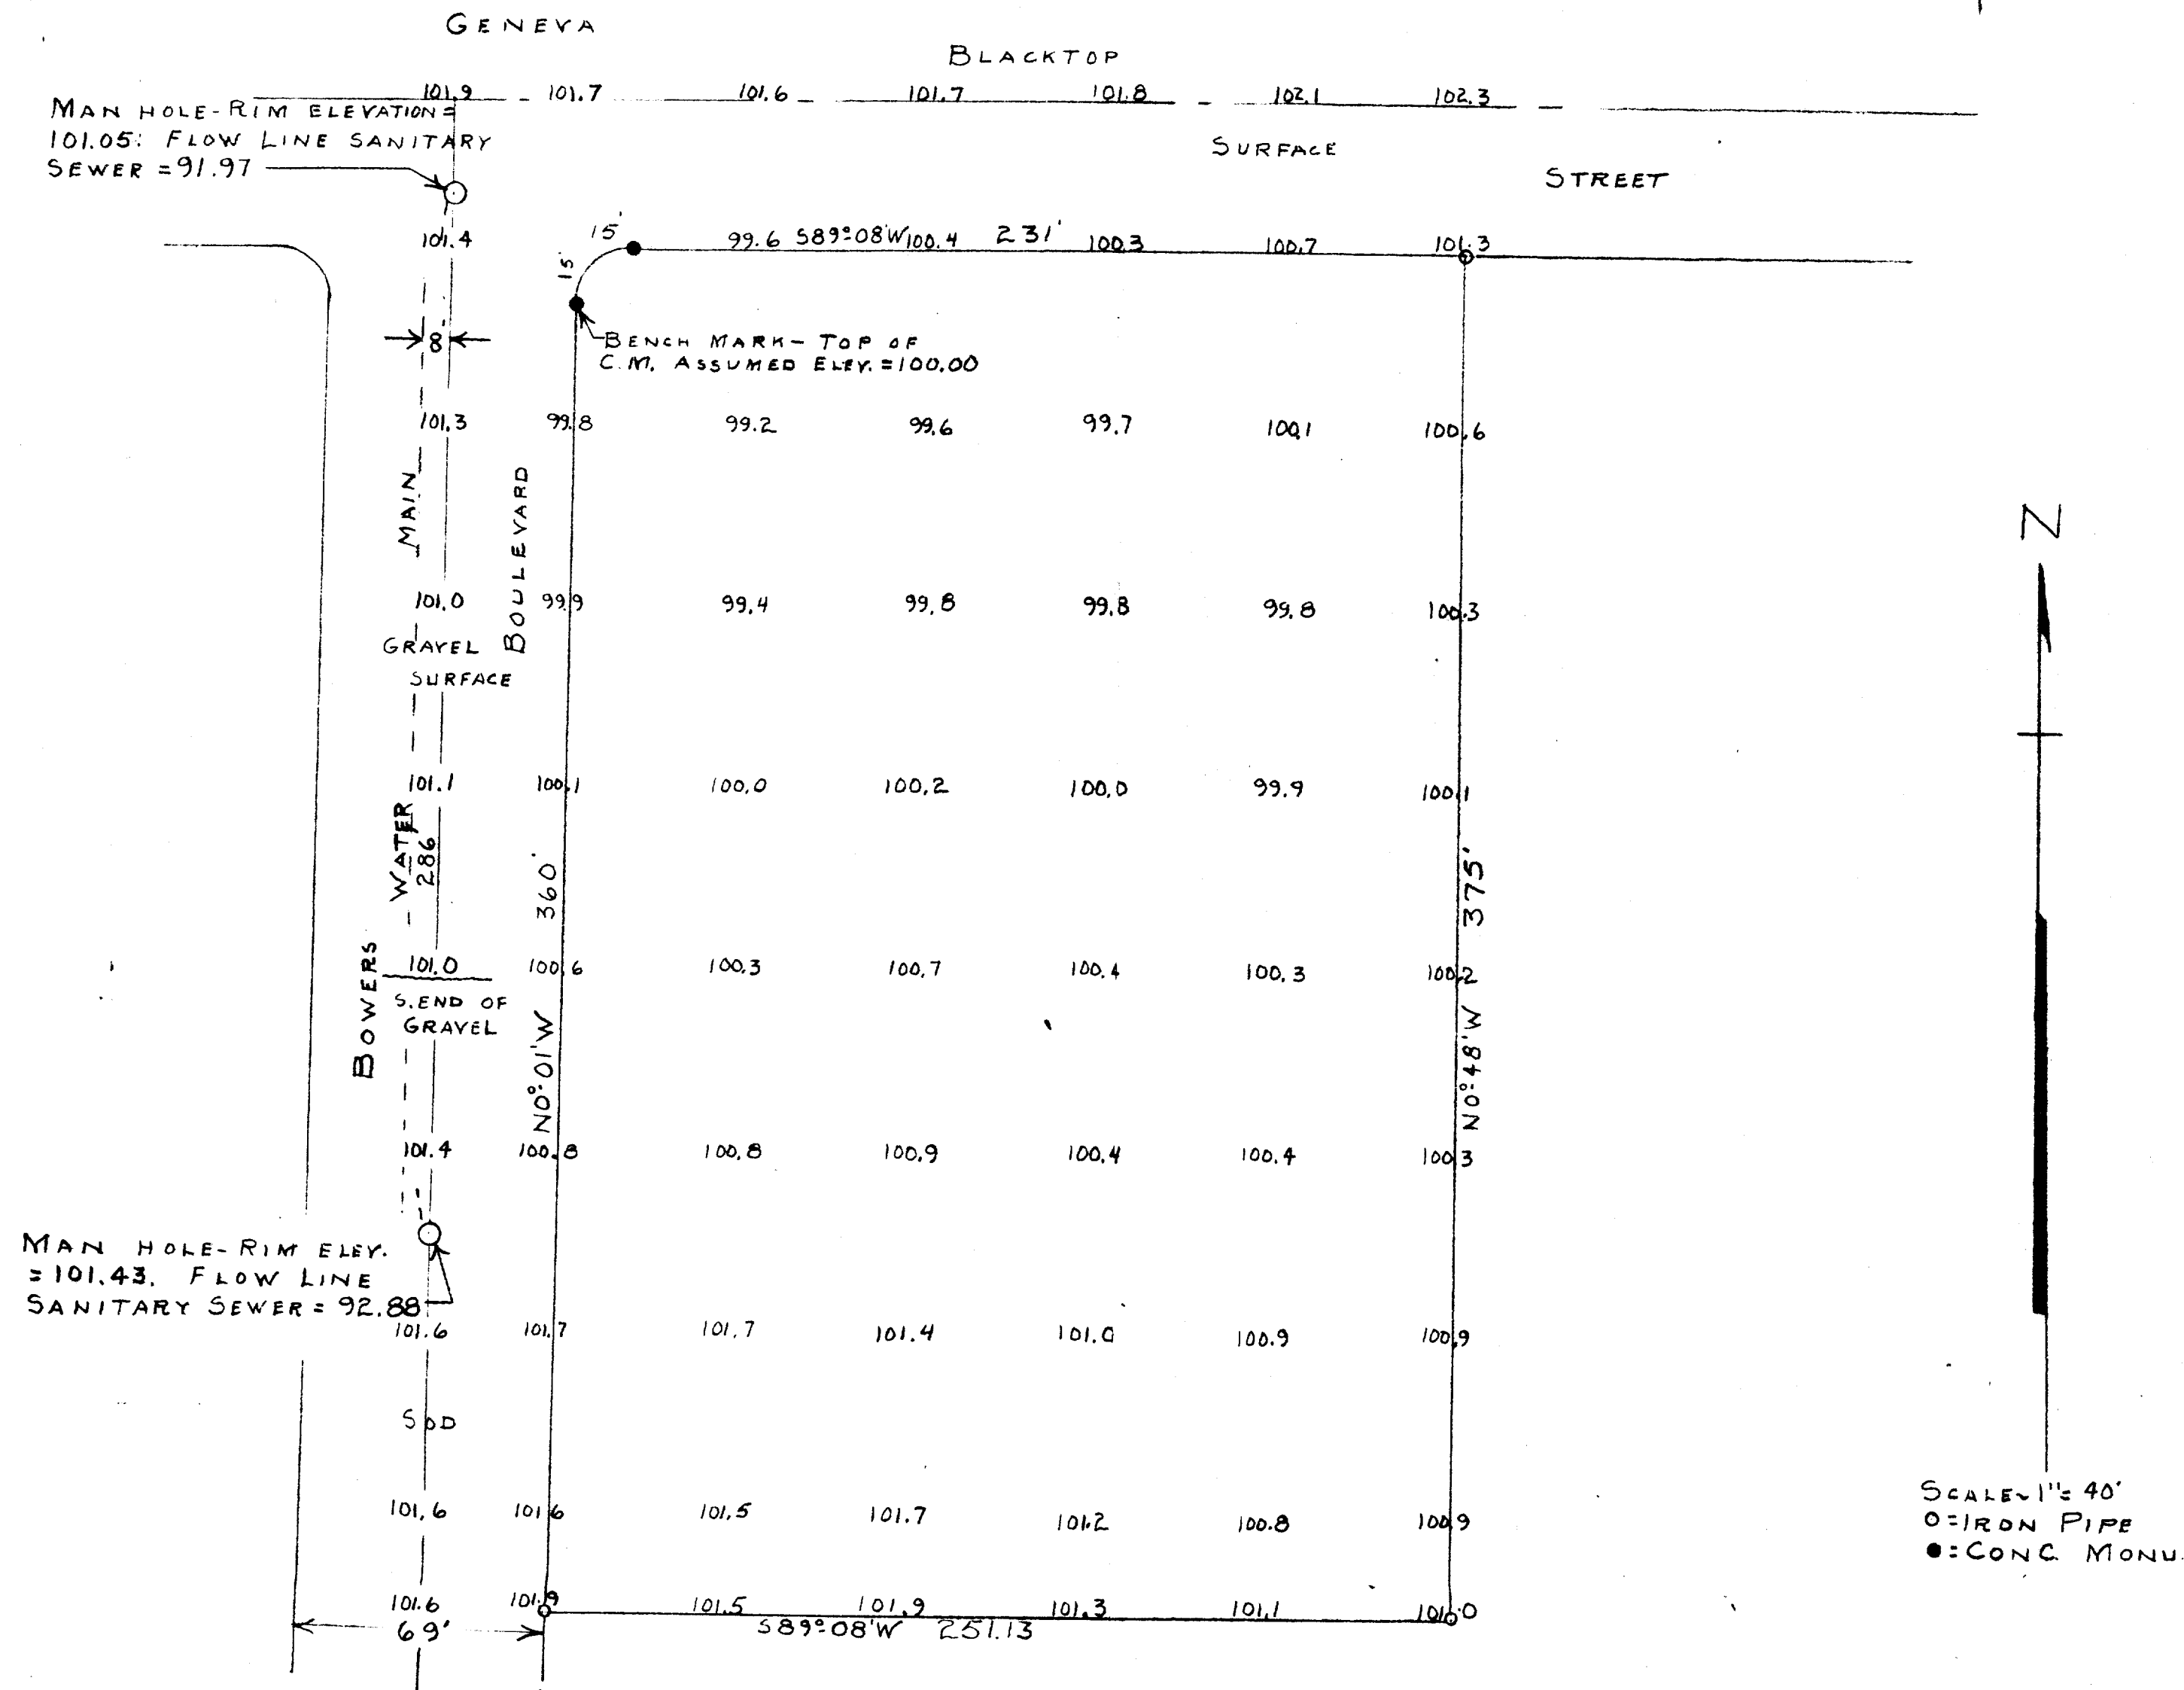

NOTE: NO ESTABLISHED GRADES FOR BOWERS BOULEVARD. CITY ENGINEER STATES THAT CURB WILL PROBABLY BE 0.25' ABOVE RIM OF MANHOLE

PLAT SHOWING PRESENT ELEVATIONS ON A PARCEL OF
LAND LOCATED IN BLOCK 9 OF ALLYNHURST SUBDIVISION
CITY OF DELAVAN, WALWORTH COUNTY, WISCONSIN
OCT. 1957

George T. Dunham
GEORGE T. DUNHAM, SURVEYOR
DELAN, WISCONSIN