



ABELL
SURVEYING & MAPPING
 DELAVAN, WISCONSIN 53115
 414-728-6787

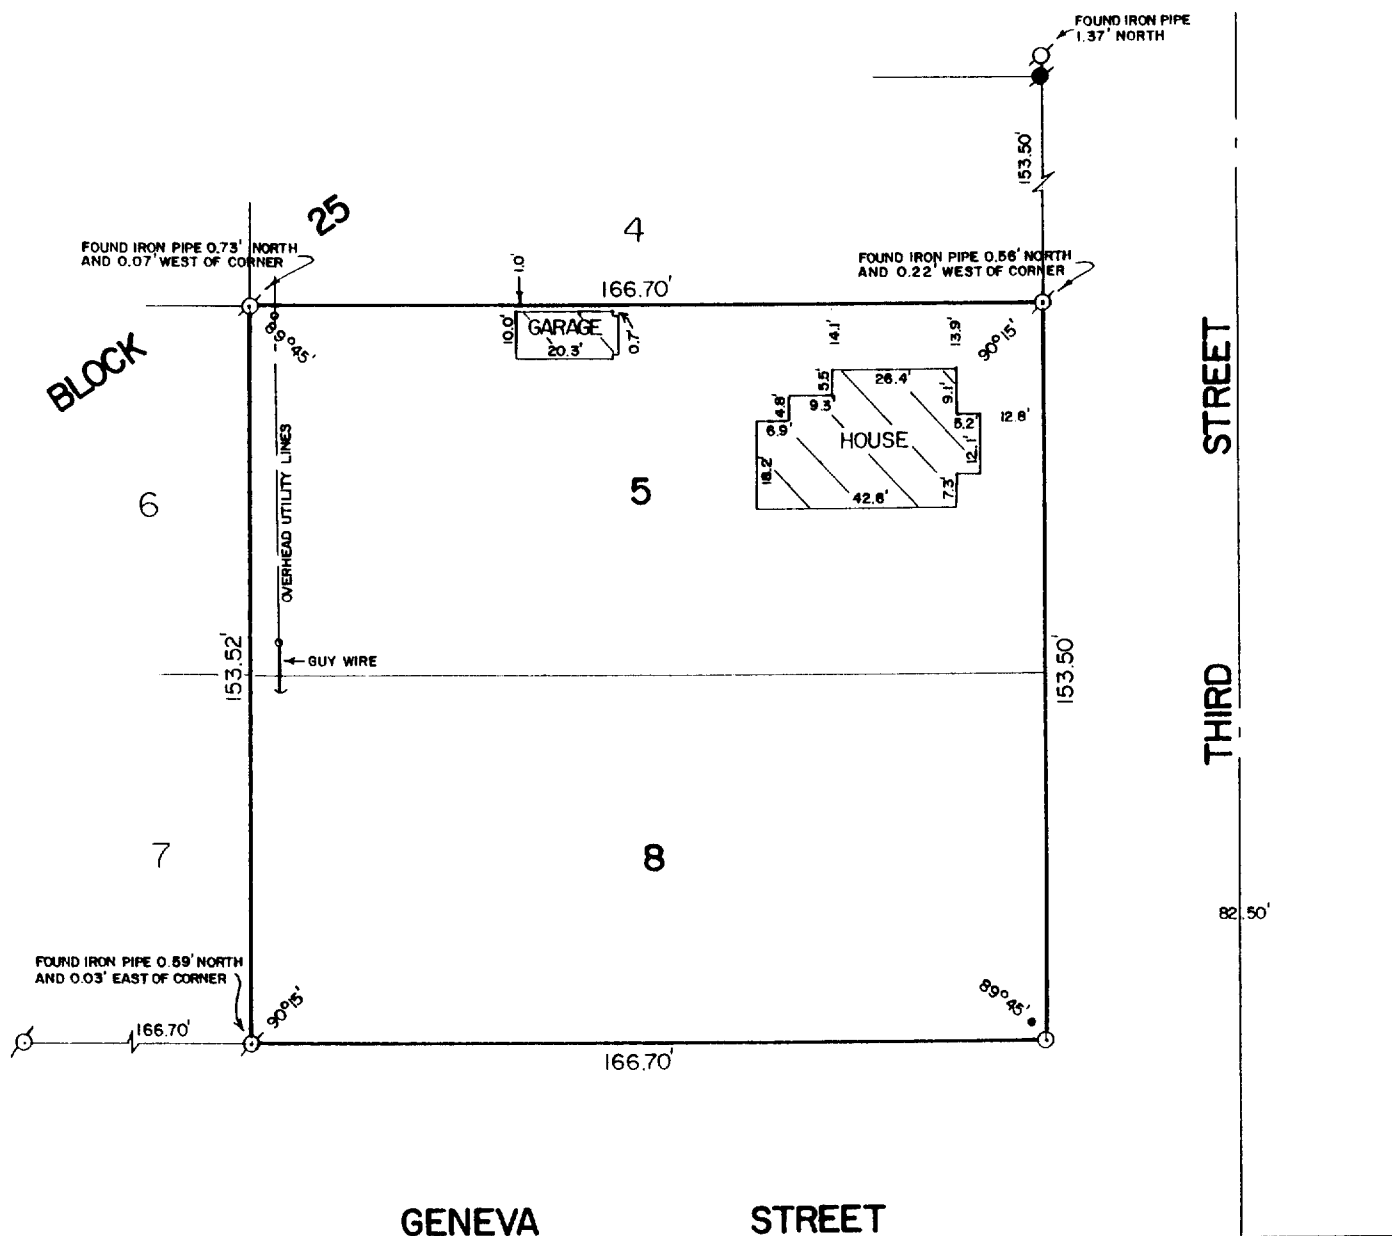

PLAT OF SURVEY OF

LOTS 5 AND 8, BLOCK 25 OF THE ORIGINAL PLAT OF
 THE CITY OF DELAVAN, WALWORTH COUNTY, WISCONSIN.

ORDERED BY: TIM O'KEEFE
 1036 RACINE ST.
 DELAVAN, WI. 53115

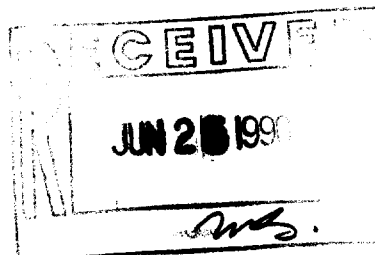

SCALE - 1"=40'

LEGEND

- - IRON PIPE FOUND
- - IRON ROD SET
- - CONCRETE MONUMENT FOUND
- - CATCH BASIN
- - UTILITY POLE

I HEREBY CERTIFY THAT I HAVE SURVEYED THE ABOVE DESCRIBED PROPERTY AND THAT THE ABOVE MAP IS A TRUE REPRESENTATION THEREOF AND SHOWS THE SIZE AND LOCATION OF THE PROPERTY, ITS EXTERIOR BOUNDARIES, THE LOCATION OF ALL VISIBLE STRUCTURES AND DIMENSIONS OF ALL PRINCIPAL BUILDINGS THEREON, BOUNDARY FENCES, APPARENT EASEMENTS, ROADWAYS AND VISIBLE ENCROACHMENTS, IF ANY, TO THE BEST OF MY KNOWLEDGE AND BELIEF.

THIS SURVEY IS MADE FOR THE USE OF THE PRESENT OWNERS OF THE PROPERTY, AND ALSO THOSE WHO PURCHASE, MORTGAGE, OR GUARANTEE THE TITLE THEREIN WITHIN ONE (1) YEAR FROM DATE HEREOF.

David F. Abell
 DAVID F. ABELL
 WISCONSIN REGISTERED LAND SURVEYOR, S-1596

TAX # XOP-257
 XOP-260

DATE *March 27, 1990* JOB NUMBER - 90048
 NOTE: THIS IS NOT A CERTIFIED COPY UNLESS SEALED.

2-977