


**SURVEYING & SUBDIVIDING
DELA VAN, WISCONSIN 53115**

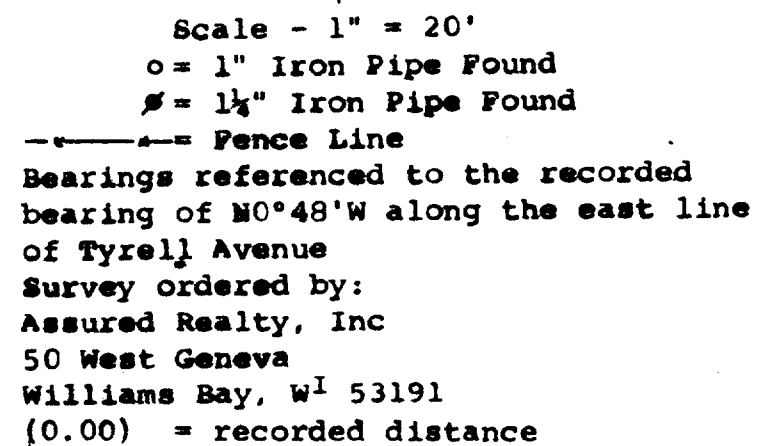

COUNTY OF WALWORTH)

property described as follows:

and that the plat shown hereon is a correct representation thereof and shows the size and location of the property, its exterior boundaries, the location of all visible structures and dimensions of all principal buildings thereon; boundary fences, apparent easements, roadways and visible encroachments, if any, and that I have surveyed the property hereon described, according to the official records, to the best of my knowledge and belief.

George T. Dunham
George T. Dunham, Surveyor

