


DUNHAM SURVEYING, S.C.
SURVEYING & SUBDIVIDING
DELAVER, WISCONSIN 53115

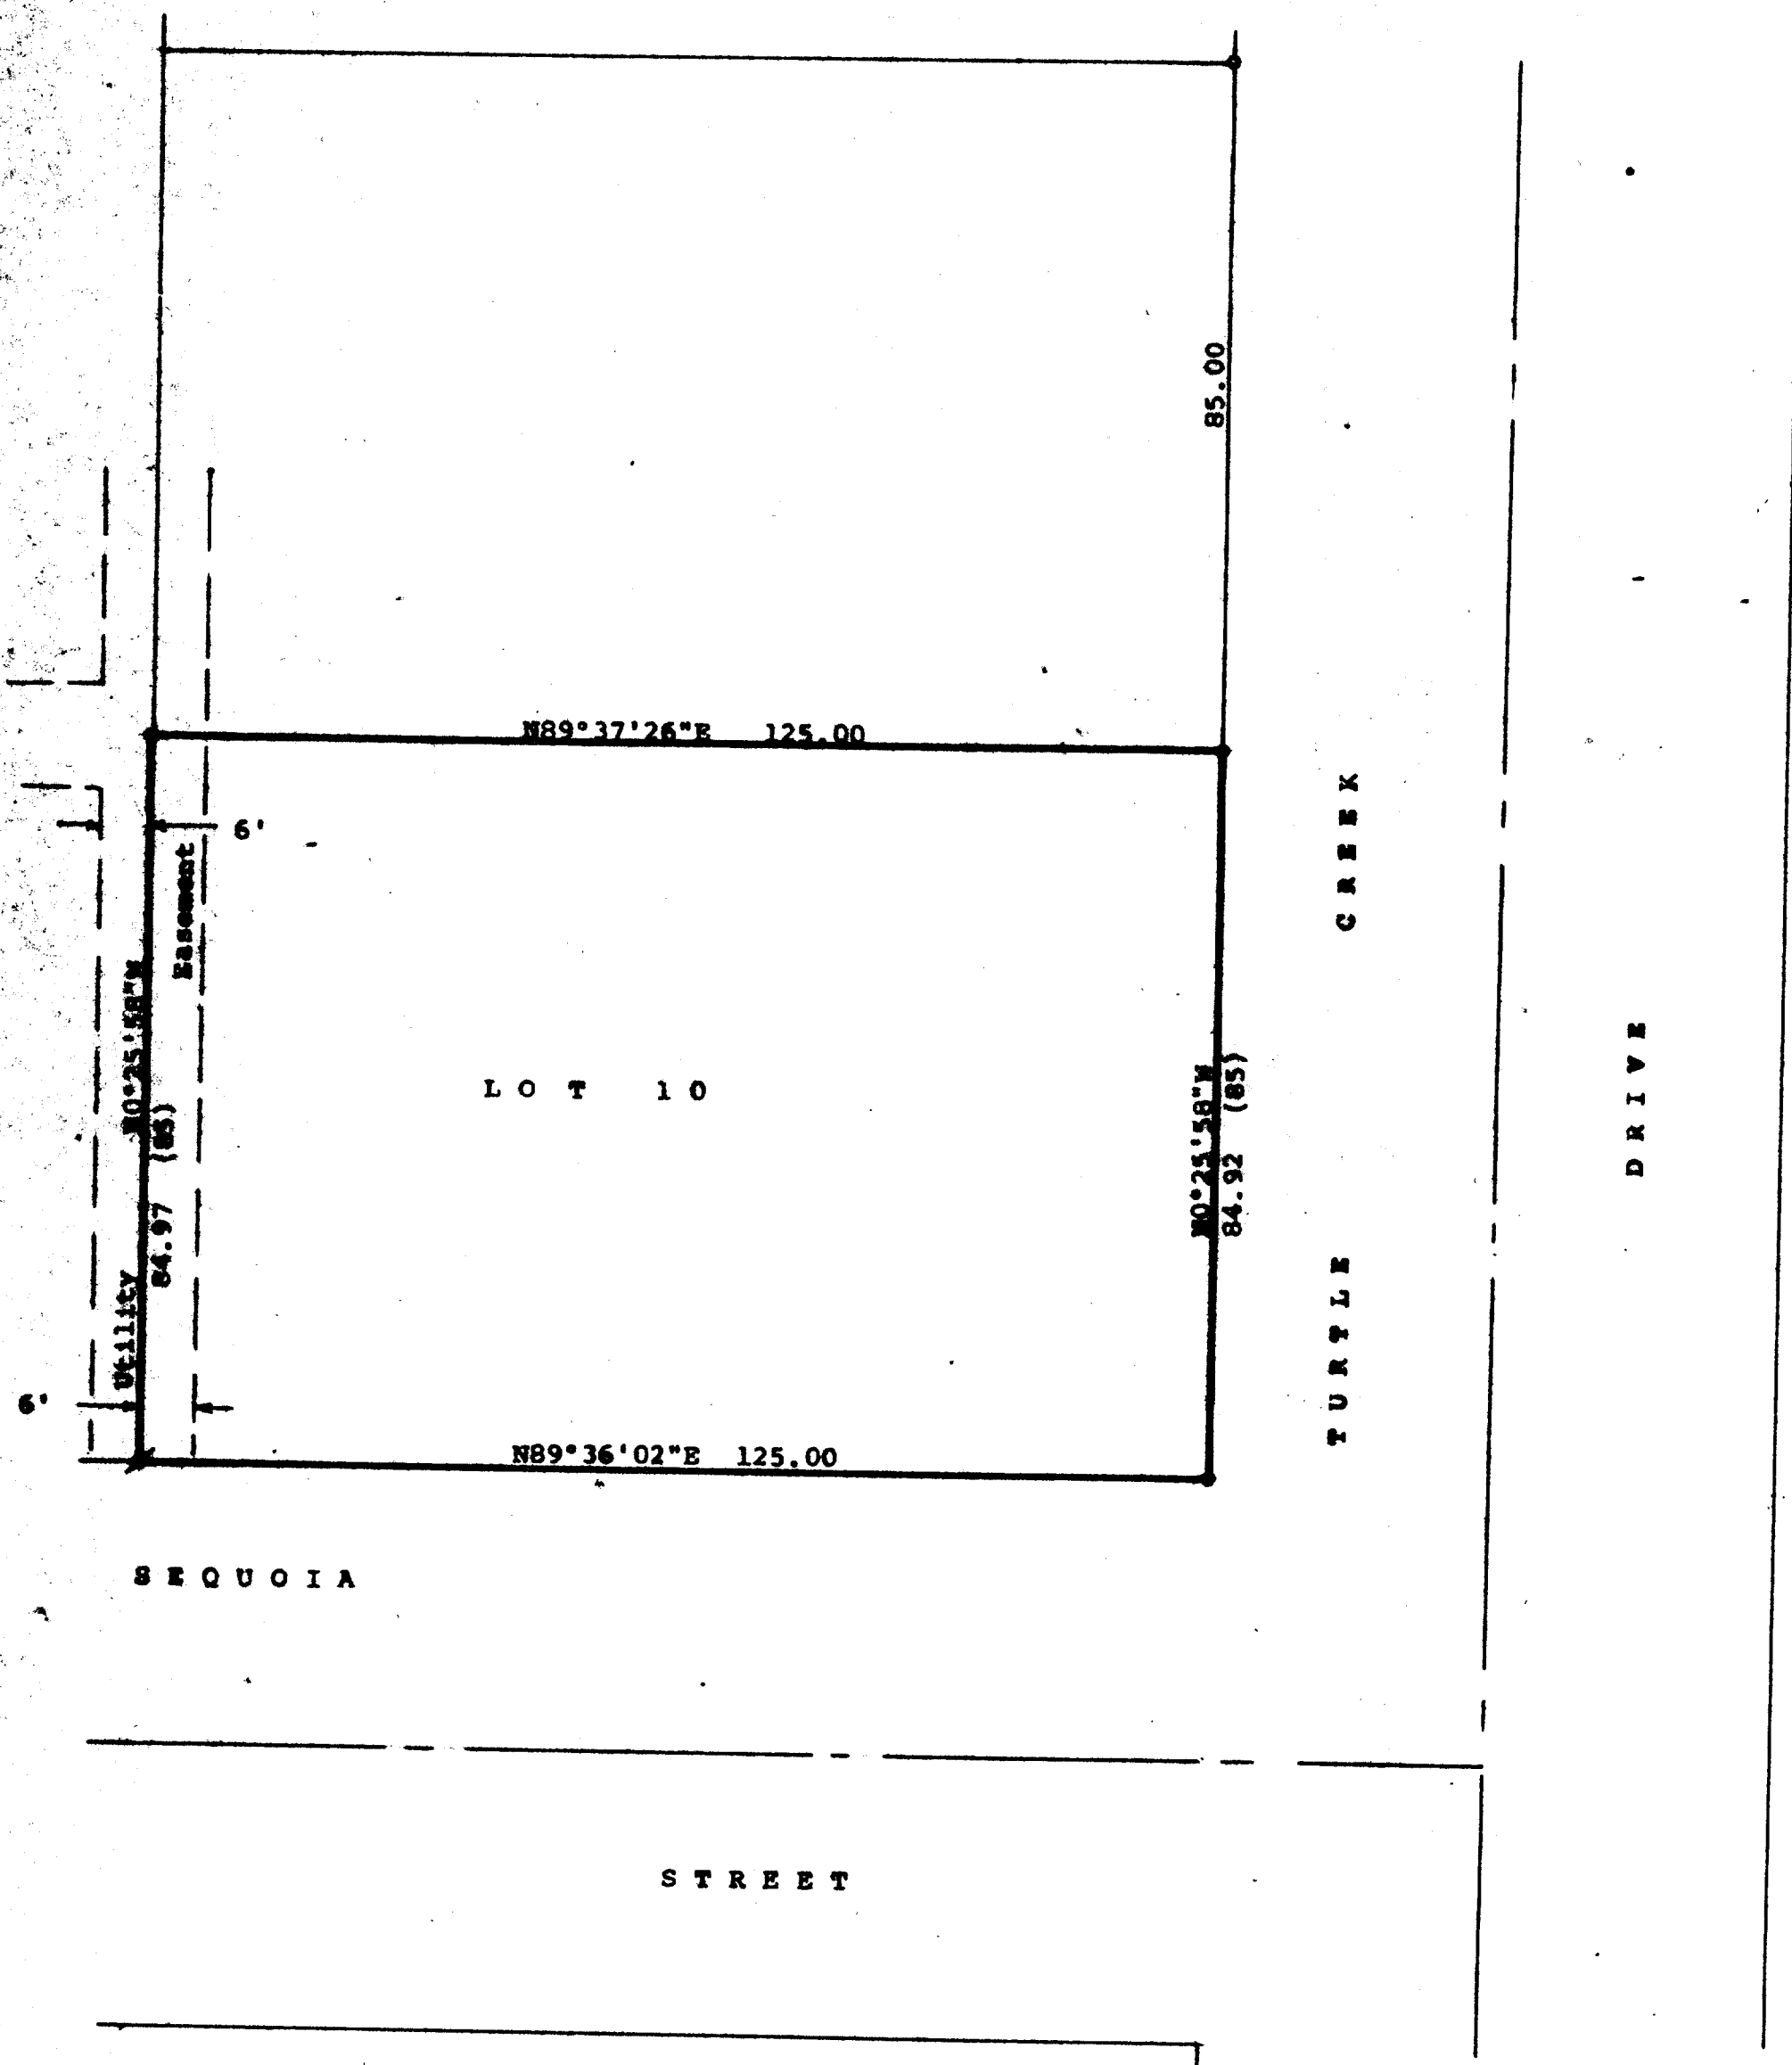

N

Scale - 1" = 20'
o = 5/8" Iron Rod Found
● = 2" Iron Pipe Found 1.2' below ground. Set 1" X 24" iron pipe at ground level
x = 5/8" Iron Rod found 1' below ground. Set 1 1/4" X 24" iron pipe at ground level

(0.00) = recorded distance
Survey ordered by: Realty World, Carmin Realtors
811 East Geneva Street
Delavan, WI 53115

* Bearings referenced to the recorded bearing of N89°36'02"E along the north line of Sequoia Street

SEQUOIA



STREET

STATE OF WISCONSIN)
COUNTY OF WALWORTH) SS

I, George T. Dunham, Surveyor, certify that I have surveyed the property described as follows:

Lot 10 in Turtle Creek, a subdivision located in the SW 1/4 of the SE 1/4 of Section 13, T 2 N, R 15 E, City of Delavan, Walworth County, Wisconsin, and that the plat shown above is a correct representation thereof and shows the size and location of the property, its exterior boundaries, the location of all visible structures and dimensions of all principal buildings thereon, boundary fences, apparent easements, roadways and visible encroachments, if any, and that I have surveyed the property hereon described, according to the official records, to the best of my knowledge and belief.
July 10, 1989

George T. Dunham
George T. Dunham, Surveyor

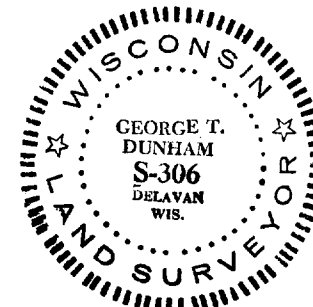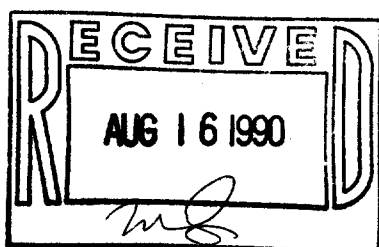

Survey # 002-998

TAX KEY-XTC 000 10