

PLAT OF SURVEY

BEING ALL OF LOT 142 OF LAKE BLUFF, LOCATED IN THE SW 1/4 OF SEC. 17 (GOVT LOT 3), T.4N., R.18E., VILLAGE OF EAST TROY, WALWORTH COUNTY, WI.

SURVEYOR:
KEITH A. KINDRED, PLS S-2082
SEH
501 MAPLE AVE
DELAFIELD, WI 53018
(414) 949-8919
KKINDRED@SEHINC.COM



SURVEY FOR:
BIELINSKI HOMES, INC
RE. TALBERT
1830 MEADOW LANE, SUITE A
PEWAUKEE, WI 53072

LEGEND

- - 1" IRON PIPE FOUND
- - UTILITY BOX
- ⊙ - MANHOLE

NOTES:

1. UTILITY EASEMENTS SHOWN PER FINAL PLAT.
2. THIS SURVEY IS SUBJECT TO ALL RESTRICTIONS AND NOTES SHOWN ON THE FINAL PLAT OF LAKE BLUFF RECORDED AT WALWORTH COUNTY REGISTER OF DEEDS OFFICE.
3. PENALTY FOR DISTURBING LOT CORNER MONUMENTS \$250.00 OR UP TO 1 YEAR IMPRISONMENT PER SS. 236.32(2)

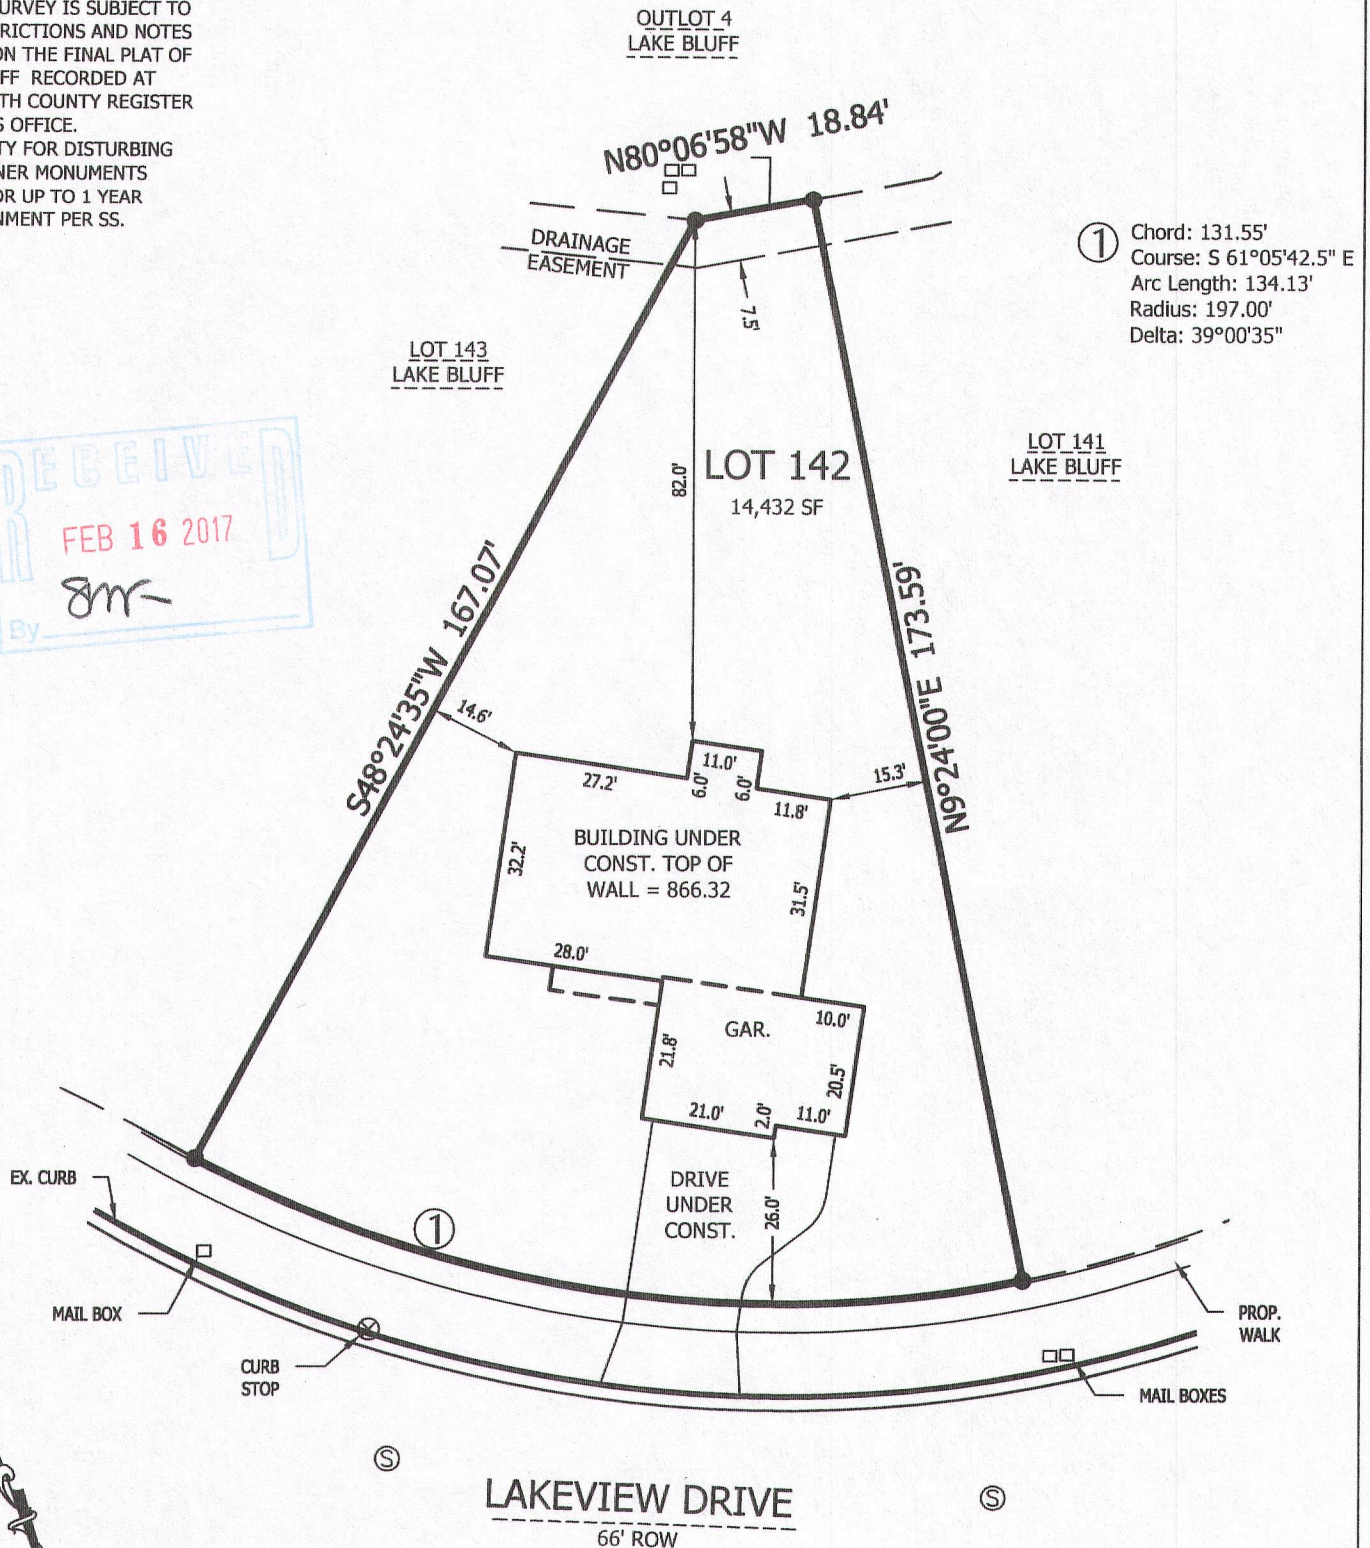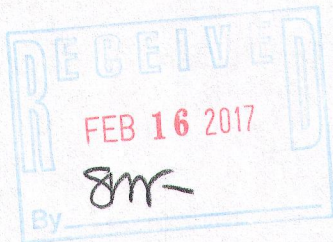


SCALE IN FEET
0 15 30

SURVEYOR'S CERTIFICATE:

I HEREBY CERTIFY THAT I HAVE SURVEYED THE ABOVE DESCRIBED PROPERTY AND THAT THE ABOVE MAP IS A TRUE REPRESENTATION THEREOF AND SHOWS THE SIZE AND LOCATION OF THE PROPERTY, ITS EXTERIOR BOUNDARIES, THE LOCATION OF ALL VISIBLE STRUCTURES AND DIMENSIONS OF ALL PRINCIPAL BUILDINGS THEREON, BOUNDARY FENCES, APPARENT EASEMENTS, ROADWAYS, AND VISIBLE ENCROACHMENTS, IF ANY.

THIS SURVEY IS MADE FOR THE USE OF THE PRESENT OWNERS OF THE PROPERTY, AND ALSO THOSE WHO PURCHASE, MORTGAGE, OR GUARANTEE THE TITLE THERETO WITHIN ONE (1) YEAR FROM DATE HEREOF.

SEH 501 MAPLE AVE., DELAFIELD, WI 53018 262-646-6855
PATH: P:\B12682\DWG\142 POS.DWG

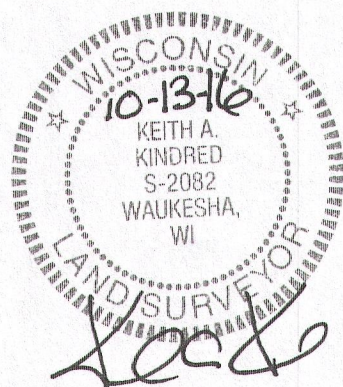

003-1080

RLB-142