

April 8, 2005

# PLAT OF SURVEY

Survey No. 040755R


Kaerek Homes - 6637

Darla D. Durbin


LOCATION: 2799 Brooks Court, East Troy, Wisconsin

## LEGAL DESCRIPTION:

Lot 16 in **CRYSTAL ACRES**, Part of the Northwest 1/4 and Northeast 1/4 of the Southwest 1/4 of Section 20, Town 4 North, Range 18 East, Village of East Troy, Walworth County, Wisconsin.

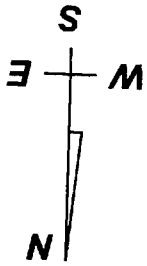

SCALE: 1"=30'

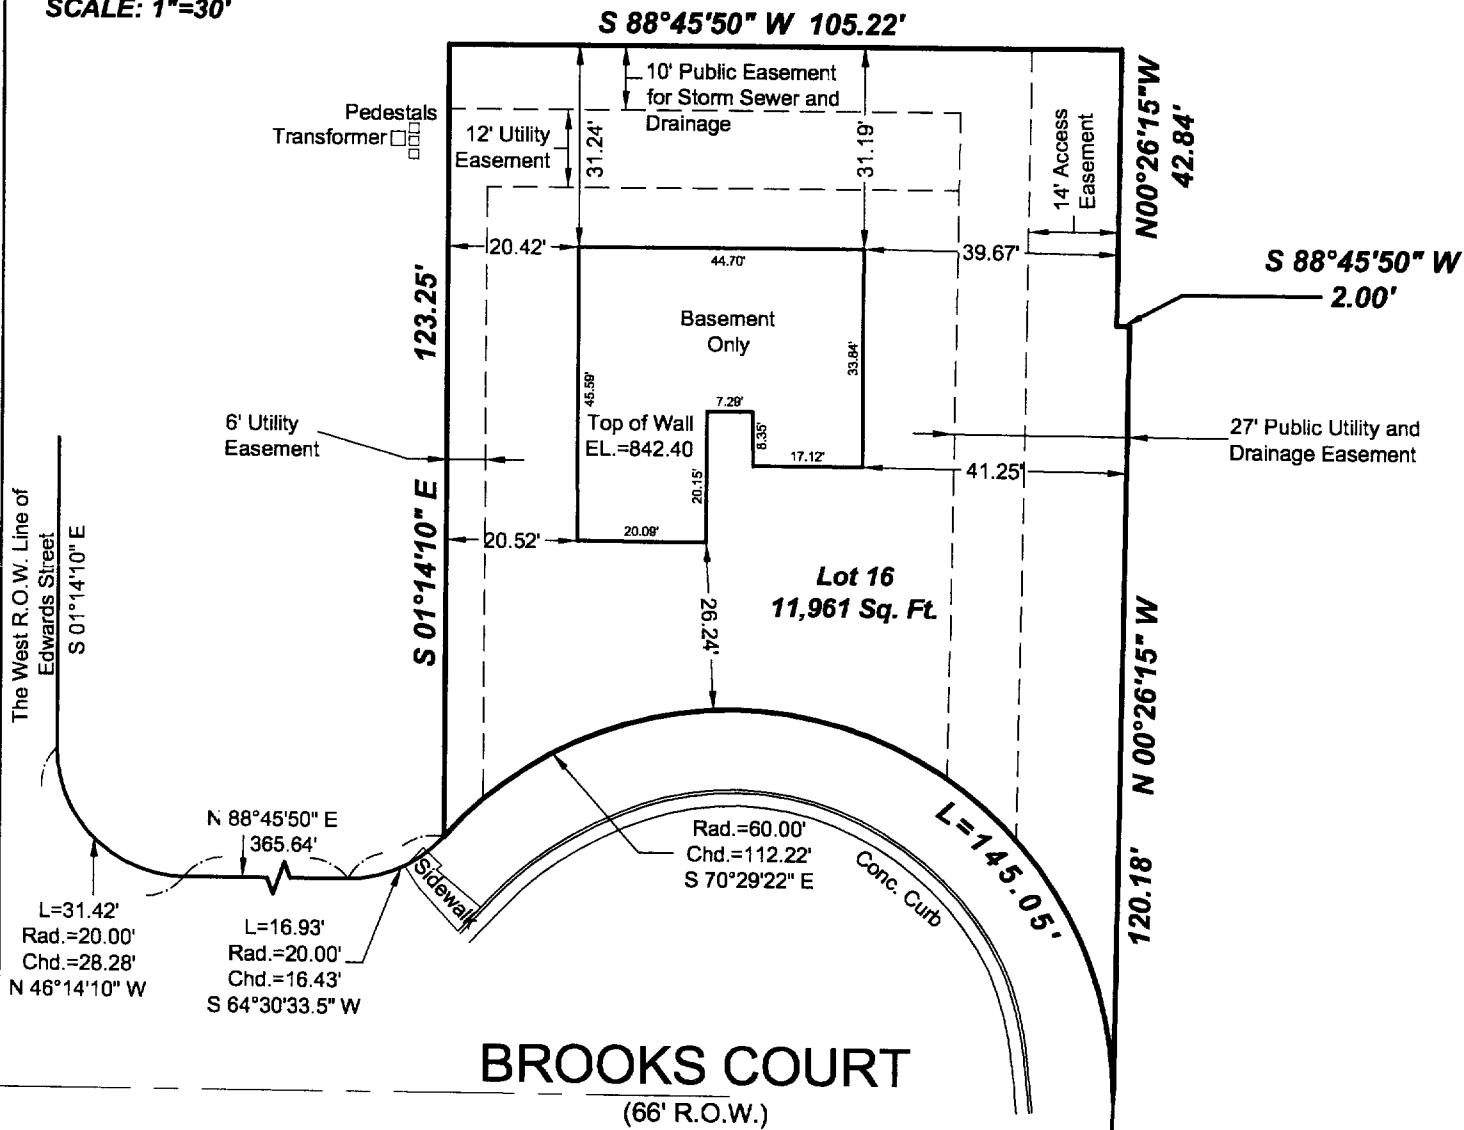

MAY 4 2005

DRAWING BY: AW  
FIELD WORK BY: MG

**LANDCRAFT SURVEY AND ENGINEERING, INC.**  
 REGISTERED LAND SURVEYORS AND CIVIL ENGINEERS  
 2077 South 116th Street, West Allis, WI 53227  
 PH. (414) 604-0674 FAX (414) 604-0677  
 INFO@LANDCRAFTSE.COM



**Mortgage Inspection**  
 Monumentation has been waived in accordance with A-5 5.01 (b) of the Wisconsin Administrative Code.

I HEREBY CERTIFY THAT I HAVE SURVEYED THE ABOVE DESCRIBED PROPERTY AND THAT THE ABOVE MAP IS A TRUE REPRESENTATION THEREOF AND SHOWS THE SIZE AND LOCATION OF THE PROPERTY, ITS EXTERIOR BOUNDARIES, THE LOCATION OF ALL VISIBLE STRUCTURES AND DIMENSIONS OF ALL PRINCIPAL BUILDINGS THEREON, BOUNDARY FENCES, APPARENT EASEMENTS AND ROADWAYS AND VISIBLE ENCROACHMENT, IF ANY.

THIS SURVEY IS MADE FOR THE EXCLUSIVE USE OF THE PRESENT OWNERS OF THE PROPERTY, AND ALSO THOSE WHO PURCHASE, MORTGAGE, OR GUARANTEE THE TITLE THERETO WITHIN ONE (1) YEAR FROM THE DATE HEREOF.

SIGNED *William R. Henrichs*  
 William R. Henrichs, Registered Land Surveyor S-2419

003-899

RCRA 0000