

17LP

HOFFMANN, POLZIN, BECKER & ASSOC. INC.
WAUKESHA, WISCONSIN

PLANNING
SURVEYING
ENGINEERING
ARCHITECTURE



PLAT OF SURVEY



FOR: Holnagel Construction

SCALE 1"=30'

Lot 41, Troy-Jens, a subdivision being part of the Southwest One-Quarter of Section 19, Town 4 North, Range 18 East, Village of East Troy, Walworth County, Wisconsin.

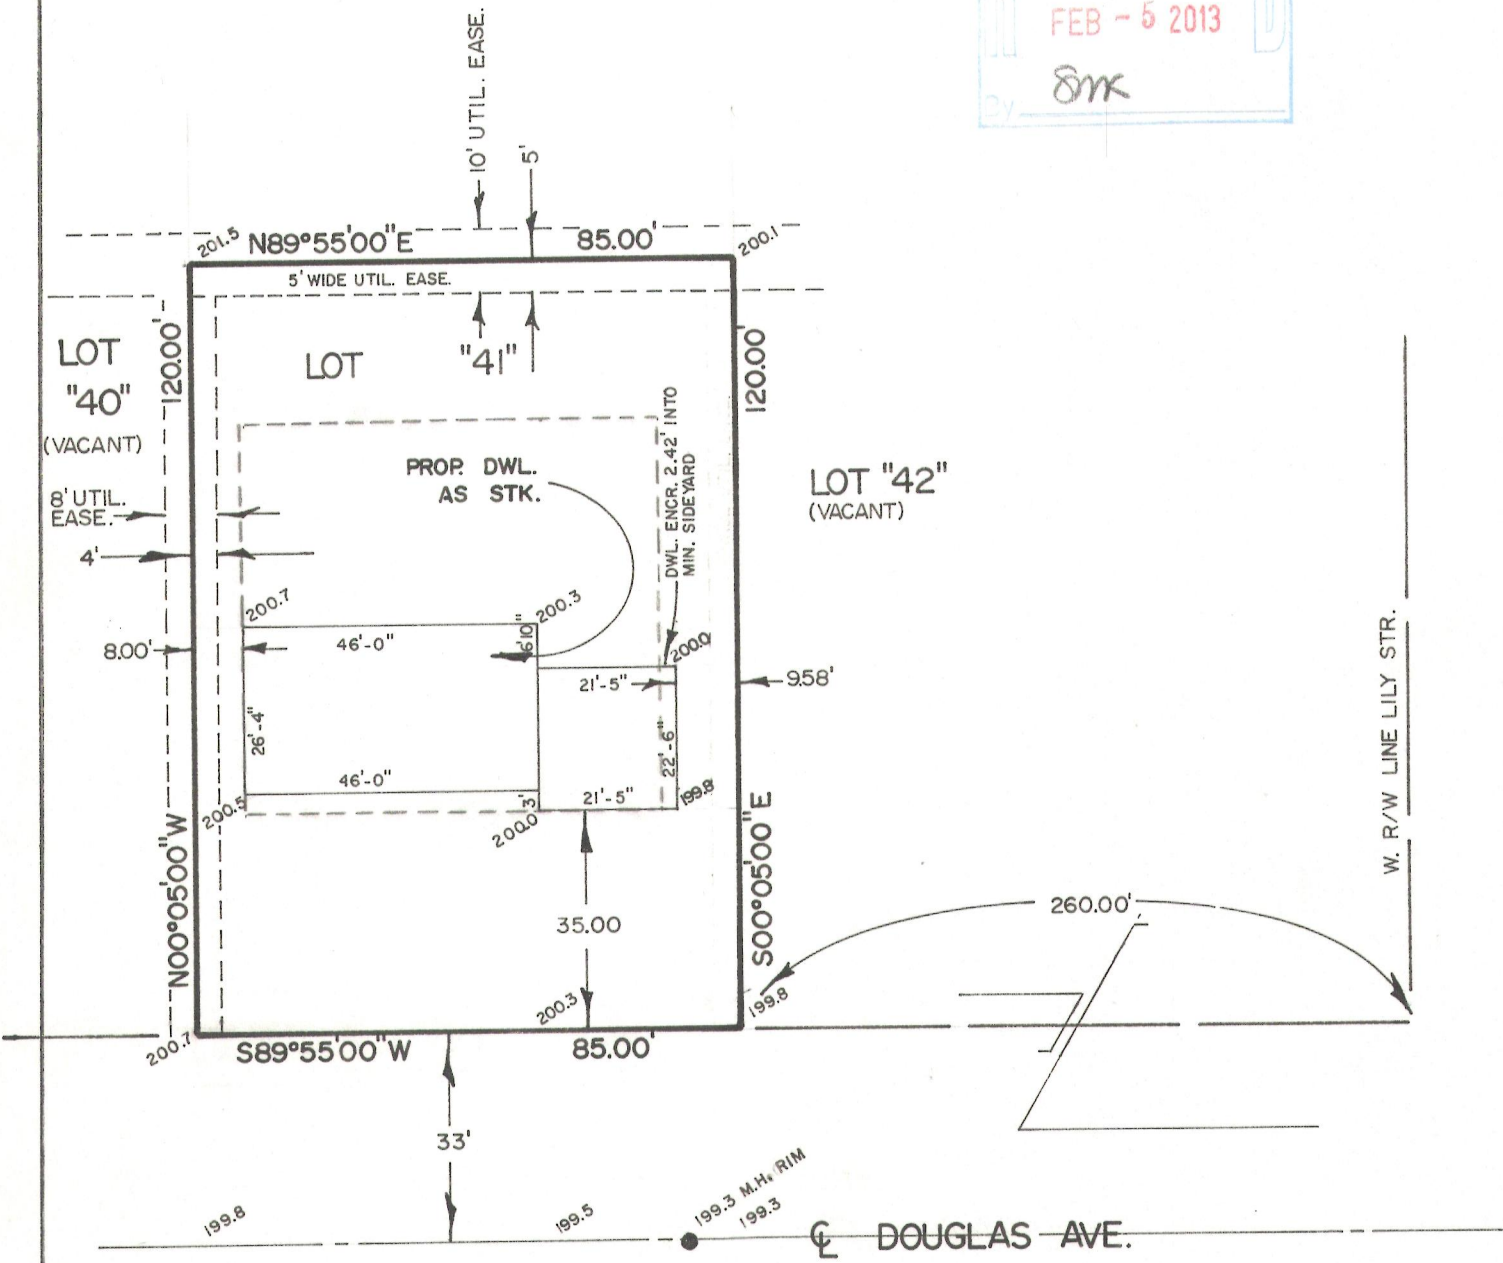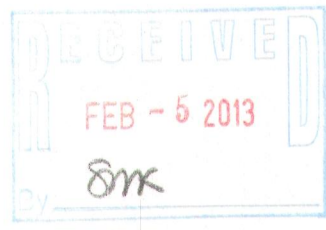

STATE OF WISCONSIN }
COUNTY OF WAUKESHA } ss.

CERTIFICATION


I, Thomas L. Peterson, DO HEREBY CERTIFY
THAT I HAVE

staked a residence on the

LANDS DESCRIBED ABOVE AND THAT THE PLAT HEREWITH DRAWN IS A CORRECT REPRESENTATION
OF SAME.

DATED THIS 2nd DAY OF April, 19 74

RTJ-41

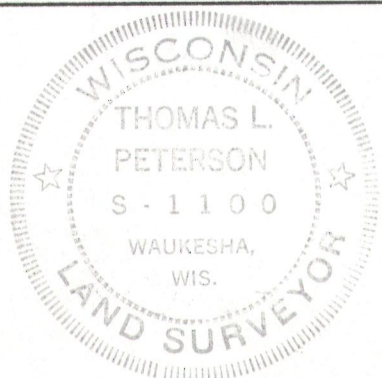

LAND SURVEYOR NO. S-01100

DRAFTED BY Ham

003-1080

JOB NO. 950-H5