

2-
2 TLP
HOFFMANN, POLZIN, BECKER & ASSOC. INC.
WAUKESHA, WISCONSIN

PLAT OF SURVEY



PLANNING
SURVEYING
ENGINEERING
ARCHITECTURE



FOR: HOLNAGEL CONSTRUCTION

SCALE 1"=30'

Lot 41, Troy-Jens, a subdivision being part of the Southwest One-Quarter of Section 19, Town 4 North, Range 18 East, Village of East Troy, Walworth County, Wisconsin.

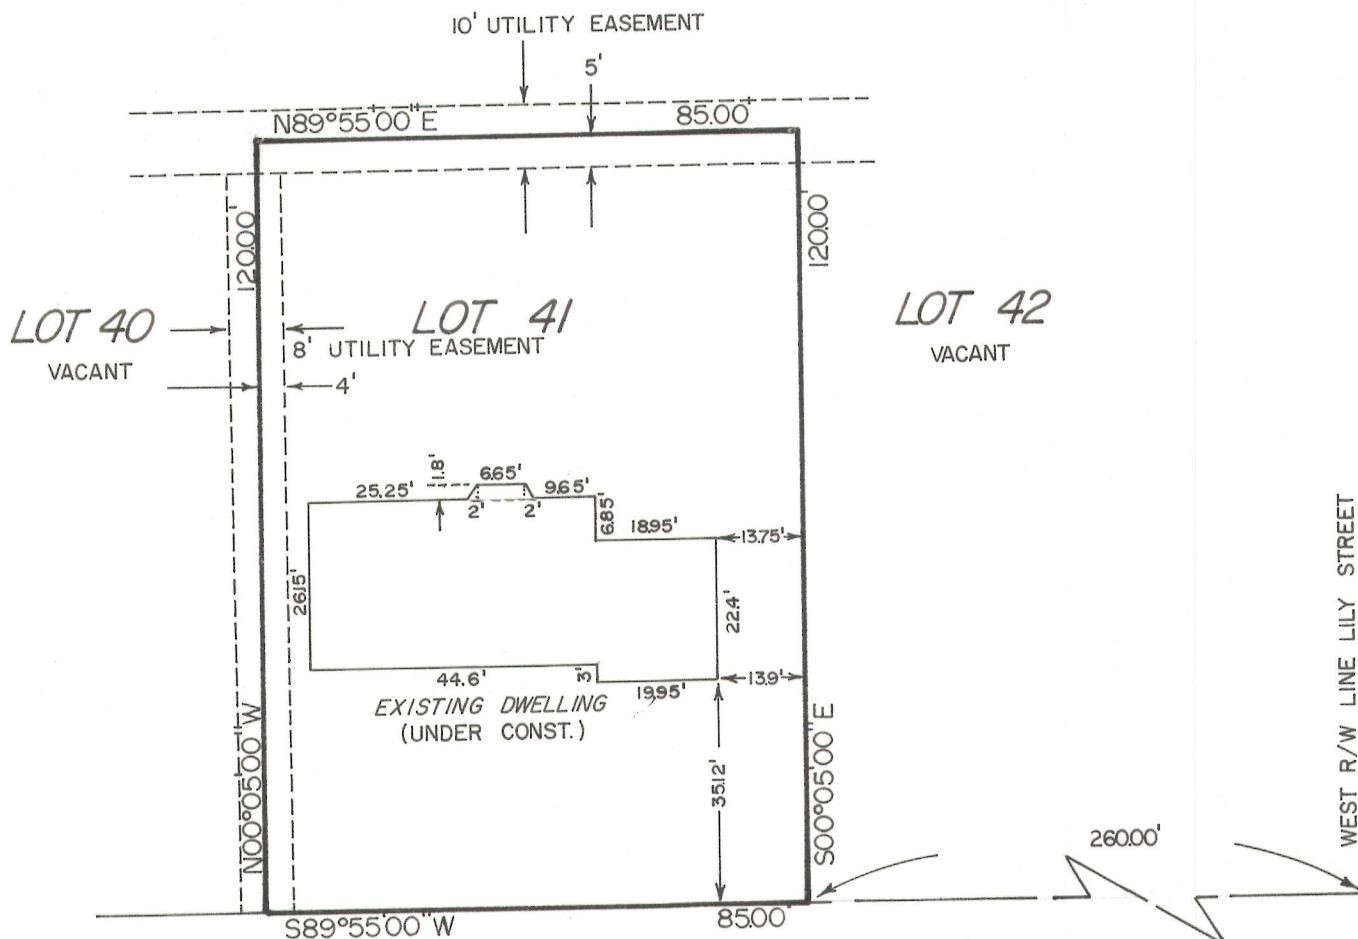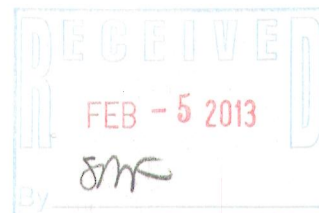

☪ DOUGLAS AVE.

STATE OF WISCONSIN }
COUNTY OF WAUKESHA } SS.

CERTIFICATION

I, Thomas L. Peterson, DO HEREBY CERTIFY
THAT I HAVE

located the existing building on the

LANDS DESCRIBED ABOVE AND THAT THE PLAT HEREWITH DRAWN IS A CORRECT REPRESENTATION
OF SAME.

DATED THIS 10th DAY OF May, 19 74



LAND SURVEYOR NO. 5-01100

RTJ-41

DRAFTED BY JWG

003 10/9

JOB NO. 976-RC