

PLAT OF SURVEY
OF


LOT 4, BLOCK 1, S. B. EDWARD'S ADDITION TO THE VILLAGE OF EAST TROY, AS RECORDED IN VOLUME 2 OF PLATS, PAGE 36, LOCATED IN THE SOUTHWEST 1/4 OF SECTION 20, T. 4 N., R. 18 E., VILLAGE OF EAST TROY, WALWORTH COUNTY, WISCONSIN.

I HEREBY CERTIFY THAT I HAVE SURVEYED THE LAND DESCRIBED ABOVE AND THAT THE PLAT DRAWN HEREON IS A CORRECT REPRESENTATION OF SAID SURVEY. I FURTHER CERTIFY THAT THE BUILDINGS ON SAID LAND ARE LOCATED AS SHOWN ON THIS PLAT.

FOR: C-MAC BUILDING CORP.

SCALE 1" = 30'

- = IRON PIPE STAKE SET
- = IRON PIPE STAKE FOUND
- ⊗ = MONUMENT FOUND.

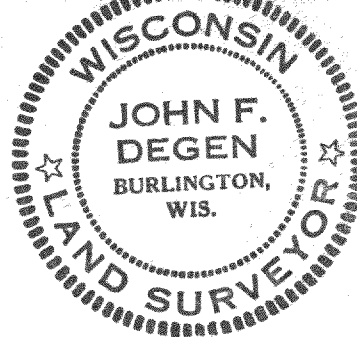

John F. Degen 4-29-75
JOHN F. DEGEN, LAND SURVEYOR #242
589 N. PINE ST., BURLINGTON, WISCONSIN.

