


FARRIS, HANSEN & ASSOCIATES, INC.
ENGINEERING — ARCHITECTURE — SURVEYING
7 RIDGWAY COURT — P.O. BOX 437 — ELKHORN, WISCONSIN 53121
PHONE: (262) 723-2098 FAX: (262) 723-5886

BEARING REFERENCED TO THE
SOUTH LINE OF UNION STREET
RECORDED AS N 89.30' E

- WORK ORDERED BY -
 TOM GARVEY
 4250 N. MARINE DR. APT. 1814
 CHICAGO IL 60613


PLAT OF SURVEY

THE WEST 1/2 OF LOT 3, LOT 4 AND THE EAST 6' OF LOT 5 OF BLOCK 6
OF THE ORIGINAL PLAT OF THE VILLAGE OF EAST TROY,
WALWORTH COUNTY, WISCONSIN

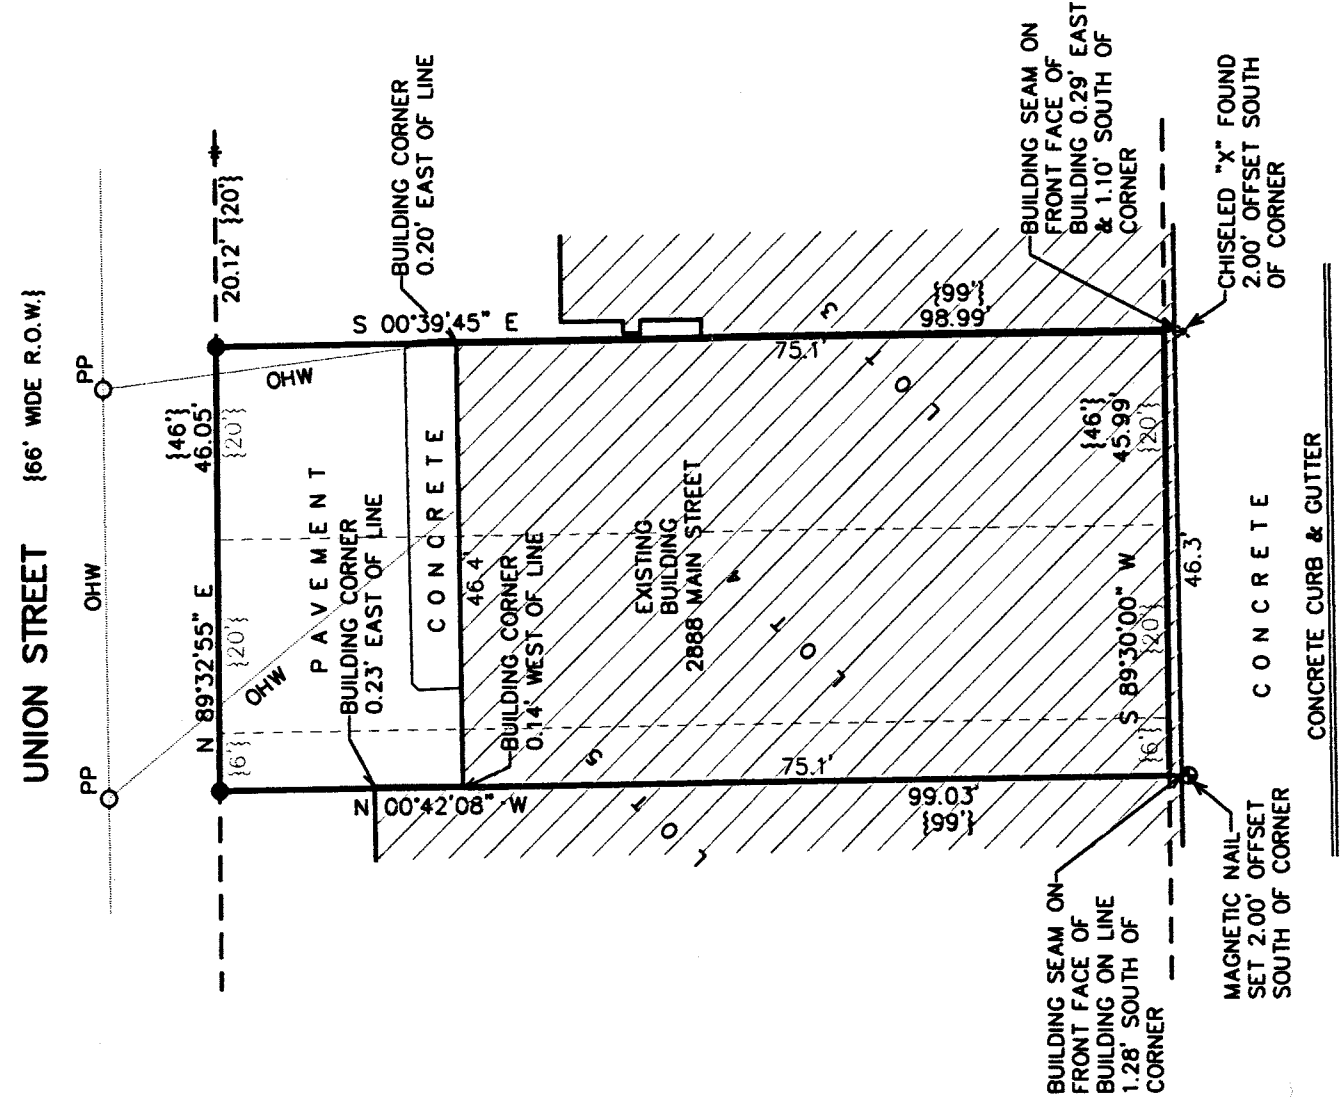

MAIN STREET (C.T.H. "ES")

{66' WIDE R.O.W.}

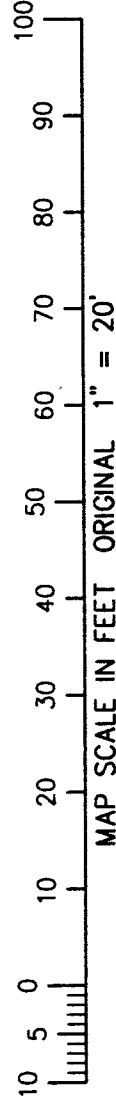

NOTE: COPIES OF THIS MAP TO WHICH THE FOLLOWING CERTIFICATE WILL APPLY SHOW THE SURVEYOR'S ORIGINAL SEAL AND SIGNATURE IN RED INK. COPIES BY ANY OTHER MEANS MAY HAVE ALTERATIONS WHICH DO NOT REPRESENT THE SURVEYOR'S WORK PRODUCT.

I HEREBY CERTIFY THAT THE ABOVE DESCRIBED PROPERTY HAS BEEN SURVEYED UNDER MY DIRECTION AND THAT THE ABOVE MAP IS A TRUE REPRESENTATION THEREOF AND SHOWS THE SIZE AND LOCATION OF THE PROPERTY AND ITS EXTERIOR BOUNDARIES. THIS SURVEY IS MADE FOR THE USE OF THE PRESENT OWNERS OF THE PROPERTY, AND ALSO THOSE WHO PURCHASE, MORTGAGE, OR GUARANTEE THE TITLE THERETO WITHIN ONE YEAR FROM THE DATE HEREOF.

DATED: DECEMBER 4, 2013


PETER S. GORDON R.L.S. 2101

PROJECT: 5075.13
DATE: 12/3/2013
SHEET 1 OF 1

DEC 11 1968

ROP-61