


48-58

3-103B

10

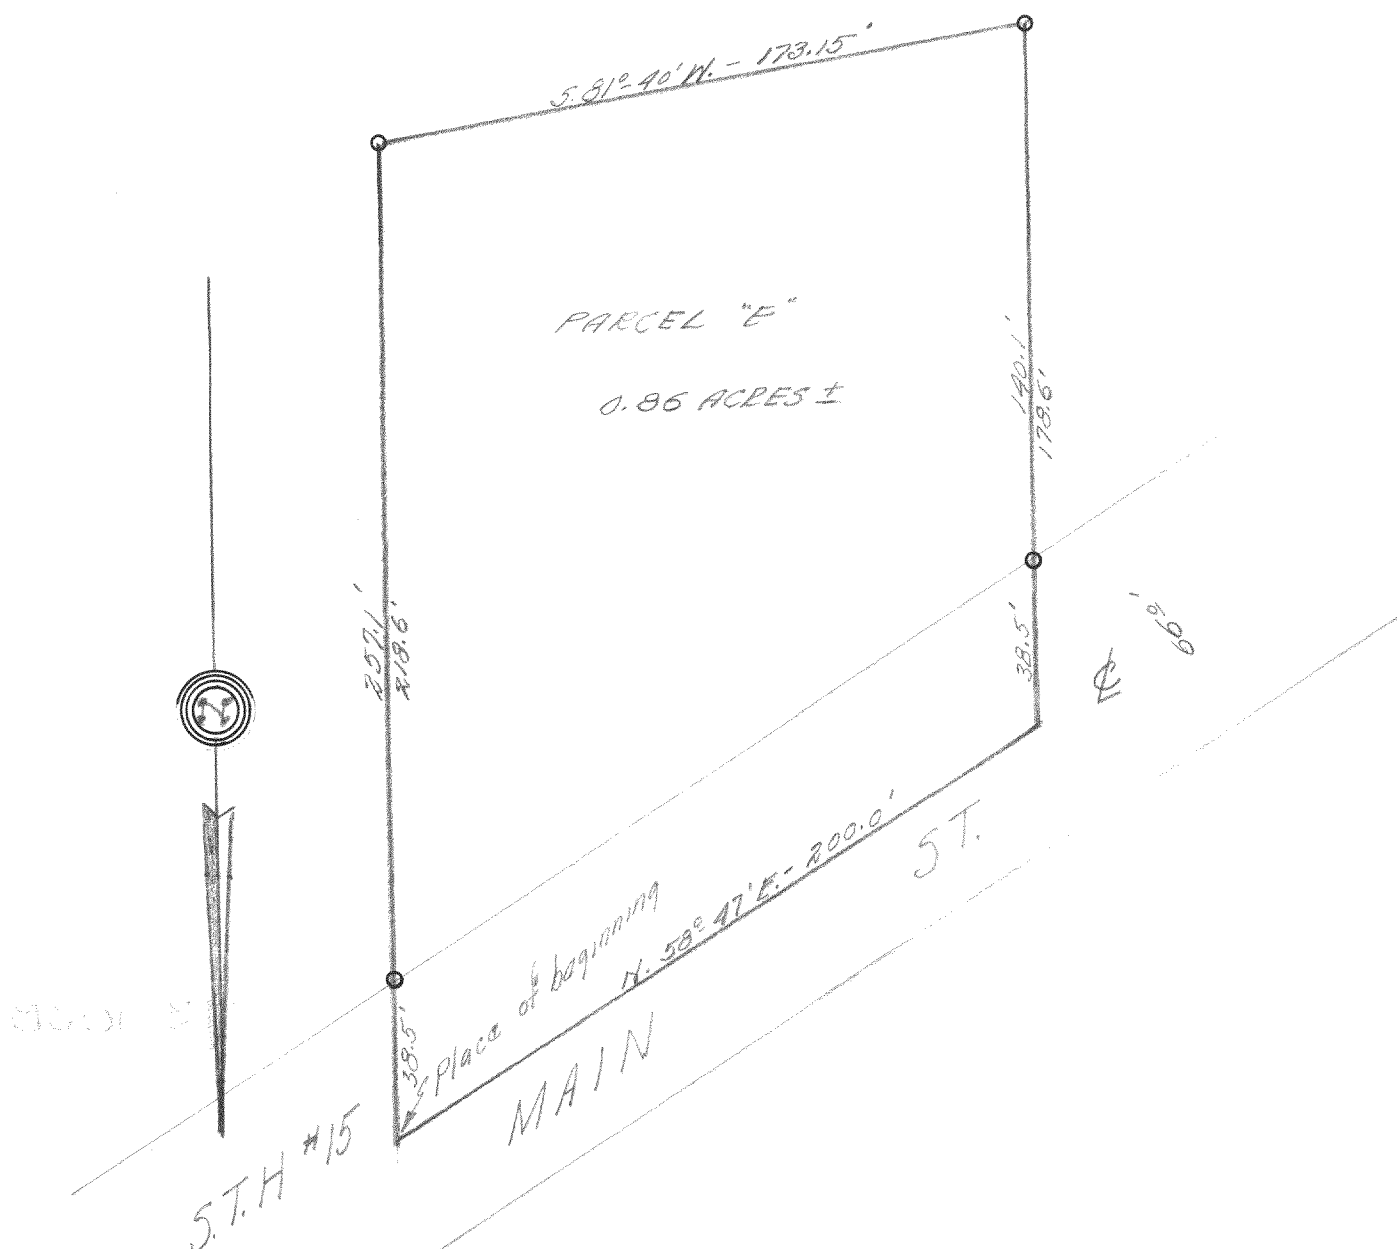

DESCRIPTION: Commencing at a point in the centerline of State Trunk Highway #15, that is 968 feet S. 58° 47' W., of the intersection of the centerline of said highway with the N. & S. $\frac{1}{4}$ section line of Section 20, Town 4 north, Range 18 east of the 4th Principal meridian, thence South 257.1 feet to an iron stake, thence S. 81° 40' W., 173.15 feet to an iron stake, thence North 178.6 feet to a point in the centerline of said highway, thence N. 58° 47' E., along the centerline of said highway 200.0 feet to the place of beginning. Containing 0.86 acres more or less.

CERTIFICATE: I, hereby certify that I have on this the 6th day of April 1948, surveyed the above described property according to the official records on file in the office of the Recorder of Deeds in and for Walworth County, Wisconsin, and find that the measurements and bearings of the boundary lines of said property as taken at the site on this day, substantially agree with those in the above description and that no encroachments exist.

SIGNED AND SEALED THIS 7TH DAY OF APRIL 1948.

Joseph M. Biagi
Joseph M. Biagi. Professional Engineer
Elkhorn Wisconsin.

3-103B

UP-148 (part of)