

ROBERS & BOYD, INC.
CONSULTING ENGINEERS & LAND SURVEYORS


PHONE (414) 763-2652

116 E. CHESTNUT ST.

BURLINGTON, WIS. 53105

PLAT OF SURVEY AND HOUSE LOCATION

The North 132 feet of the West 214.5 feet of Lot 3, Block 1,
 Original Plat of the Village of East Troy, Walworth County,
 Wisconsin; excepting therefrom the North 32 feet thereof.

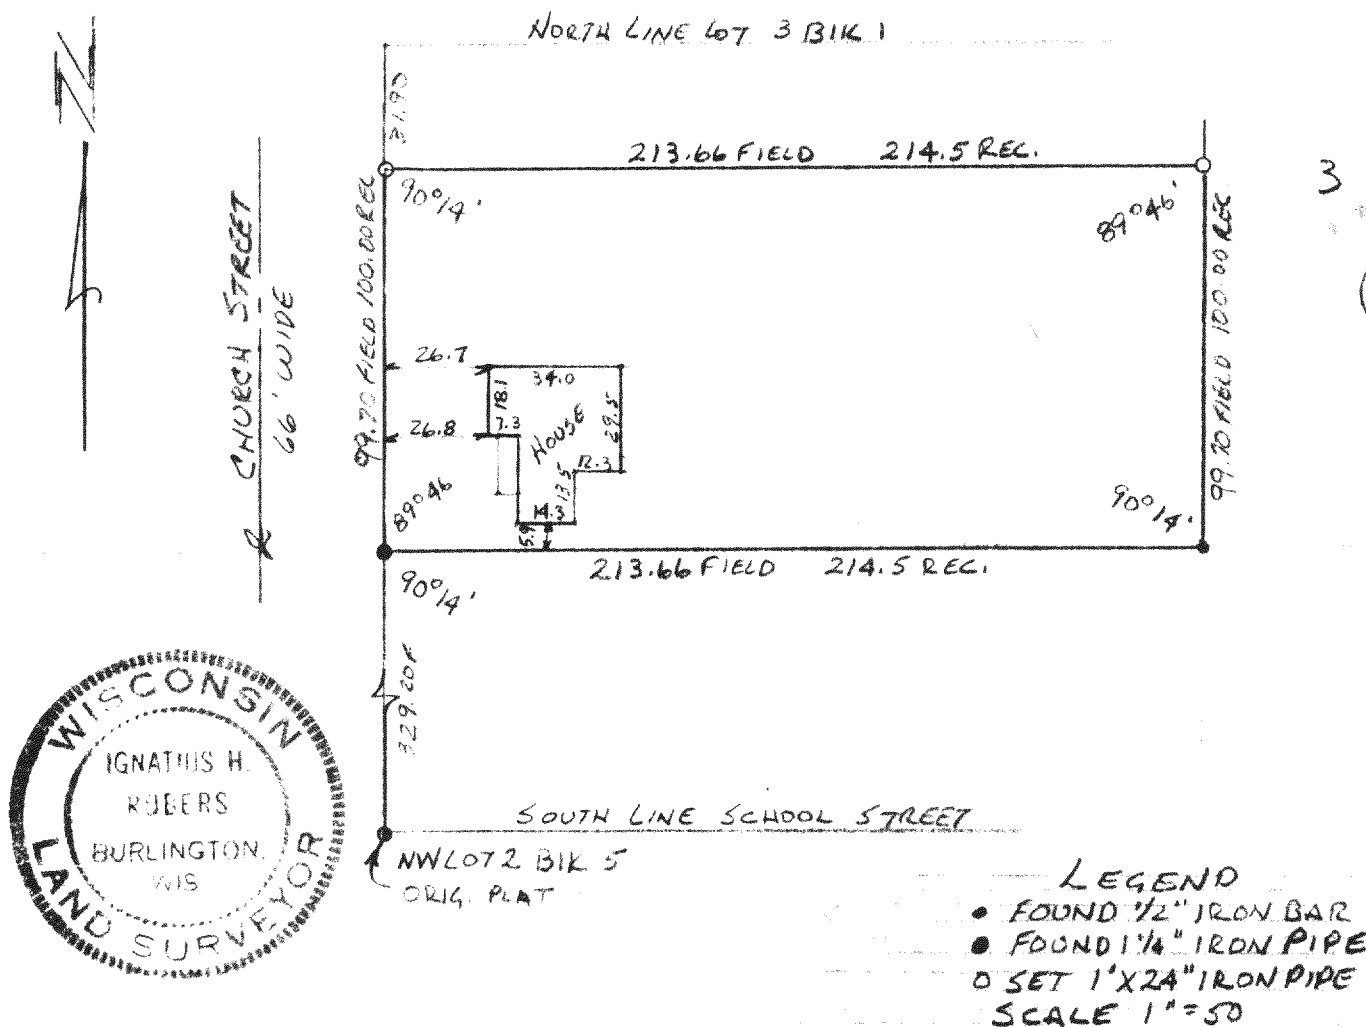

I HEREBY CERTIFY THAT WE HAVE SURVEYED THE LANDS DESCRIBED
 ABOVE ACCORDING TO OFFICIAL RECORDS AND THAT THE PLAT
 DRAWN HEREON IS A CORRECT REPRESENTATION OF SAID SURVEY.

Ignatius H. Rober
 WIS. REG. LAND SURVEYOR 5787

DATE 10-27-75

JOB NO. 75/82