

LOT 130 OF LAKE BLUFF SUBDIVISION,
BEING PART OF CERTIFIED SURVEY MAP No.
2265, LOCATED IN THE SE ¼, NW ¼, & SW ¼,
OF THE SW ¼ OF SECTION 17,
(GOVERNMENT LOT 3) TOWNSHIP 4 NORTH,
RANGE 18 EAST, VILLAGE OF EAST TROY,
WALWORTH COUNTY, WISCONSIN.



THIS PARCEL IS SUBJECT TO ALL AND ANY
RESTRICTIONS, EASEMENTS AND NOTES
SHOWN ON THE FINAL PLAT OF LAKE BLUFF
SUBDIVISION RECORDED AT THE WALWORTH
COUNTY REGISTER OF DEEDS

EXPOSE SANITARY LATERAL PRIOR TO
CONSTRUCTION TO VERIFY GRAVITY FLOW
TO BASEMENT

PROPOSED GRADES PER GRADING PLAN OR ADJUSTED BY BUILDER. CONTRACTOR TO VERIFY ALL PROPOSED GRADES AND WALL HEIGHTS PRIOR TO EXCAVATION.


	1" FOUND IRON PIPE, UNLESS NOTED		TELEPHONE PEDESTAL
	STORM INLET		TV PEDESTAL
	STORM MANHOLE		ELECTRIC PEDESTAL
	SANITARY MANHOLE		ELECTRIC TRANSFORMER
	WATER BOX OR VALVE		PINE TREE/SHRUB
	SPOT ELEVATION		FLAG POLE
			LATERAL WATERBOX

SURVEY MADE FOR:
BIELINSKI HOMES, INC.
1830 MEADOW LANE
PEWAUKEE, WI 53072

DATE	ITEM
04/29/2017	ORIGINAL SURVEY
05/11/2017	STAKED HOUSE
06/29/2017	FOUNDATION SURVEY

THIS SURVEY IS MADE FOR THE USE OF THE
PRESENT OWNERS OF THE PROPERTY, AND
ALSO THOSE WHO PURCHASE, MORTGAGE OR
GUARANTEE TITLE TO WITHIN ONE (1) YEAR
FROM DATE HERETO.

I, MICHAEL A. GREESON R.L.S. #2770, HEREBY CERTIFY THAT THIS SURVEY WAS MADE IN ACCORDANCE WITH THE MINIMUM STANDARDS FOR PROPERTY SURVEYS (CHAPTER A-E 7) FOR THE STATE OF WISCONSIN AND HAS BEEN PREPARED UNDER MY DIRECTION AND CONTROL AND IS CORRECT TO THE BEST OF MY KNOWLEDGE AND BELIEF.

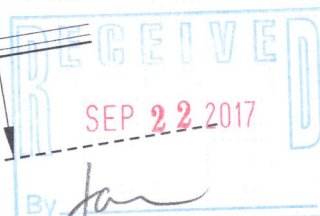

RLB-130

003-1081