

NW CORNER
SECTION 30,
T4N, R18E

TOWN LINE ROAD N0°06'57"W 675.03'

90°

RECORDED AS 458.57'

261.74

410.04'

197.22'

N 88°59'53"E 1248.78'

410'

PARCEL I
6.115 ACRES

N 0°06'57"W 624.48'

591.16'

REMAINING LAND

N 0°04'35"W 521.13'

FOUND
1. PIPE BENT

CO. TR. HWY. E5


OLD ST. HWY. "15"

413.92'

N 81°59'03"E 1260.23'

- - SET 1 3/8" IRON BAR
- - SET 3/4" IRON ROD
- - FOUND IRON PIPE
- ⊙ - FOUND CON. MONUMENT

N

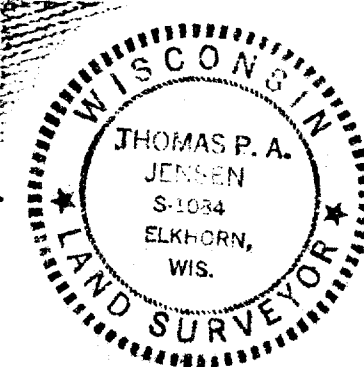

PLAT OF SURVEY OF

LAND LOCATED IN THE NW 1/4 OF SECTION 30,
TOWN 4 NORTH, RANGE 18 EAST OF WALWORTH
COUNTY, WISCONSIN

Thomas P. A. Jensen
SURVEYOR

SCALE 1" = 100'

DATE MAR. 22, 1976

REVISED DATED MAY 19, 1976

3-109J