



PLAT OF SURVEY

Part of the southwest 1/4 of Section 20, T4N, R18E, Village of East Troy, Walworth County, Wisconsin described as follows:

A parcel of land located in Block 1 of the Original Plat of the Village of East Troy, Wisconsin, described as follows, to-wit: Beginning on the South line of said Block at a point that is located 320.50 feet East of the Southwest corner of said Block; thence North 136.00 feet; thence East 80.00 feet; thence South 136.00 feet to the South line of said Block; thence West 80.00 feet to the place of beginning.

Surveyed for: Paige Anderson

Survey address: 2838 School Street

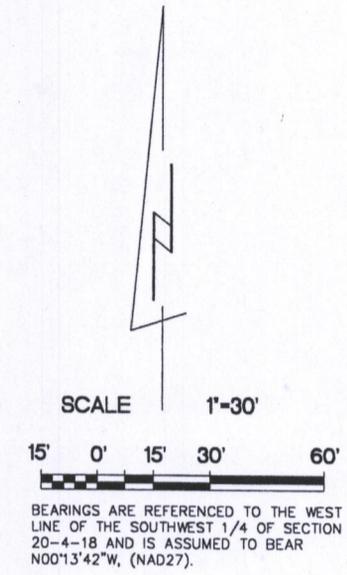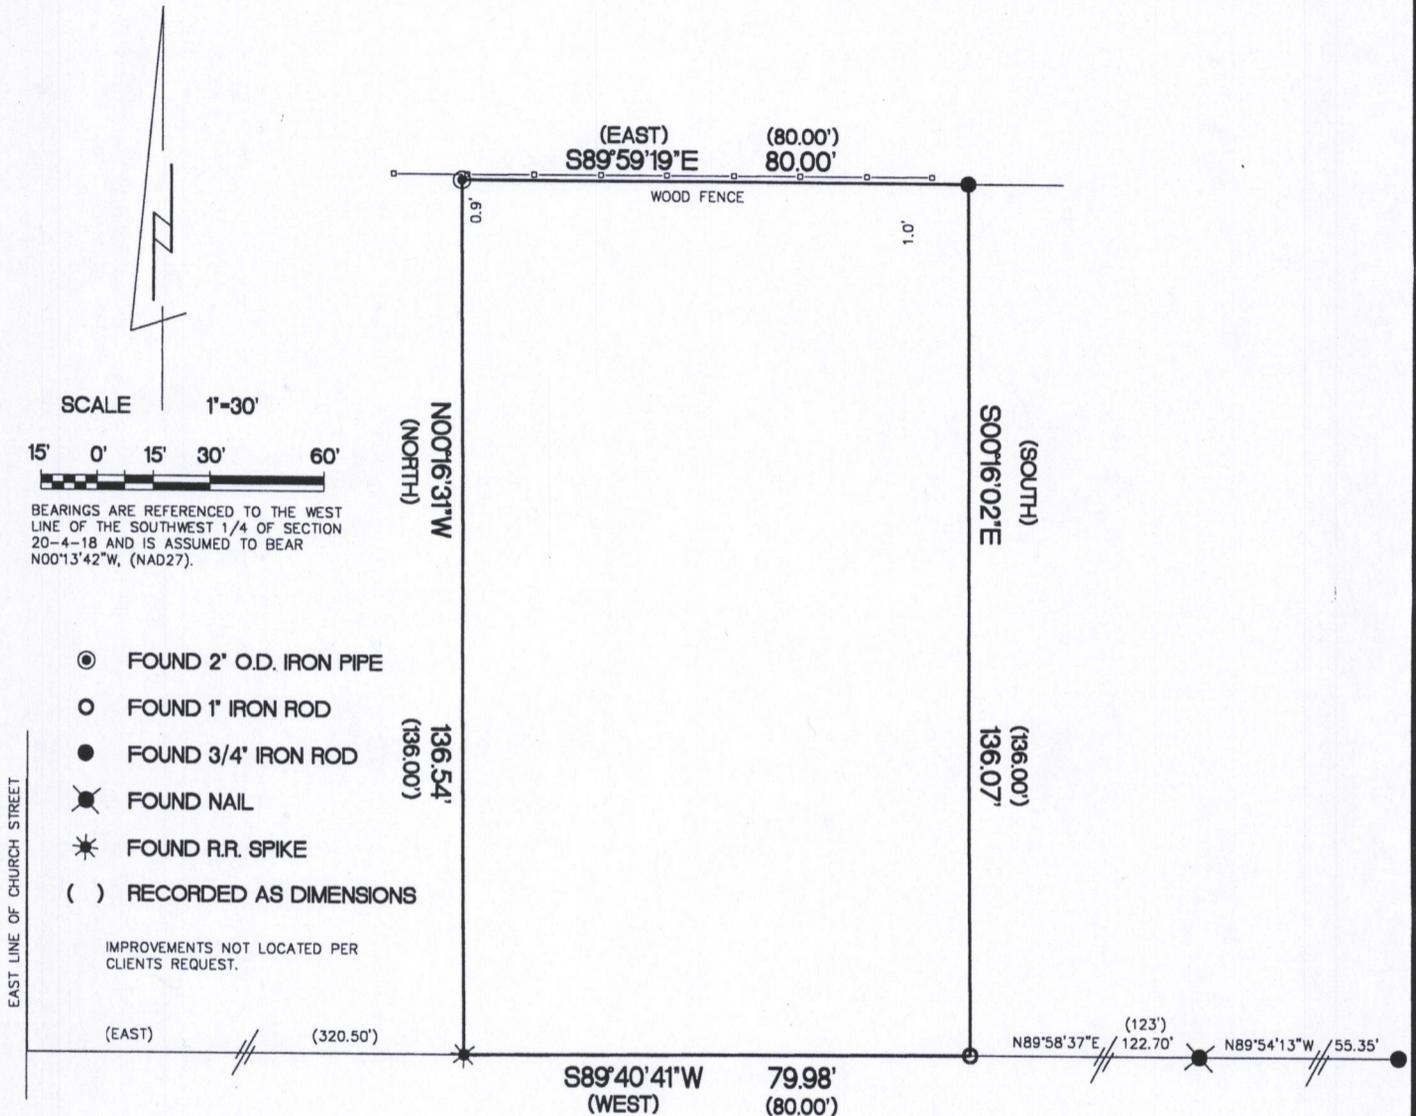

- ⊙ FOUND 2" O.D. IRON PIPE
- FOUND 1" IRON ROD
- FOUND 3/4" IRON ROD
- ✕ FOUND NAIL
- ✱ FOUND R.R. SPIKE
- () RECORDED AS DIMENSIONS

IMPROVEMENTS NOT LOCATED PER CLIENTS REQUEST.

RECEIVED
 JAN 14 2019
 By *Jan*



"I hereby certify that I have surveyed the above described property and that the above map is a true representation thereof and shows the size and location of the property, its exterior boundaries, the location of all visible structures and dimensions of all principal buildings thereon, boundary fences, apparent easements, roadways and encroachments if any"

"This survey is made for the use of the present owners of the property, and also those who purchase, mortgage or guarantee the title thereto within one year from date hereof."

KETTLE MORAINES SURVEYING INC.
 575 W36245 Wilton Road
 Eagle Wisconsin 53119
 P.O. Box 357
 (262) 594-3484
 kettlemorainesurveying.com
 Terrance E. Pisarek P.L.S.

THIS IS NOT AN ORIGINAL SURVEY UNLESS THE SEAL IS RED.

9/20/18	TEP	TEP	18115
DATE	FIELD WORK BY	DRAWN BY	JOB NUMBER

ROP-3 003 - 1101