


PLAT OF SURVEY -OF-

LOT 122, STERLING OAKS ADDITION NO. 1, BEING A PART OF THE NORTHWEST 1/4 AND SOUTHWEST 1/4 OF THE
NORTHEAST 1/4 AND A PART OF THE NORTHEAST 1/4 AND SOUTHEAST 1/4 OF THE NORTHWEST 1/4, ALL IN
SECTION 20, TOWN 4 NORTH, RANGE 18 EAST, VILLAGE OF EAST TROY, WALWORTH COUNTY, WISCONSIN.


SURVEY FOR: KATIE PARCHIM
SURVEY ADDRESS: 2552 ST. PETERS ROAD

ST. PETERS ROAD

BEARINGS HEREON RELATE TO THE
WEST LINE OF LOT 122 OF STERLING
OAKS ADDITION NO. 1, ASSUMED
BEARING NORTH 00°10'17" WEST.

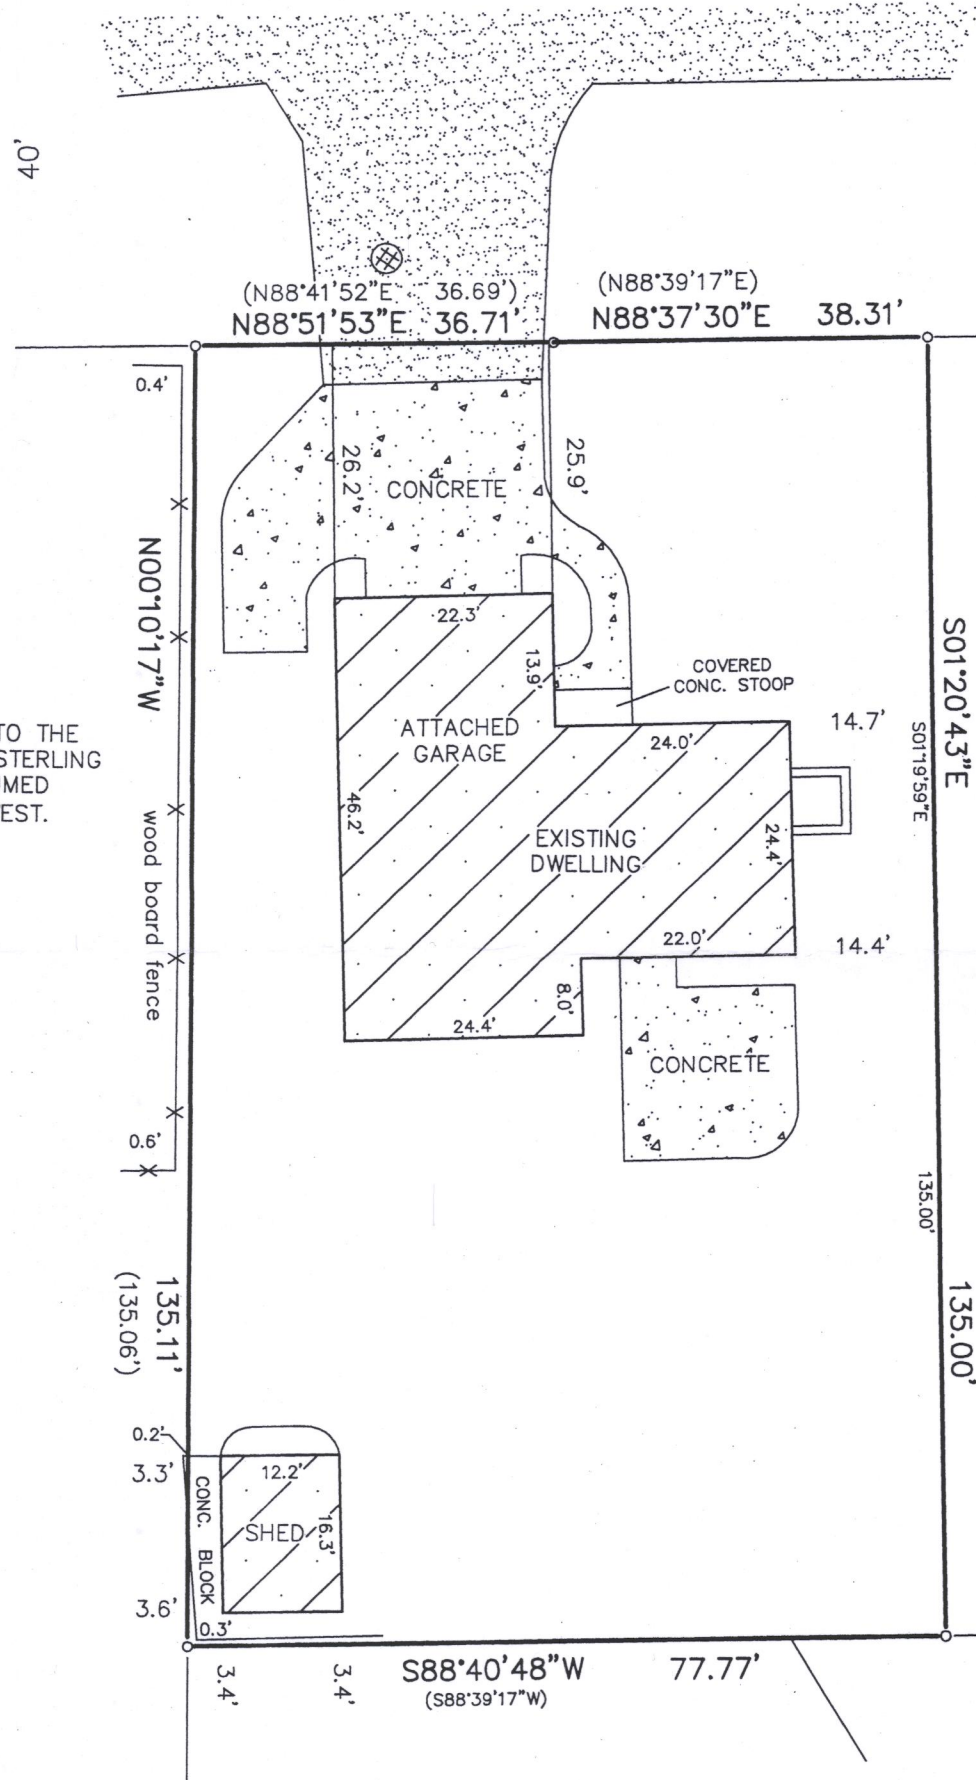

SCALE 1" = 20'
GRAPHIC SCALE


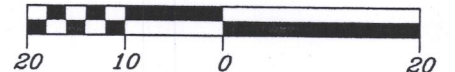


LEGEND


- FOUND IRON PIPE
- SET IRON PIPE

"I hereby certify that I have surveyed the above described property and that the above map is a correct representation thereof and shows the size and location of the property, its exterior boundaries, the location of all visible structures and dimensions of all principal buildings thereon, boundary fences, apparent easements, roadways and encroachments, if any."

"This survey is made for the use of the present owners of the property, and those who purchase, mortgage, or guarantee the title thereto within one year from date hereof."

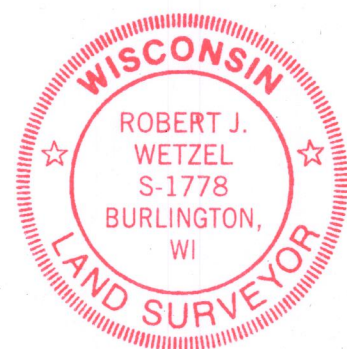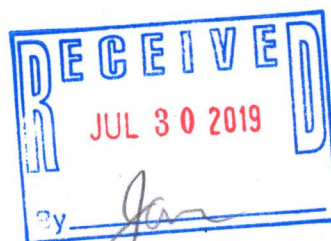

THIS IS NOT AN ORIGINAL PRINT
UNLESS THIS SEAL IS RED.

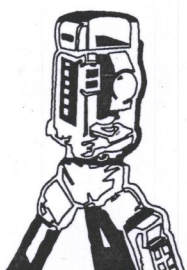

B.W. SURVEYING, INC.

LAND SURVEYS
MAPPING AND PLANNING
412 N. PINE STREET
BURLINGTON, WI 53105
(262)-767-0225

ROBERT J. WETZEL S-1778

MARCH 13, 2019
DATE

9822
JOB NUMBER

R8T01-52

003-1105