


FILE NAME: 2018-159 SAM CLEMENS 2106 WEST ST EAST TROY SURVEY.DGN

PLAT OF SURVEY

LOT 9 AND THE NORTHERLY 30 FEET OF LOTS 10 AND 11, BLOCK A, IN LENCK'S PARK ADDITION, BEING PORTIONS OF THE NORTHEAST 1/4 OF SECTION 30, TOWNSHIP 4 NORTH, RANGE 18 EAST AND SOUTHEAST 1/4 OF SECTION 19, IN TOWNSHIP 4 NORTH, RANGE 18 EAST, IN THE VILLAGE OF EAST TROY, WALWORTH COUNTY, WISCONSIN.

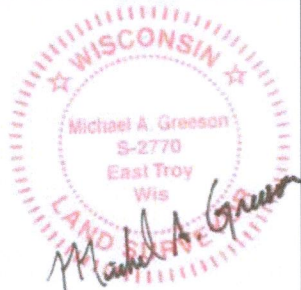


THIS SURVEY IS MADE FOR THE USE OF THE PRESENT OWNERS OF THE PROPERTY, AND ALSO THOSE WHO PURCHASE, MORTGAGE OR GUARANTEE TITLE TO WITHIN ONE (1) YEAR FROM DATE HERETO.

I, MICHAEL A. GREESON P.L.S. #2770, HEREBY CERTIFY THAT THIS SURVEY WAS MADE IN ACCORDANCE WITH THE MINIMUM STANDARDS FOR PROPERTY SURVEYS (CHAPTER A-E 7) FOR THE STATE OF WISCONSIN AND HAS BEEN PREPARED UNDER MY DIRECTION AND CONTROL AND IS CORRECT TO THE BEST OF MY KNOWLEDGE AND BELIEF.

SURVEY MADE FOR:
Sam Clemens
570 High Knob Dr.
Wheaton, IL 60189

DATE	ITEM
10/11/2018	ORIGINAL SURVEY


V²G
SURVEYING, LLC
123 WOLF RUN - SUITE 4
MUKWONAGO, WI 53149
(262) 378-5097

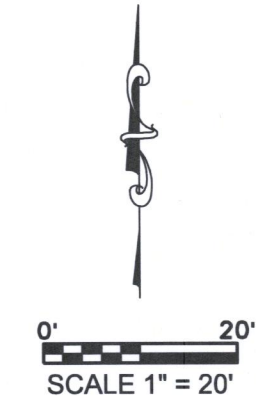

LEGEND:

- (100.00') RECORDED DISTANCE
- 100.00' MEASURED DISTANCE
- 1" FOUND IRON PIPE, UNLESS NOTED
- ⊘ 3/4" x 18" REBAR SET, 1.50 lbs./L.F.
- (M) MANHOLE
- ⊠ WATER VALVE
- (P) POWER POLE
- (T) TELEPHONE PEDESTAL

WEST STREET
66' PUBLIC RIGHT OF WAY

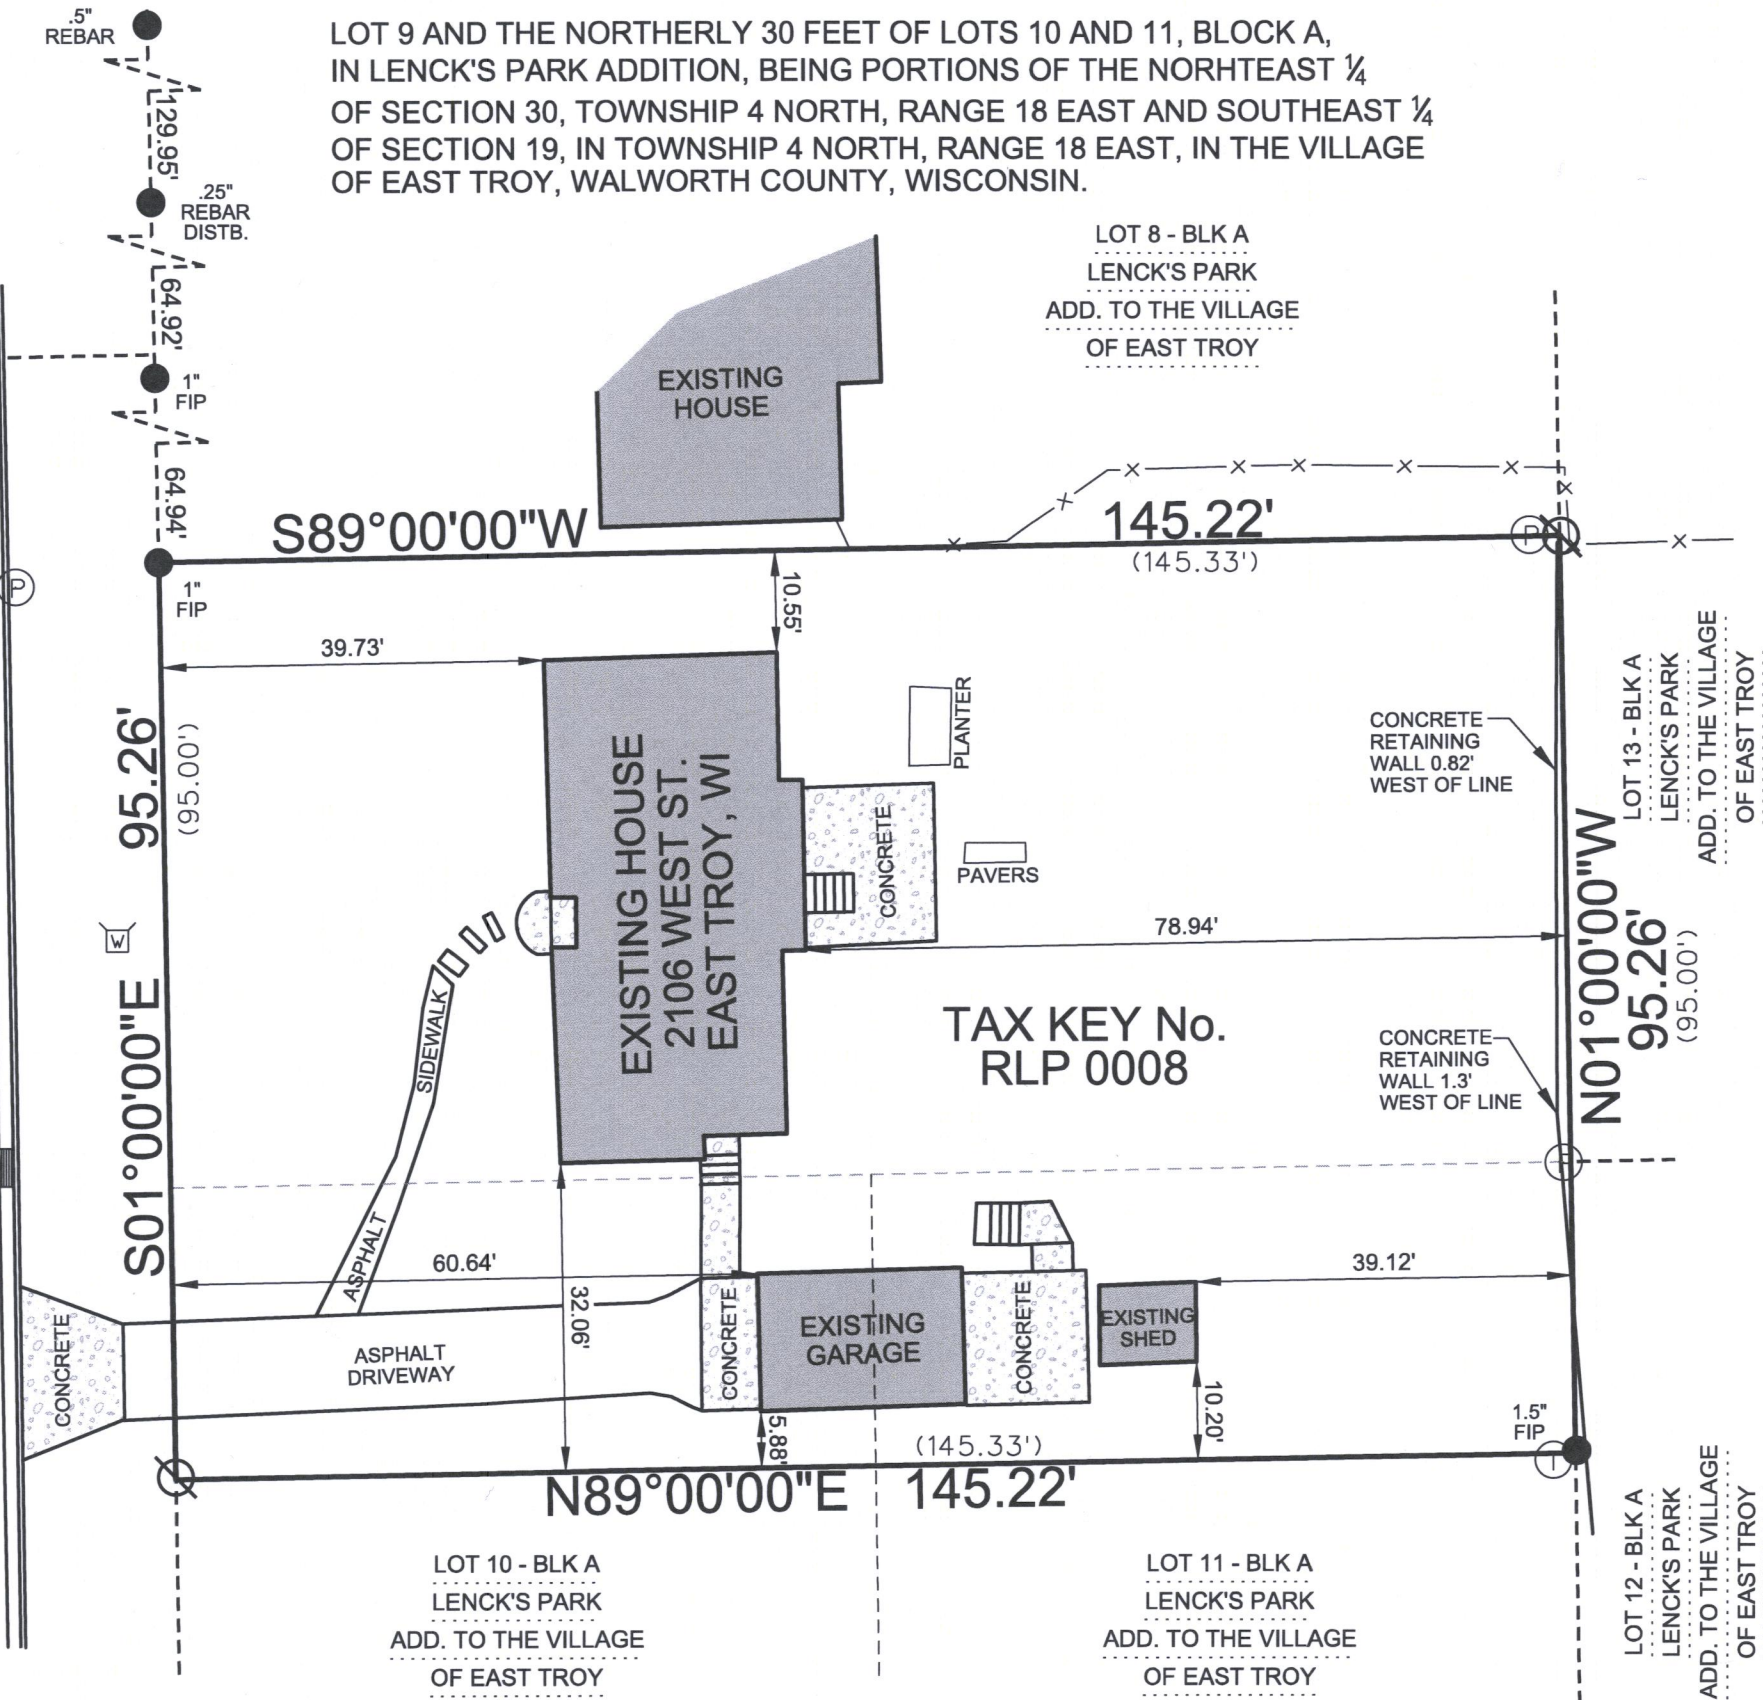

RLP-8 003-1110