


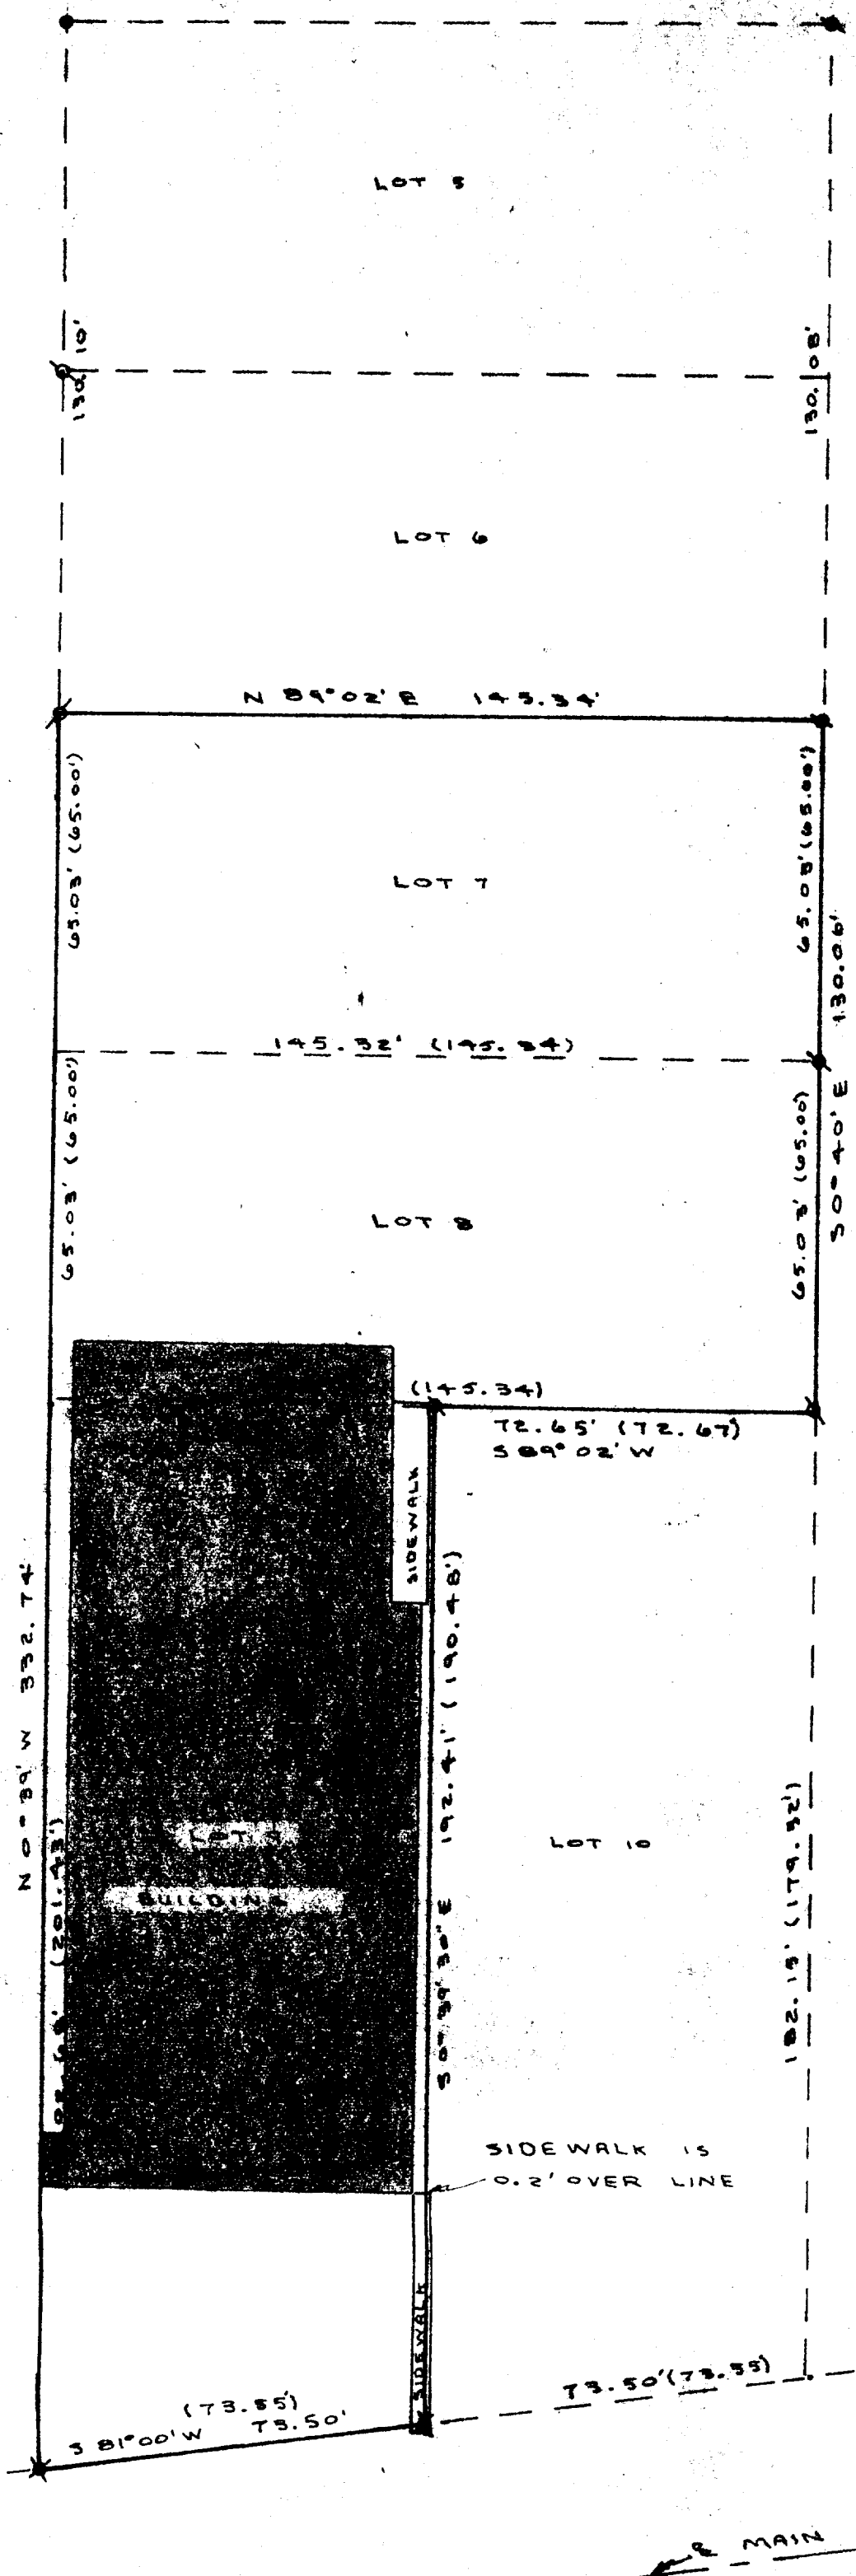

THE NORTHERLY LINE OF MAIN STREET WAS ASSUMED 381°00'W AS PREVIOUSLY PLATTED

THE LAND SHOWN HEREON HAS BEEN SURVEYED UNDER MY DIRECTION AND THIS PLAT OF SURVEY IS A TRUE AND ACCURATE REPRESENTATION OF THE LOT LINES TO THE BEST OF MY KNOWLEDGE AND BELIEF


DATED THIS 20th DAY OF August 1976

Lloyd L. Jensen
 LLOYD L. JENSEN
 REGISTERED LAND SURVEYOR NO. 5-211

LEGEND

- CONCRETE MON. FOUND
- IRON PIPE FOUND 2" O.D.
- ✱ IRON ROD FOUND 3/4" DI.
- ✱ IRON ROD SET 3/4" DI. X 24" LONG
- ✱ CHISELED CROSS IN SIDEWALK
- ✱ PR NAIL SET
- IRON PIPE FOUND 1" DI.

SCALE 1" = 30'

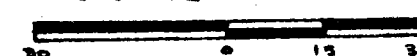

SURVEYED FOR C-MACK BUILDING INC.

PLAT OF SURVEY OF

LOTS 7, 8, AND 9, BLOCK B, LENCK'S PARK
 ADDITION TO THE VILLAGE OF EAST TROY
 LOCATED IN THE NORTH EAST 1/4 OF SECTION
 30, TOWN 4 NORTH, RANGE 18 EAST, WALWORTH
 COUNTY, WISCONSIN

Lloyd L. Jensen
 LLOYD L. JENSEN
 REGISTERED LAND SURVEYOR

SCALE 1" = 30'

DATE Aug 20, 1976