


FILE NAME: 2021-084 1944 CENTER STREET EAST TROY WENZEL SURVEY.DGN

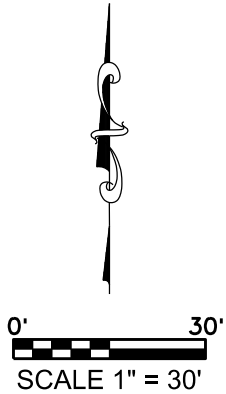


PLAT OF SURVEY

LOT 11, BLOCK 2 NORTH VIEW ADDITION TO THE
VILLAGE OF EAST TROY, WALWORTH COUNTY, WISCONSIN.

LEGEND:

- (100.00') RECORDED DISTANCE
- 100.00' MEASURED DISTANCE
- 1" FOUND IRON PIPE, UNLESS NOTED
- ⊗ ¾" x 18" IRON PIPE SET, 1.13 lbs./L.F.
- ⚠ WELL
- Ⓢ SEPTIC TANK
- Ⓢ SEPTIC VENT
- ⊗ LIGHT POLE
- Ⓛ ELECTRIC TRANSFORMER
- Ⓢ ELECTRIC PEDESTAL
- Ⓛ TELEPHONE PEDESTAL
- Ⓢ CABLE TV PEDESTAL

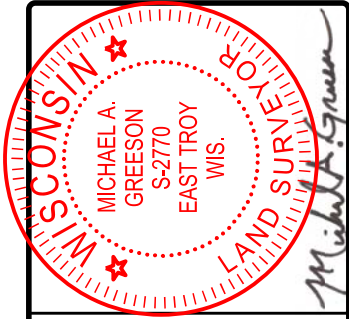

THIS SURVEY IS MADE FOR THE USE OF THE PRESENT OWNERS OF THE PROPERTY, AND ALSO THOSE WHO PURCHASE, MORTGAGE OR GUARANTEE TITLE TO WITHIN ONE (1) YEAR FROM DATE HERETO.

I, MICHAEL A. GREESON P.L.S. #2770, HEREBY CERTIFY THAT THIS SURVEY WAS MADE IN ACCORDANCE WITH THE MINIMUM STANDARDS FOR PROPERTY SURVEYS (CHAPTER A-E 7) FOR THE STATE OF WISCONSIN AND HAS BEEN PREPARED UNDER MY DIRECTION AND CONTROL AND IS CORRECT TO THE BEST OF MY KNOWLEDGE AND BELIEF.

SURVEY MADE FOR:
KELLY THOME
1944 CENTER ST.
EAST TROY, WI 53120

DATE	ITEM
05/12/2021	ORIGINAL SURVEY

