
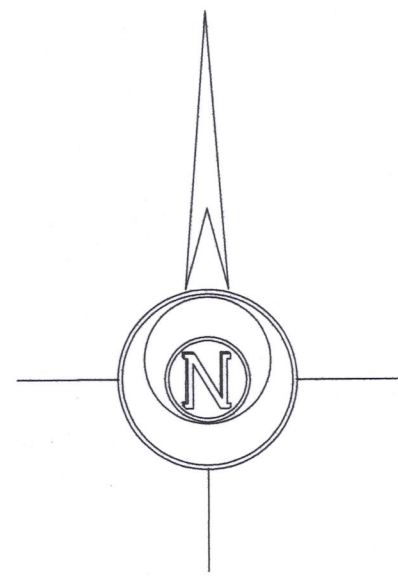


PLAT OF SURVEY
PLOT & GRADING PLAN

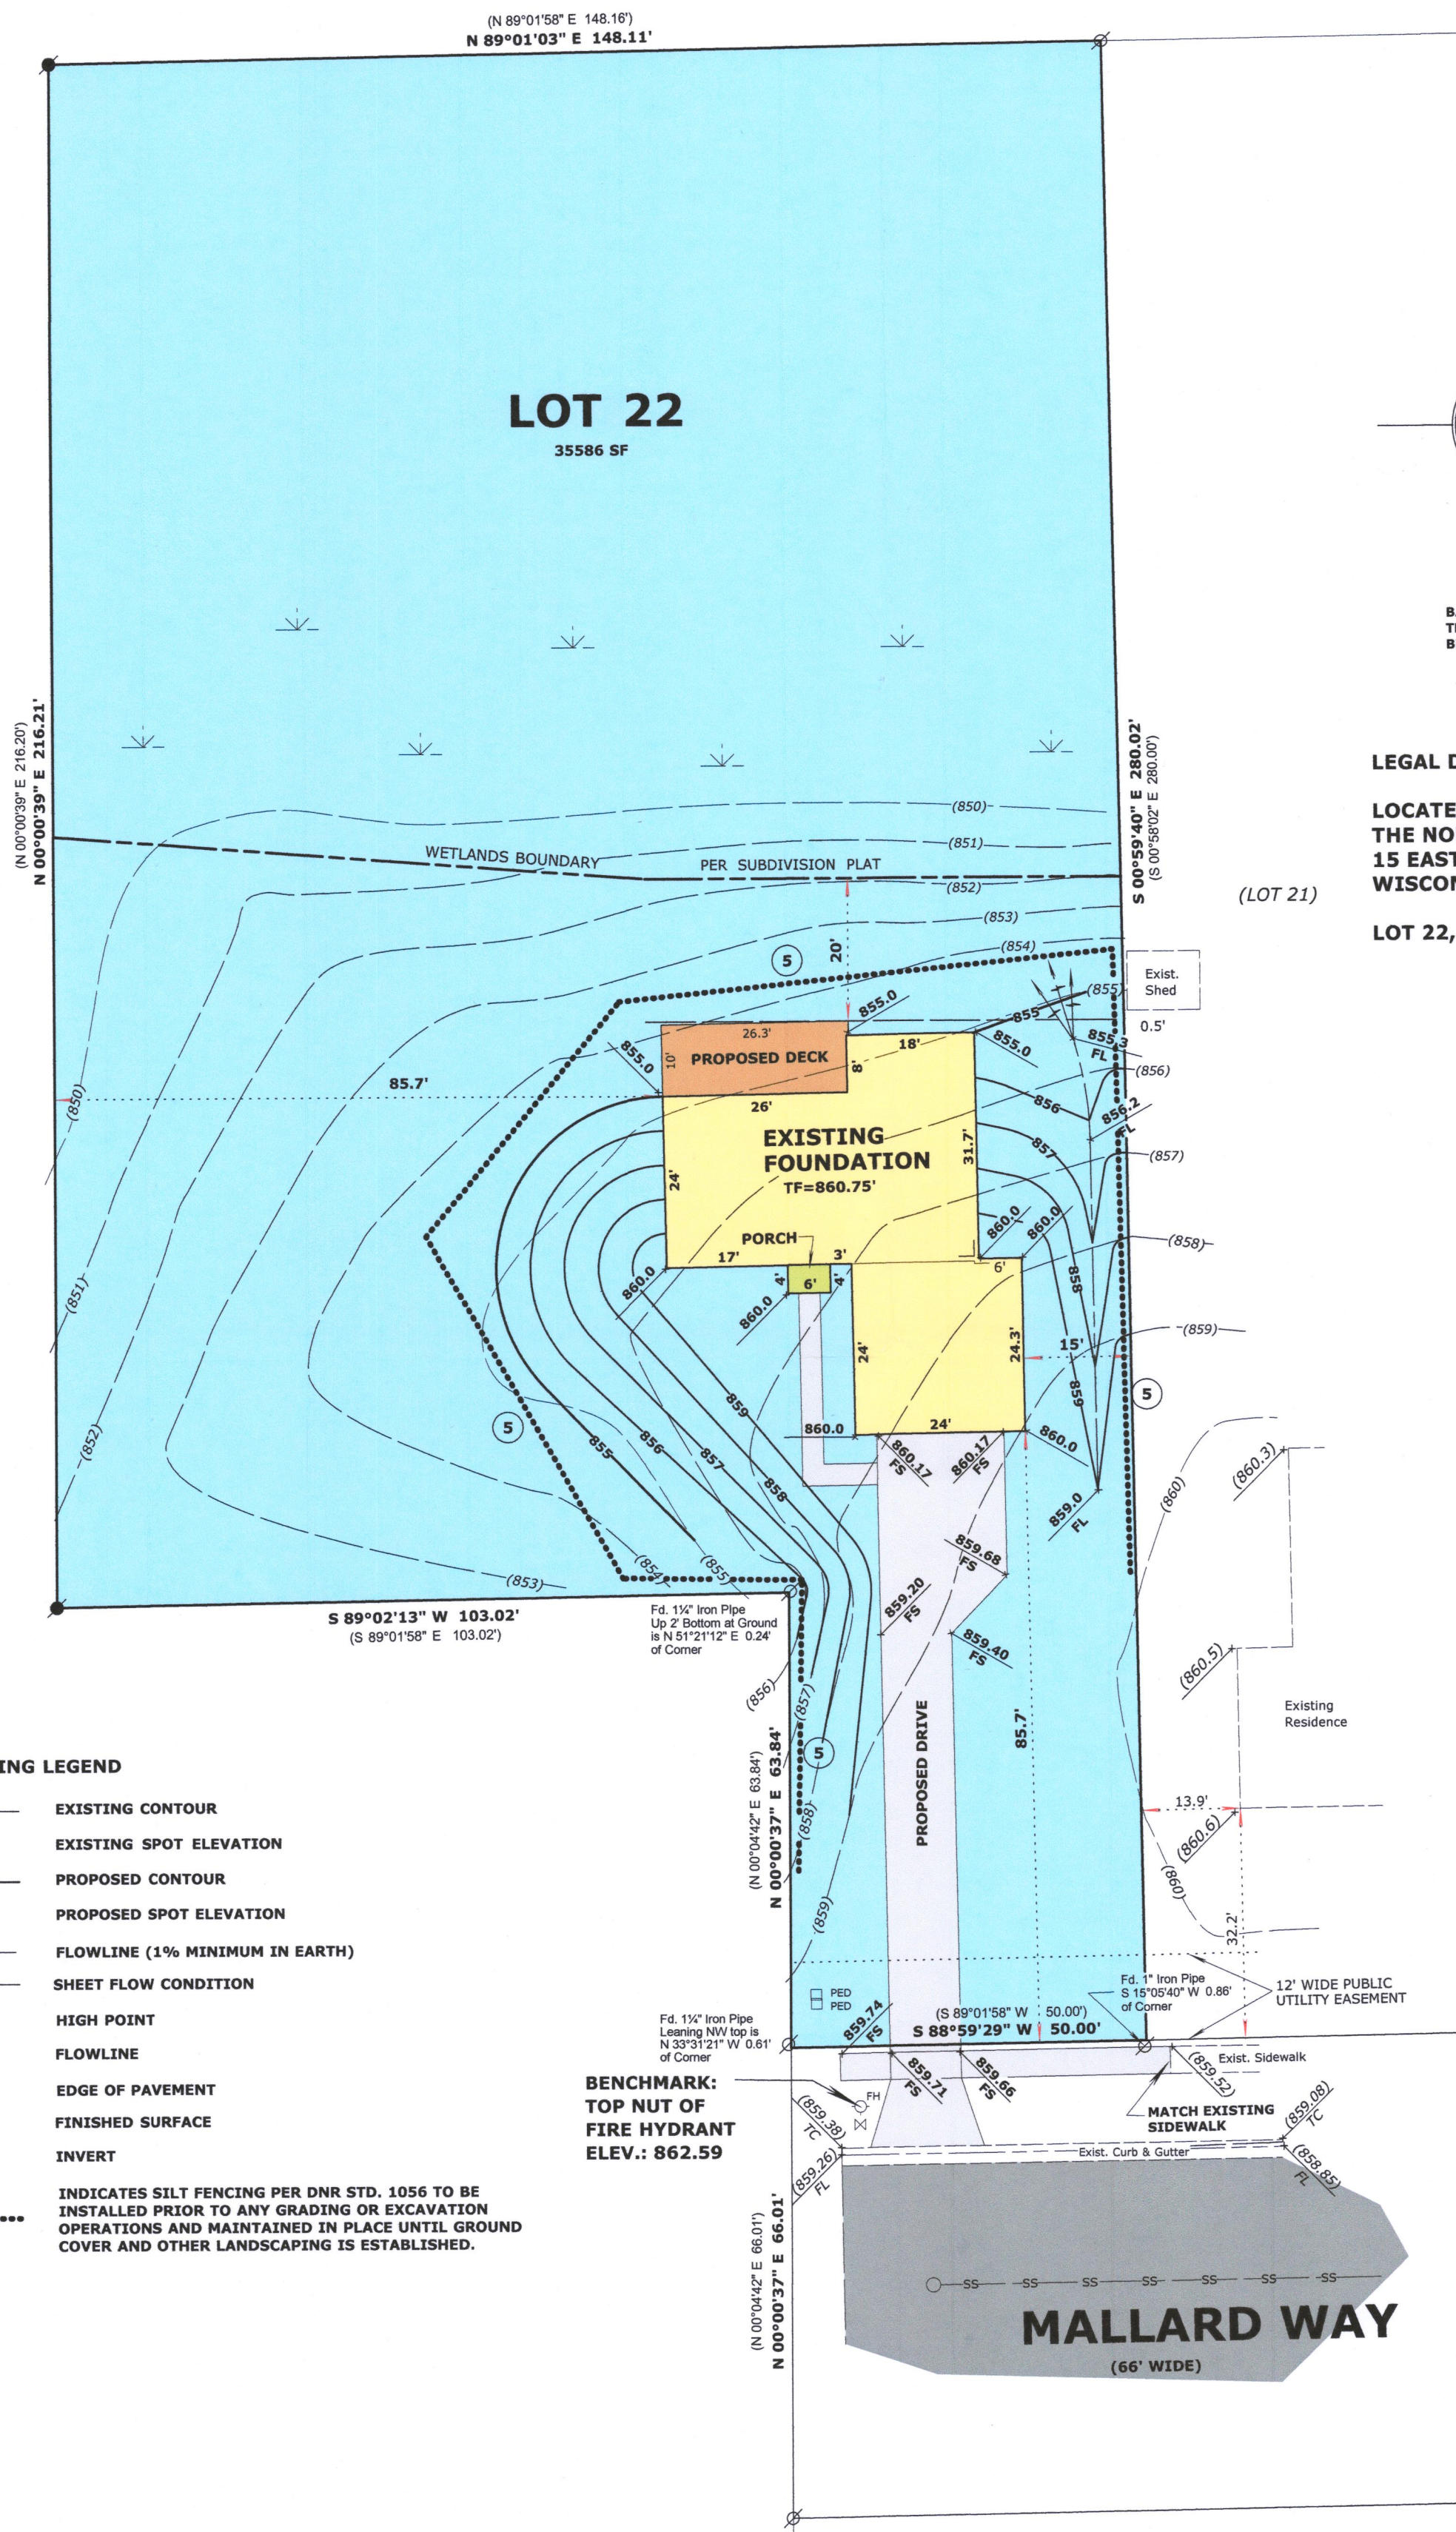

BASIS OF BEARINGS:
THE WEST LINE OF LOT 22
BEING N 0°00'39" E

LEGAL DESCRIPTION

LOCATED IN THE SOUTHWEST 1/4 AND THE SOUTHEAST 1/4 OF
THE NORTHEAST 1/4, SECTION 30, TOWNSHIP 4 NORTH, RANGE
15 EAST, IN THE VILLAGE OF EAST TROY, WALWORTH COUNTY,
WISCONSIN

LOT 22, BROOKSTONE HILLS-PHASE 1

RECEIVED
APR 01 2022
By *smf*



REVISED MARCH 8, 2022
TO SHOW FOUNDATION
"AS BUILT"

SCALE: 1 INCH = 20 FEET

"I hereby certify that the above described property has
been surveyed by me or under my direction and that the
above map is a true representation thereof and shows the
size and location of the property, its exterior boundaries,
the location of all visible structures and dimensions of all
principal buildings thereon, boundary fences, apparent
easements, roadways and visible encroachments, if any."
"This survey is made for the use of the present owners of
the property, and also those who purchase, mortgage, or
guarantee the title thereto within one year from date
hereof."

Mark L. Miritz
MARK L. MIRITZ
WISCONSIN PROFESSIONAL
LAND SURVEYOR S-2582