

*File with Survey*


# Plat of Survey

Known as Thomas Drive, in the Village of East Troy, Wisconsin  
Lot 51 in LYNNDALE, being a Subdivision of a part of the SE 1/4, NW 1/4 and the SW 1/4 of  
the NW 1/4 of Section 20, T 4 N, R 18 E, in the Village of East Troy, Walworth County,  
Wisconsin

JULY 2, 1976

GREGORY A RUBIN-OWNER

SURVEY NO. 138662-M

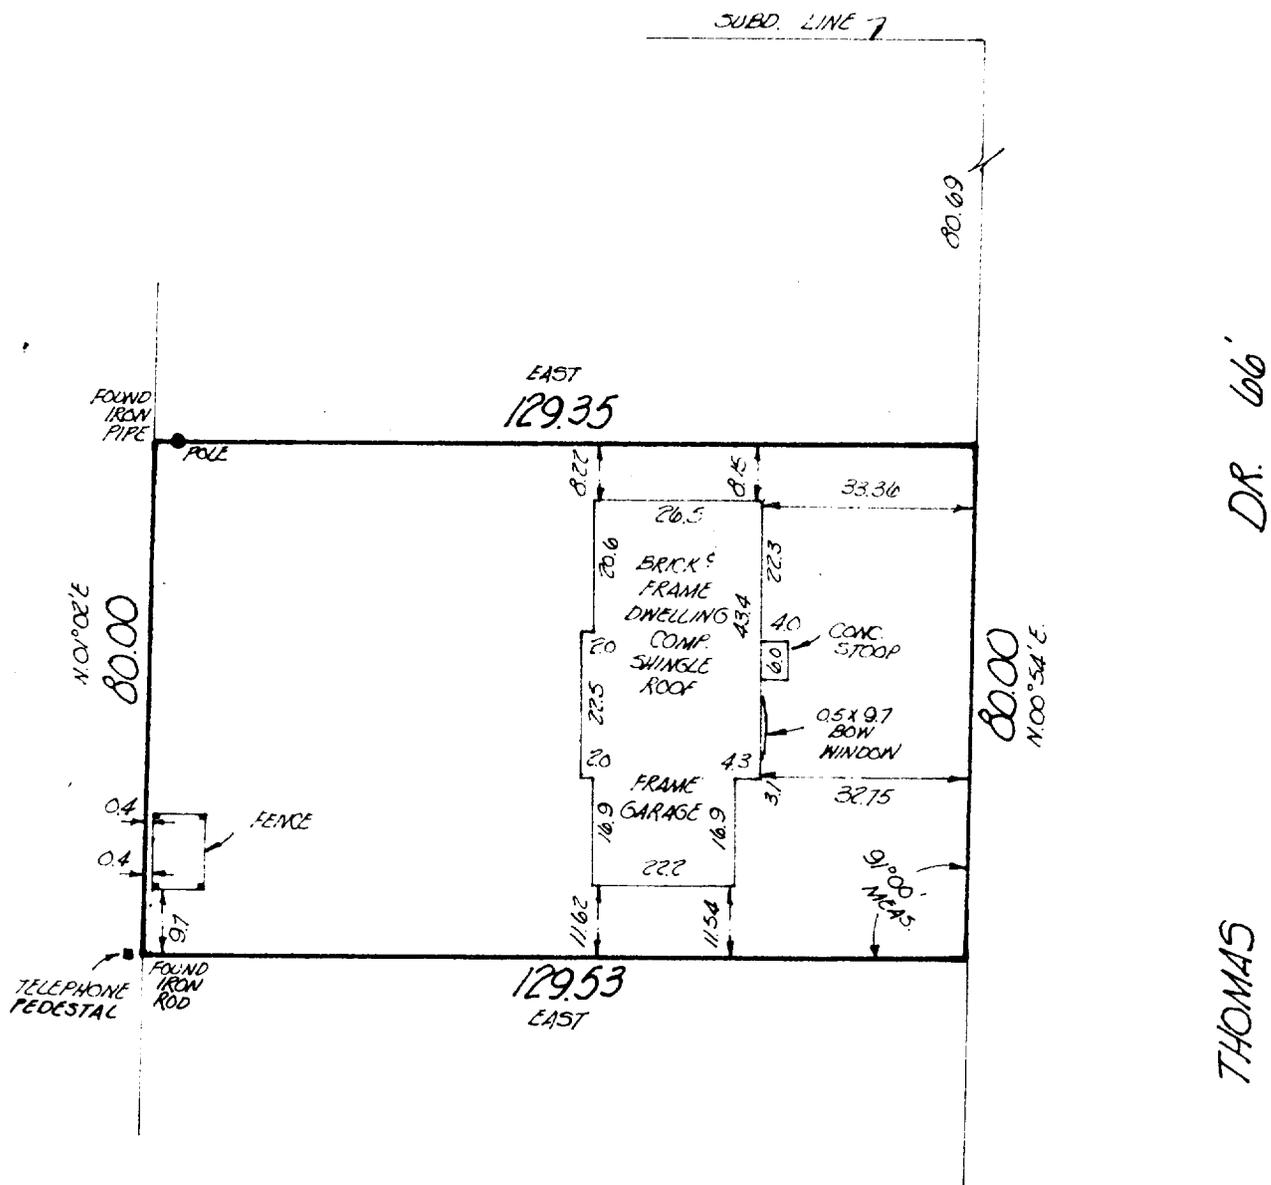

*DR. 606'*  
*THOMAS*

SCALE 1" = 30'

I Certify that I have surveyed the above described property (Property), and the above map is a true representation thereof and shows the size and location of the Property, its exterior boundaries, the location and dimensions of all visible structures thereon, fences, apparent easements and roadways and visible encroachments, if any.

This survey is made for the exclusive use of the present owners of the Property, and also those who purchase, mortgage, or guarantee the title thereto, within one (1) year from date hereof.

NATIONAL SURVEY SERVICE, INC.  
CIVIL ENGINEERS AND LAND SURVEYORS  
3470 NORTH 127th STREET (414) 781-1000  
P. O. BOX 444  
BROOKFIELD, WISCONSIN 53005

*Kenneth E Berke*  
SURVEYOR



3-114