



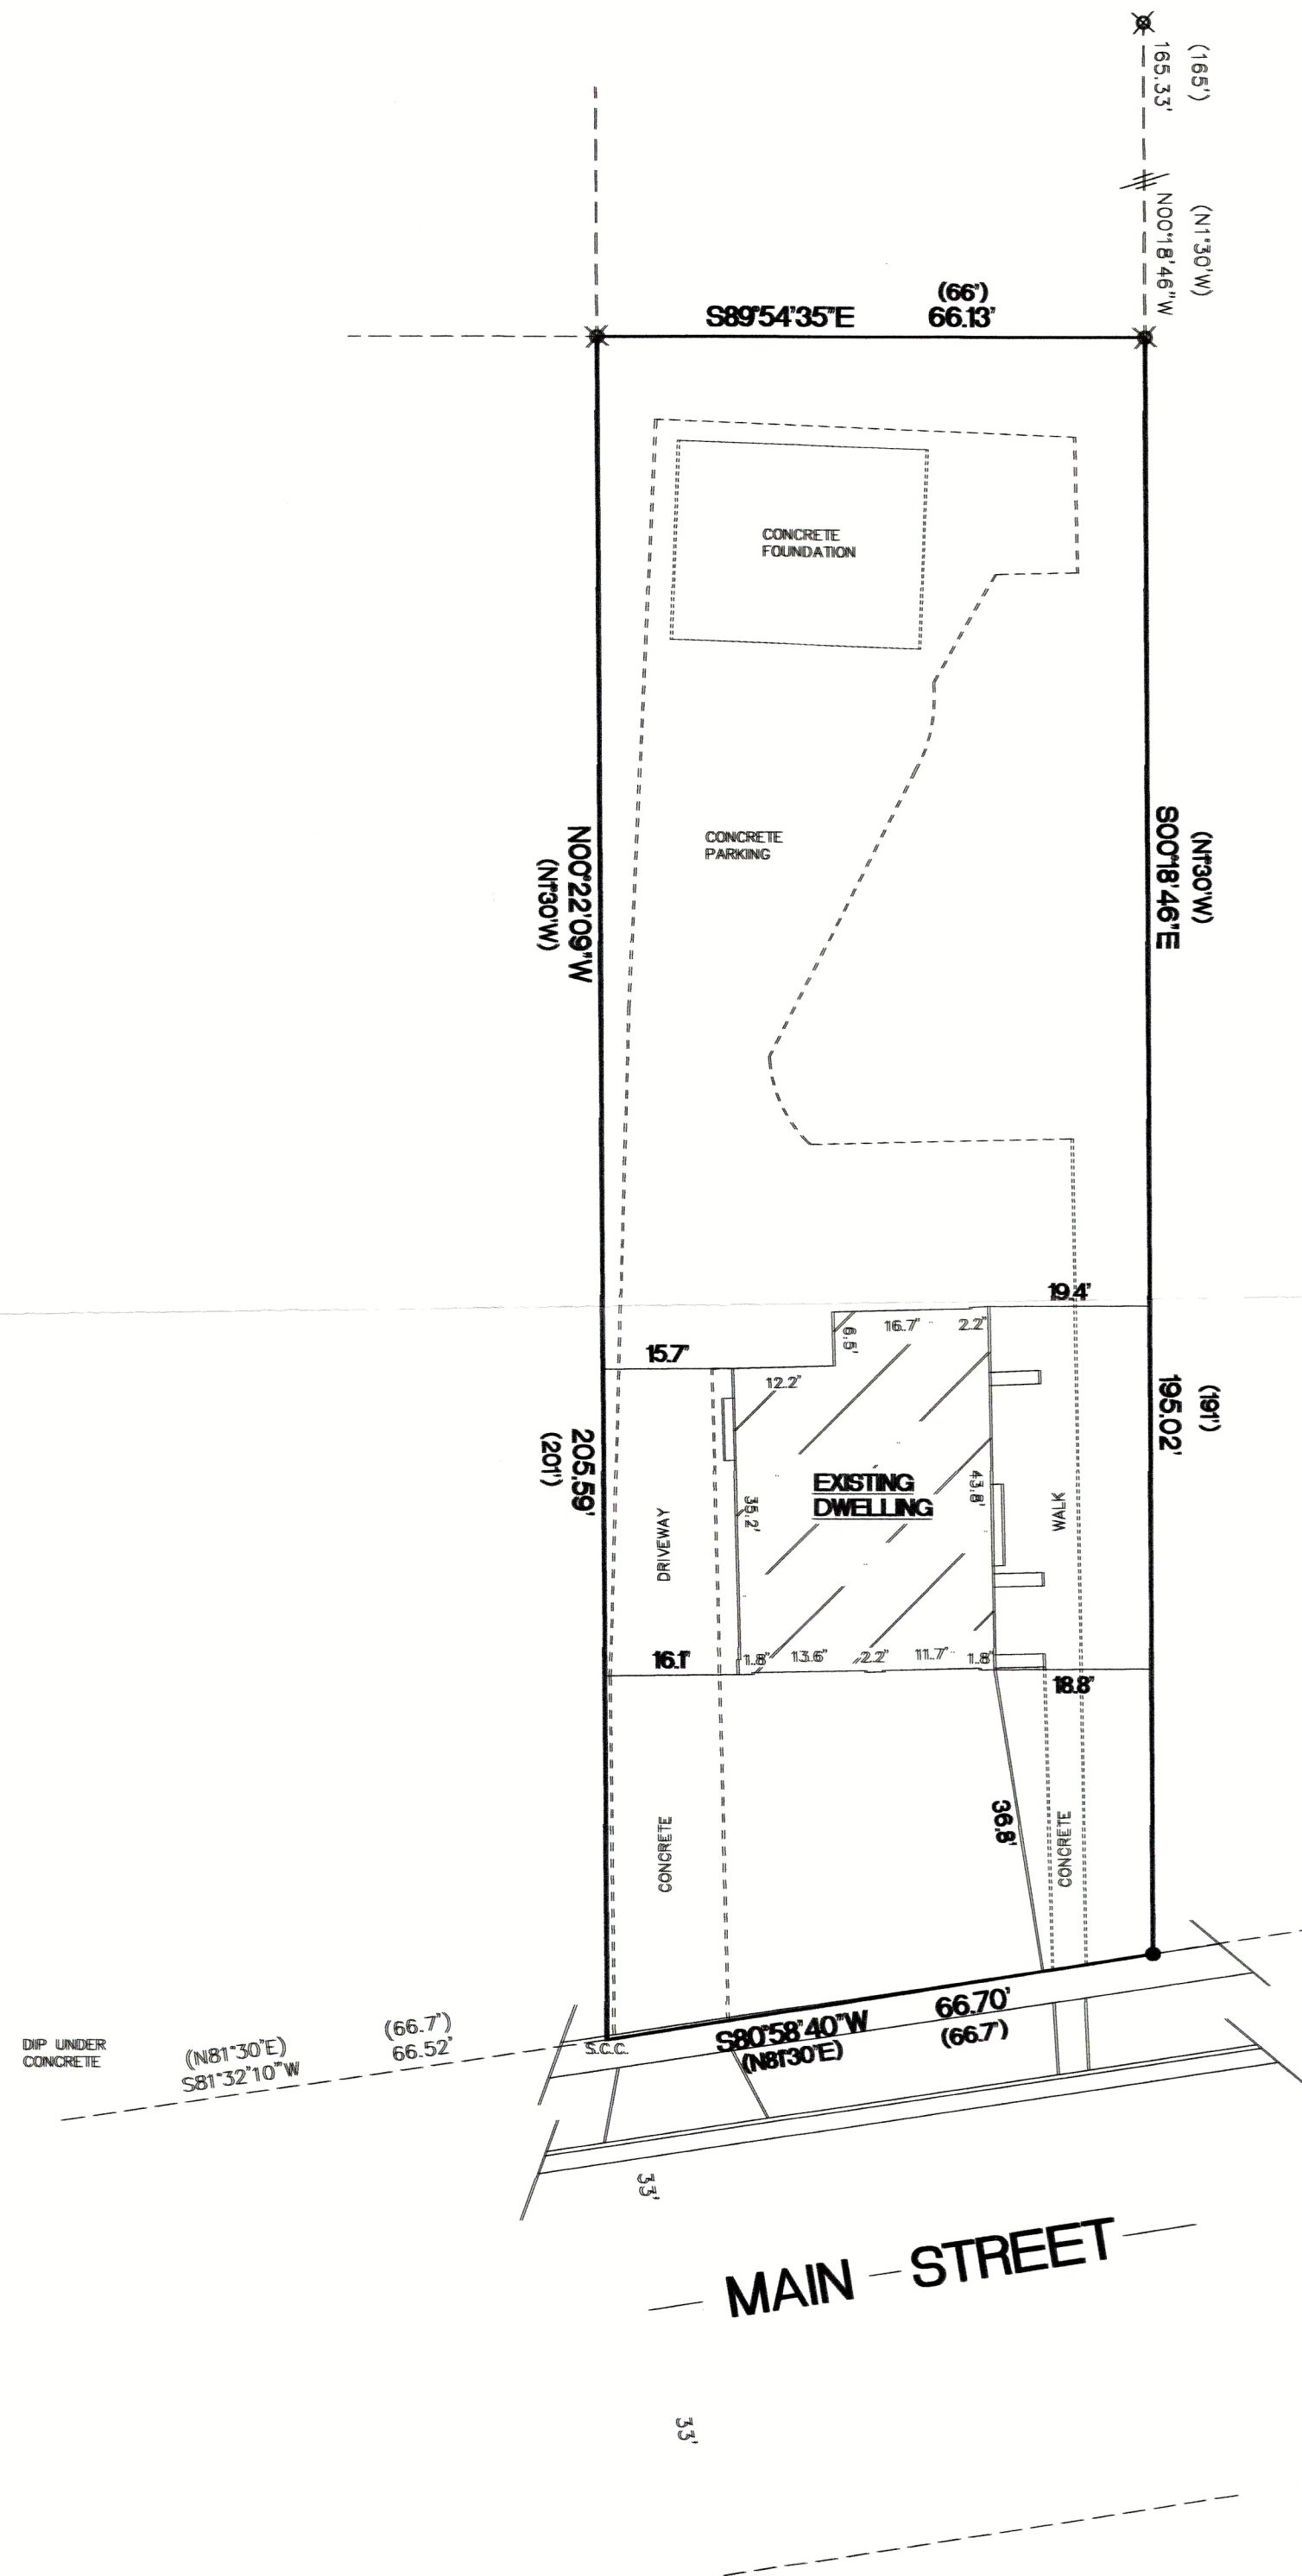

PLAT OF SURVEY

LOT 6, BLOCK 8, EXCEPTING THE NORTH 165 FEET, ORIGINAL PLAT OF THE VILLAGE OF EAST TROY
VILLAGE OF EAST TROY, WALWORTH COUNTY, WISCONSIN.

SURVEYED FOR: VICTOR STANFORD
SURVEY ADDRESS: 2954 MAIN STREET

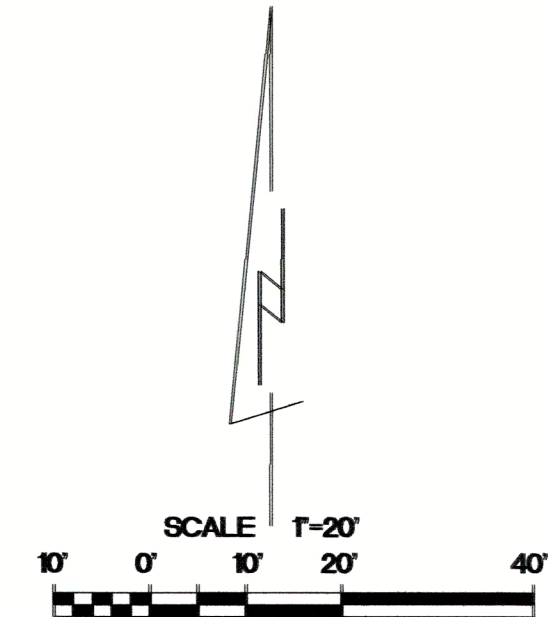

BEARINGS ARE REFERENCED TO THE SOUTH
LINE OF THE SOUTHEAST 1/4 OF SECTION
19-4-18 AND IS ASSUMED TO BEAR
N89°10'27"E, (NAD83).

13227 SQ. FT.

- FOUND 1 1/4" IRON PIPE
- ✕ FOUND 1/2" IRON PIN
- SET 1 1/4" O.D. IRON PIPE
- S.C.C. SET CHISELED CROSS
- () RECORDED AS DIMENSIONS

"I hereby certify that I have surveyed the above property
and that the above map is a true representation thereof
and shows the size and location of the property, its exterior
boundaries, the location of all visible structures and dimensions
of all principal buildings thereon, boundary fences, apparent
easements, roadways and encroachments if any."

"This survey is made for the use of the present owners of
the property, and also those who purchase, mortgage or
guarantee the title thereto within one year from date hereof."

Kettle Moraine Surveying Inc.
P.O. Box 357
Eagle WI 53119
(262)594-3484



THIS IS NOT AN ORIGINAL SURVEY UNLESS THE SEAL IS RED.

6/5/2024
DATE

TEP
FIELD WORK BY

TEP
DRAWN BY

24051
JOB NUMBER

RDP-84
003-1173