

W-1/8TH SECTION LN. SEC 30 TAN. R. 18 E.

O=INDICATES IRON PIPE

S. 82° 45' W. 110.00'

N. 00° 34' E. 180.31'

S. 00° 34' W. 180.31'

S. 82° 45' E. 110.00'

GARAGE

RESIDENCE

PORCH

PLACE OF BEGINNING

S.T. HWY # 15

DESCRIPTION: Commencing at the point of intersection of the Center line of S. T. Hwy. #15 and the N-S ¼ Section line of Section 30, T. 4 N., R. 18 E. Walworth County, Wisconsin; thence S. 82° 45' W. 1053.00 feet to the place of beginning of the lands hereinafter described: thence N. 00° 34' E. 180.31 feet, thence S. 82° 45' W. 110.00 feet, thence S. 00° 34' W. 180.31 feet to a point in the center line of said highway, thence N. 82° 45' E. 110.00 feet to the place of beginning.

CERTIFICATE: I, James F. Biagi, surveyor, do hereby certify that I have surveyed the property hereon described.

May 31, 1966.


James F. Biagi
JAMES F. BIAGI
MILWAUKEE, WIS.
SURVEYOR

DESCRIPTION: Commencing at the point of intersection of the Center line of S. T. Hwy. #15 and the N-S $\frac{1}{4}$ Section line of Section 30, T. 4 N., R. 18 E. Walworth County, Wisconsin; thence S. $82^{\circ} 45'$ W. 1053.00 feet to the place of beginning of the lands hereinafter described: thence N. $00^{\circ} 34'$ E. 180.31 feet, ~~thence~~ S. $82^{\circ} 45'$ W. 110.00 feet, thence S. $00^{\circ} 34'$ W. 180.31 feet to a point in the center line of said highway, thence N. $82^{\circ} 45'$ E. 110.00 feet to the place of beginning.

CERTIFICATE: I, James F. Biagi, surveyor, do hereby certify that I have surveyed the property hereon described.

May 31, 1966.

James F. Biagi R19 272

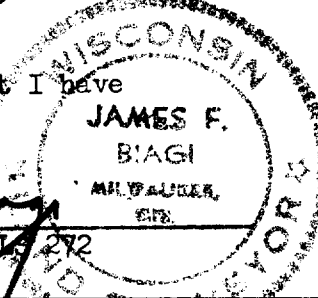

UP-107 (part of)