


Plat of Survey

Known as Graydon Avenue, in the Village of East Troy Wisconsin
 Lot 59 in TROYJEN'S SUBDIVISION, being a Subdivision of a part of the NW 1/4 and
 the SW 1/4 of the SW 1/4 of Section 19, T 4 N, R 18 E, in the Village of East
 Troy, Walworth County, Wisconsin

NOVEMBER 8, 1976

SURVEY NO. 139199-M

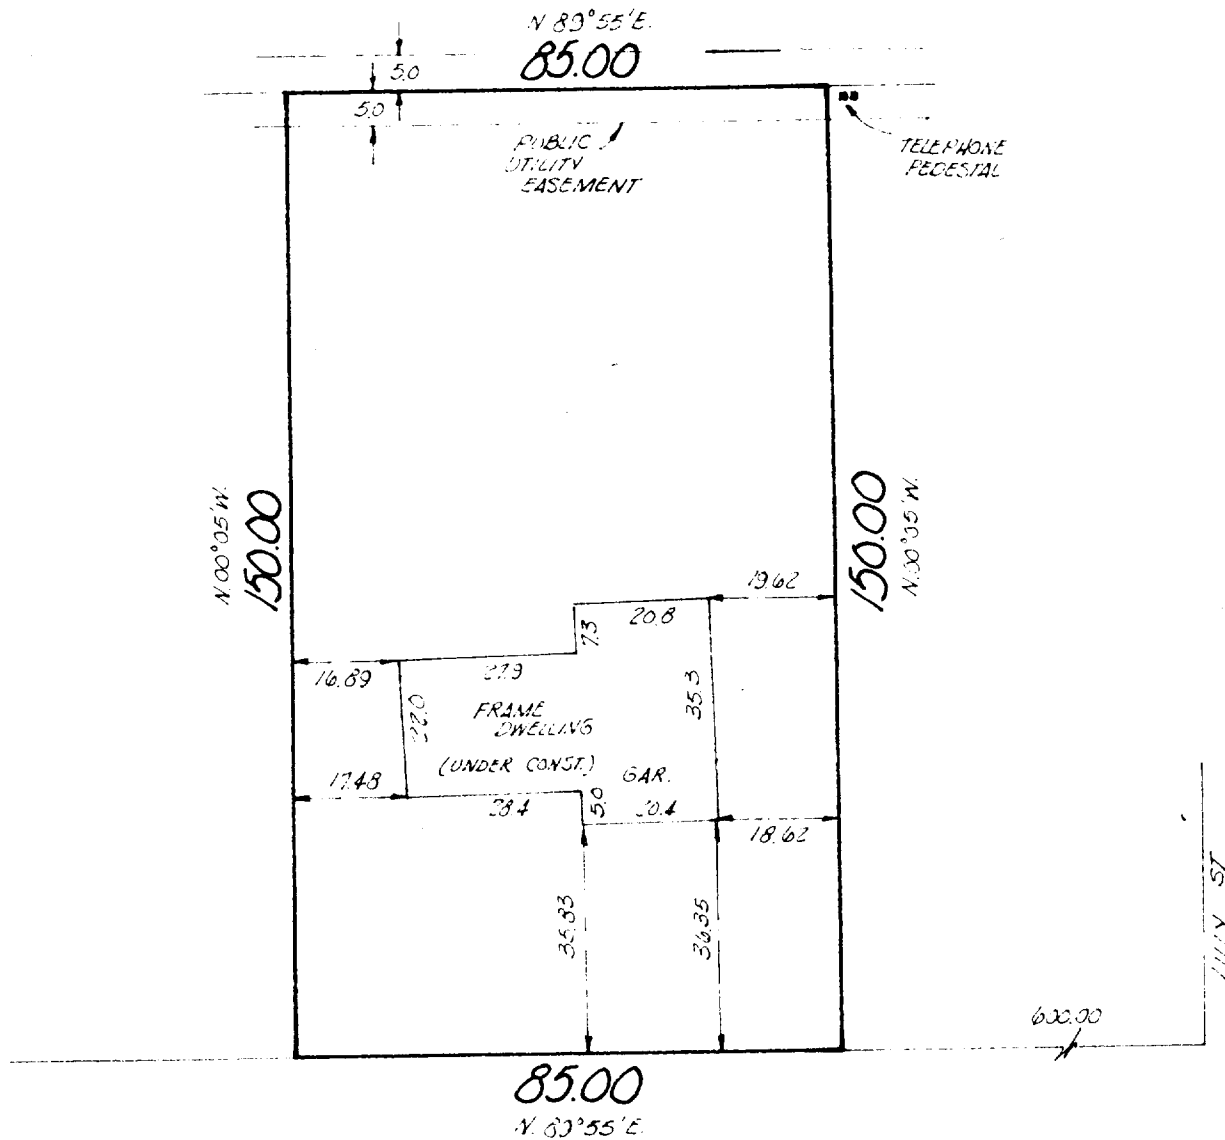

SCALE 1"=30'

GRAYDON

AVE. 66'

I Certify that I have surveyed the above described property (Property), and the above map is a true representation thereof and shows the size and location of the Property, its exterior boundaries, the location and dimensions of all visible structures thereon, fences, apparent easements and roadways and visible encroachments if any.

This survey is made for the exclusive use of the present owners of the Property, and also those who purchase, mortgage, or guarantee the title thereto, within one (1) year from date hereof.



NATIONAL SURVEY SERVICE, INC.
 CIVIL ENGINEERS AND LAND SURVEYORS
 3470 NORTH 127th STREET (414) 781 1000
 P. O. BOX 444
 BROOKFIELD WISCONSIN 53005

Kenneth E. Burke
 SURVEYOR



3-126