
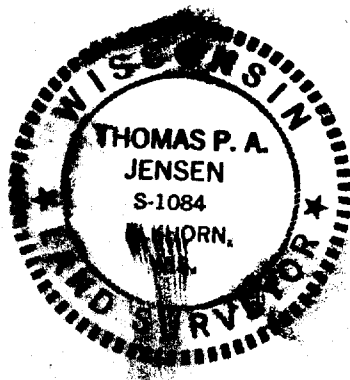
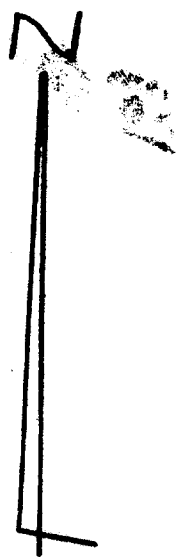


PLAT OF SURVEY

OF

HOUSE LOCATION IN LOT 58 LYNNDALE SUBDIVISION
ADDITION NUMBER ONE, LOCATED IN THE SW 1/4 OF
THE NW 1/4 OF SECTION 20, T4N R18E, VILLAGE OF EAST
TROY, WALWORTH COUNTY, WISCONSIN.

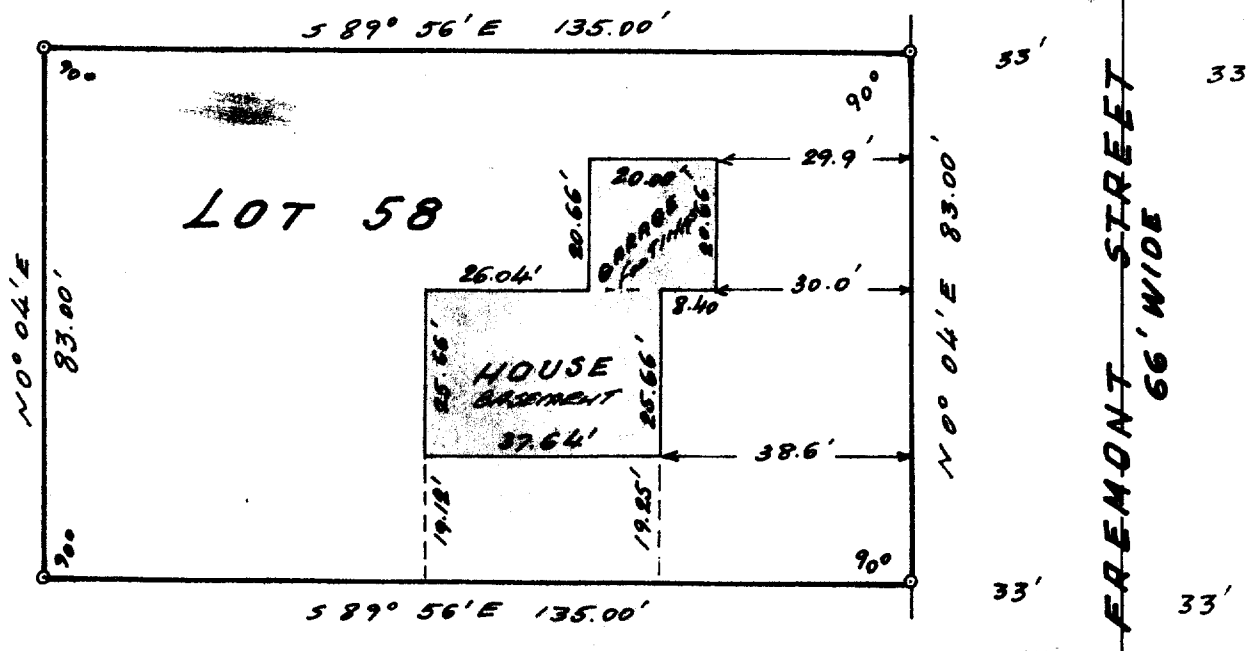

SURVEY AND PLAT BY
JENSEN & JOHNSON, INC.
CIVIL ENGINEERS AND SURVEYORS

Elkhorn, Wisconsin

LEGEND

- — Iron ~~Pipe~~ BAR FOUND
- — Concrete Monument

Scale 1" = 30'

SURVEYED FOR
C-MAC BUILDING
2113 CHURCH ST.
EAST TROY, WIS.

RLSA-6

WE CERTIFY: That we have surveyed the above described property and that the plat shown hereon is an accurate survey and a true representation thereof and correctly shows the exterior boundary lines and all divisions of said property.

Date JUNE 7, 1976

Thomas P. A. Jensen
THOMAS P. A. JENSEN

Wisconsin Registered Land Surveyor, No. S-1084

3-135